
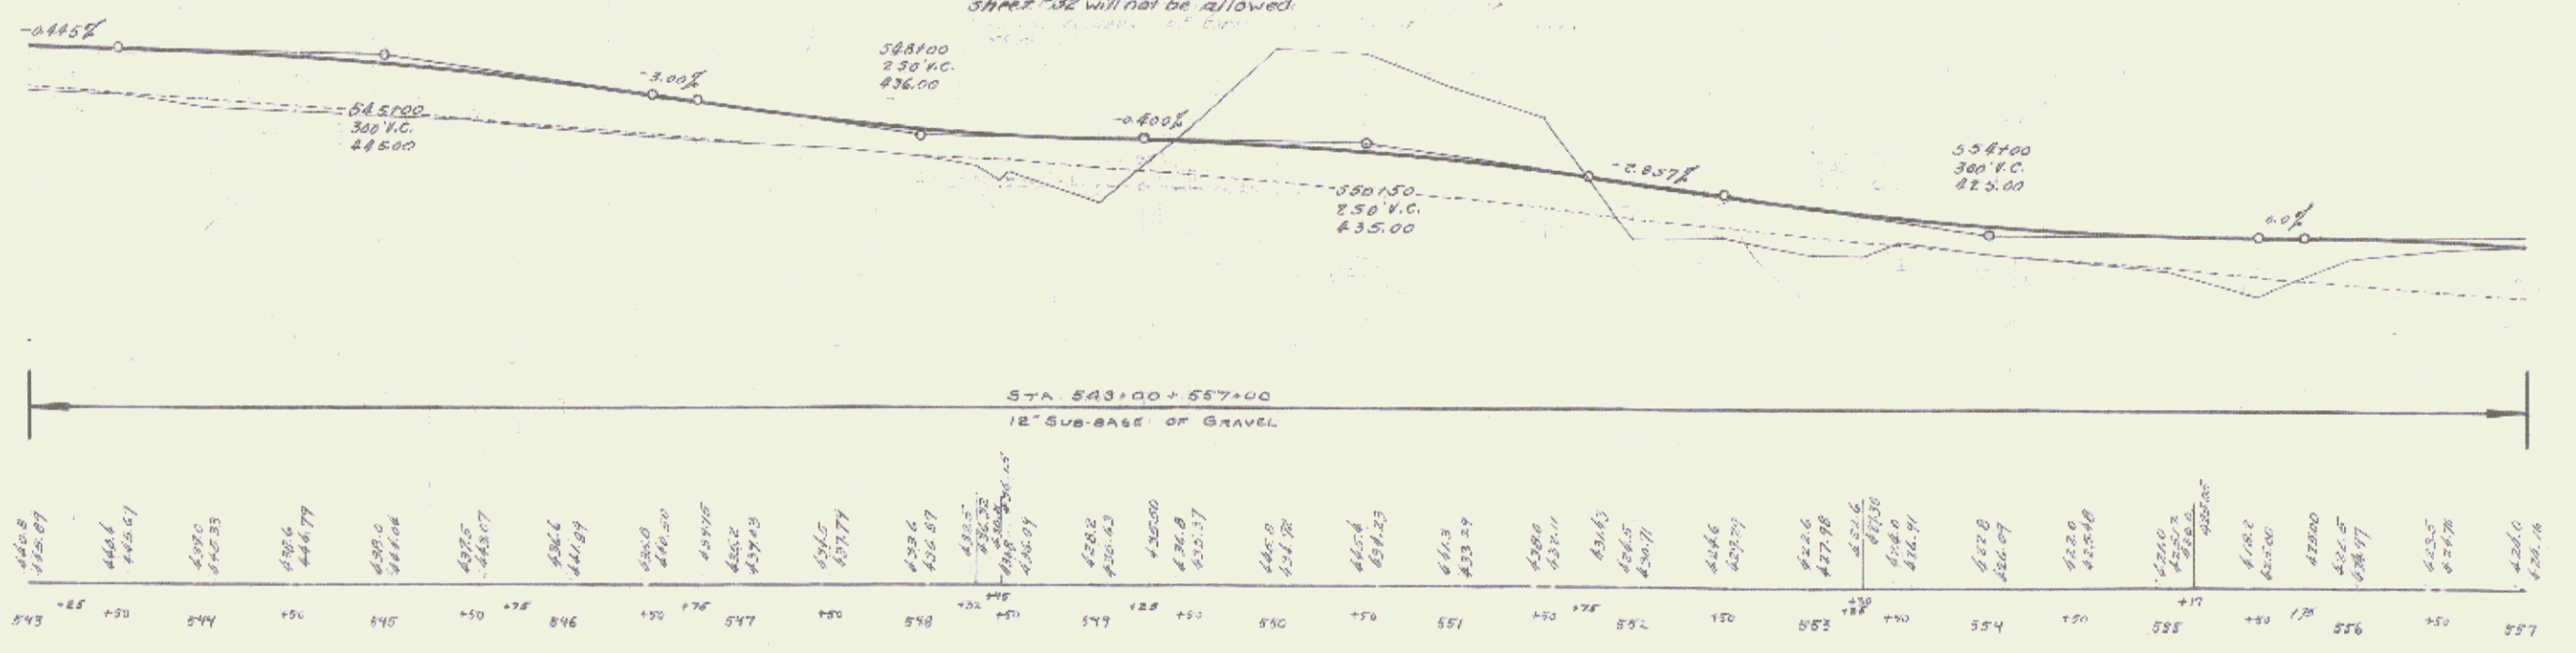


Parcel	Kind of Instrument	Date of Grant	Grantee	Recorded	Remarks
C	WD	6-22-33	W.C. Renchan	11-11-33	

1000 1933 777  
24 34  
(LANDSCAPE II)

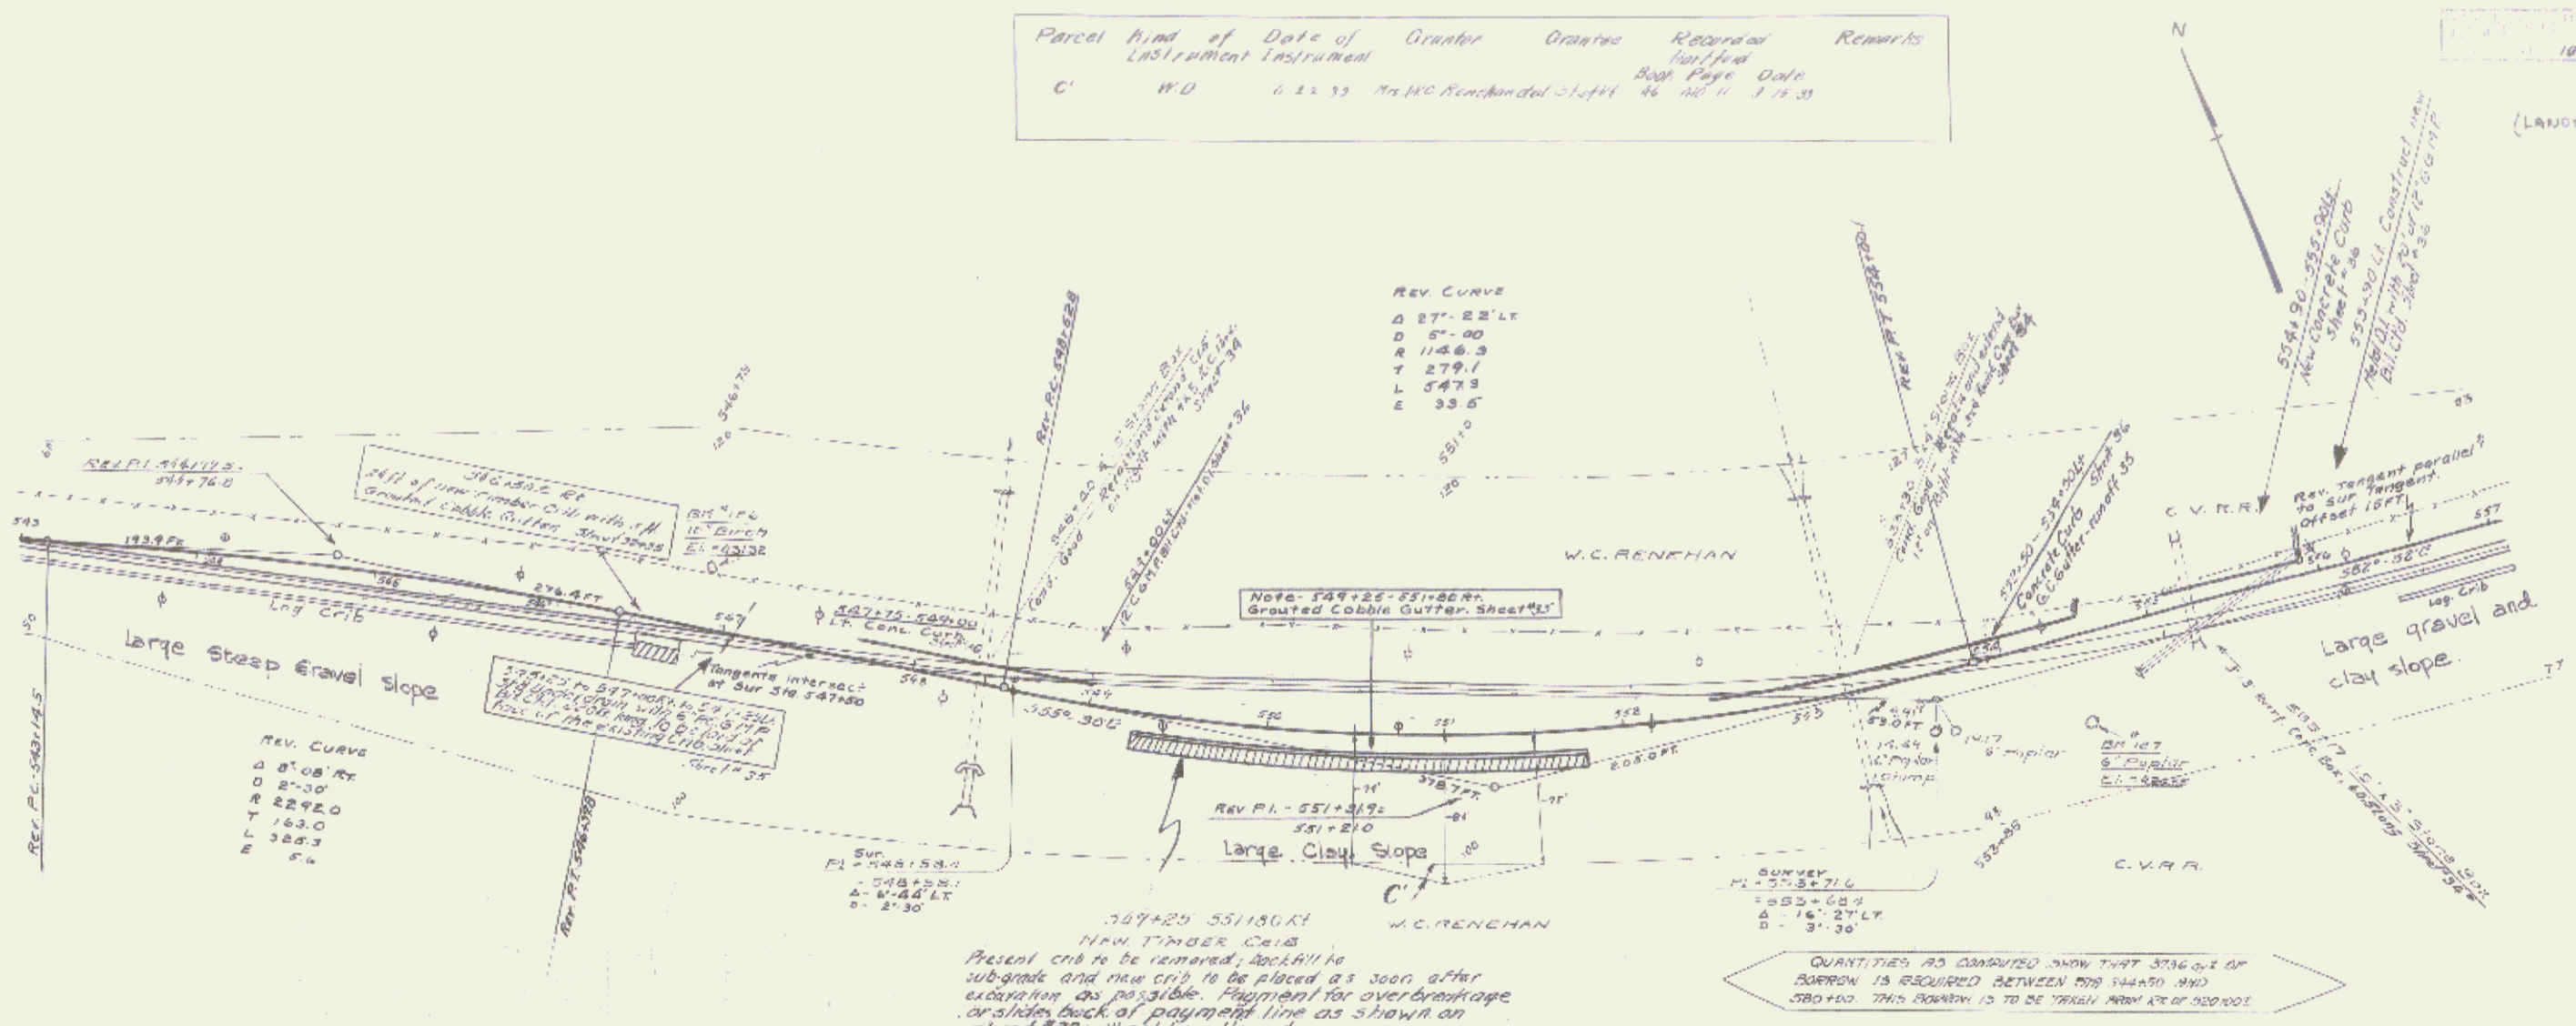

B.M. 126 Spike in Root 12" W Birch 38' E of Sta. 544+00 Elev 431.52  
B.M. 127 Spike in Root 6" Poplar 45' E of Sta. 554+51 Elev 426.55

LANDSCAPE II  
SERIES F NO. 100 C  
SHEET 34 OF 34  
34