
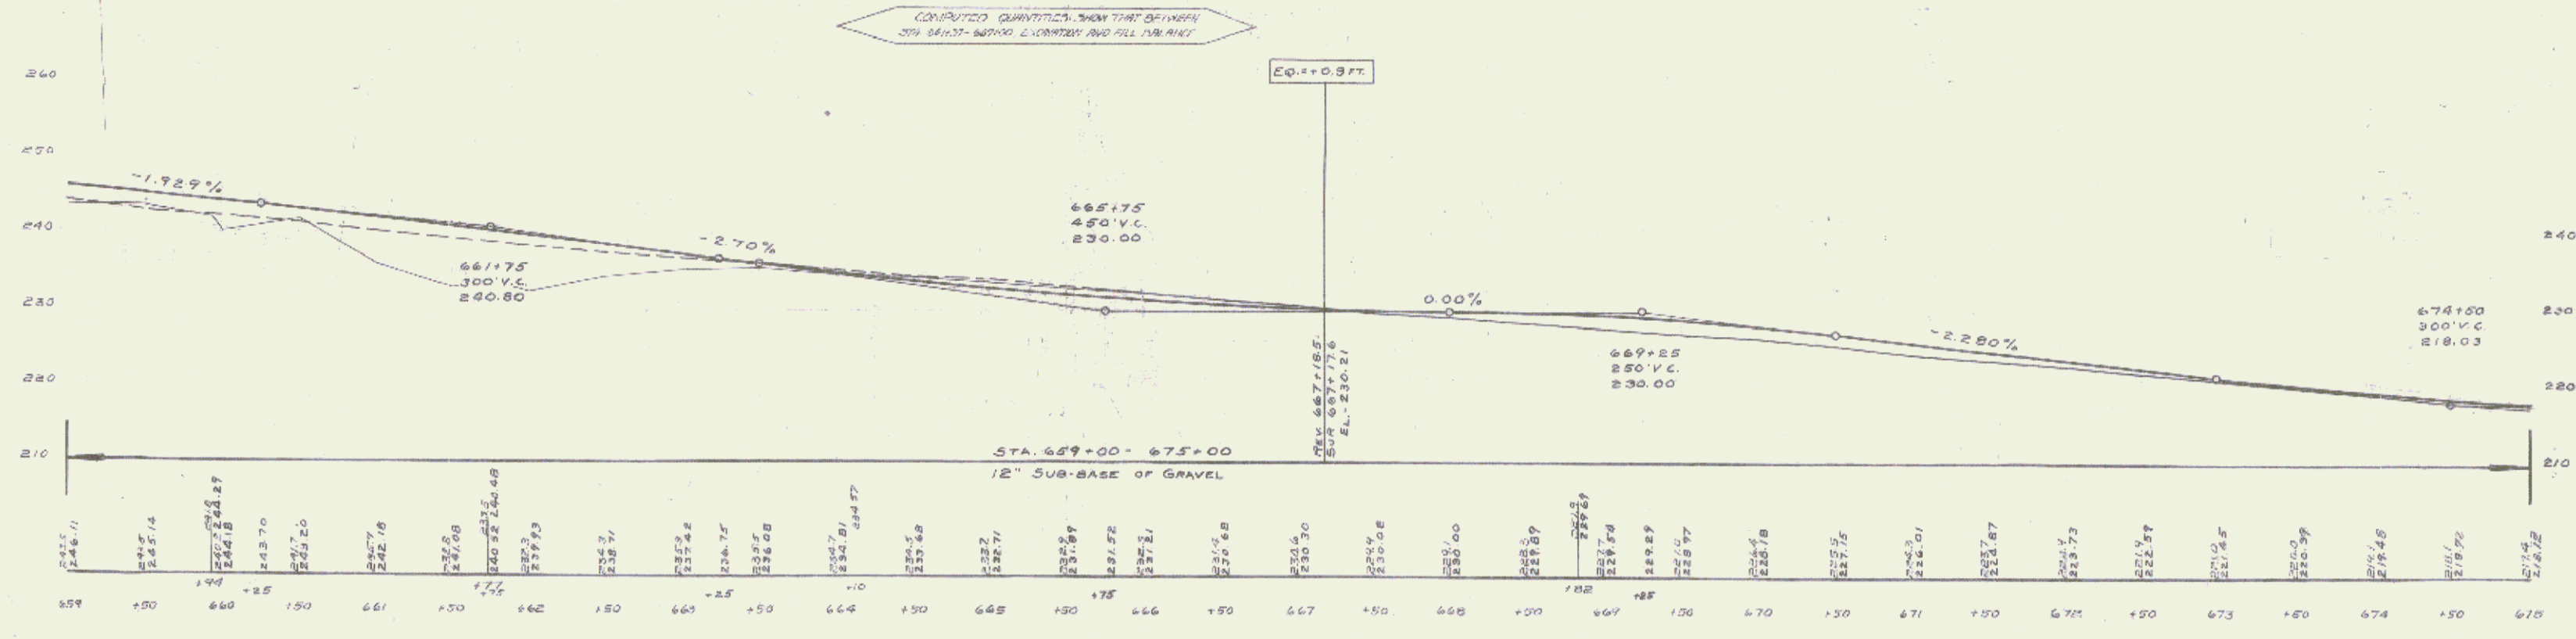


Parcel	Kind of Instrument	Date of Grant	Grantor	Grantee	Recorded	Remarks
A 12	M D	6-13-33	Mary Toney	Sluff	Book 106 C 1983	Page 33
					Map	Sheet 34

106 C 1983
33 34
(LANDSCAPING I)

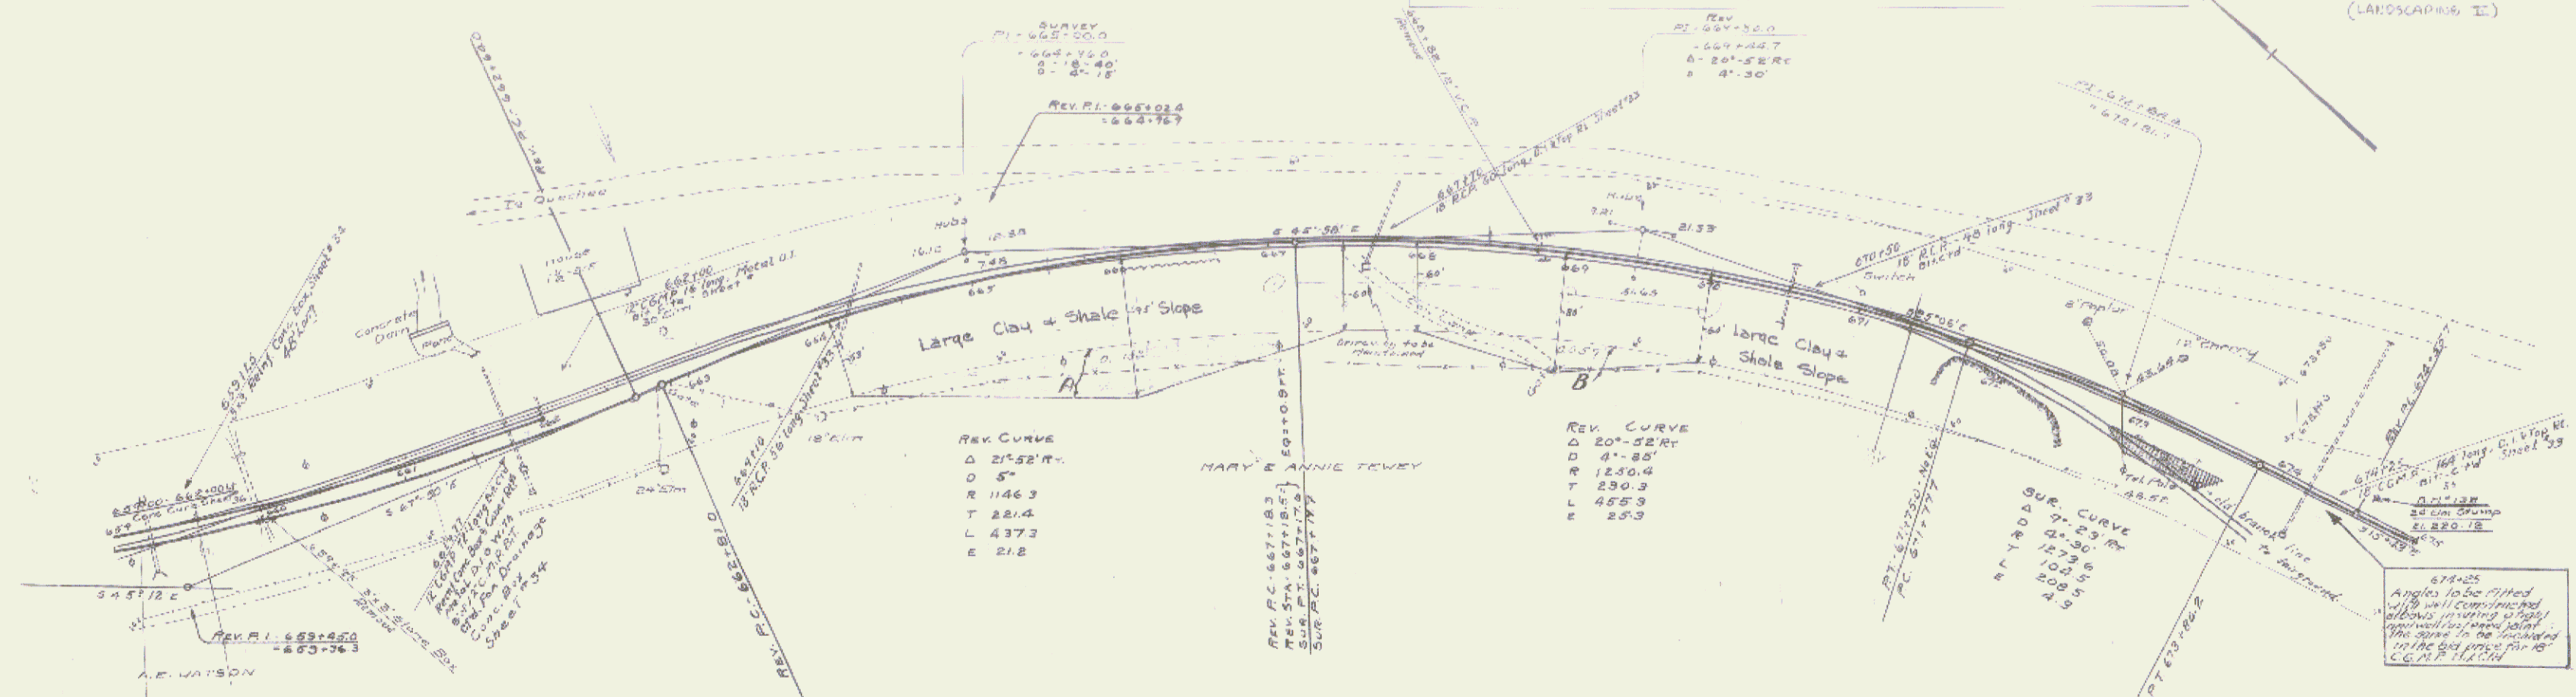

8 M" 1/32 Spike in Top 24" Elm Stump 16' Off. H. Sta. 671+62 Elev. 220.12

(LANDSCAPING II)
 SERIES 1 NO 106 C
 SHEET 34 OF 34