


REVISIONS  
 NO. DATE BY  
 1 10-20-66 1772 J.B. [initials]  
 2 11-1-66 1772 J.B. [initials]  
 (LANDSCAPING II)

PARCEL INSTRUMENT	DATE	GRANTOR	GRANTEE	RECORDED	REMARKS
A	W.D.O.E.	8-22-65	THE LOWER TERRACE WATER CO.	BOOK 358 PAGE 358	DATE 10-25-65

Computed Quantities show a borrow of 4700 cu yds between 667-683+10

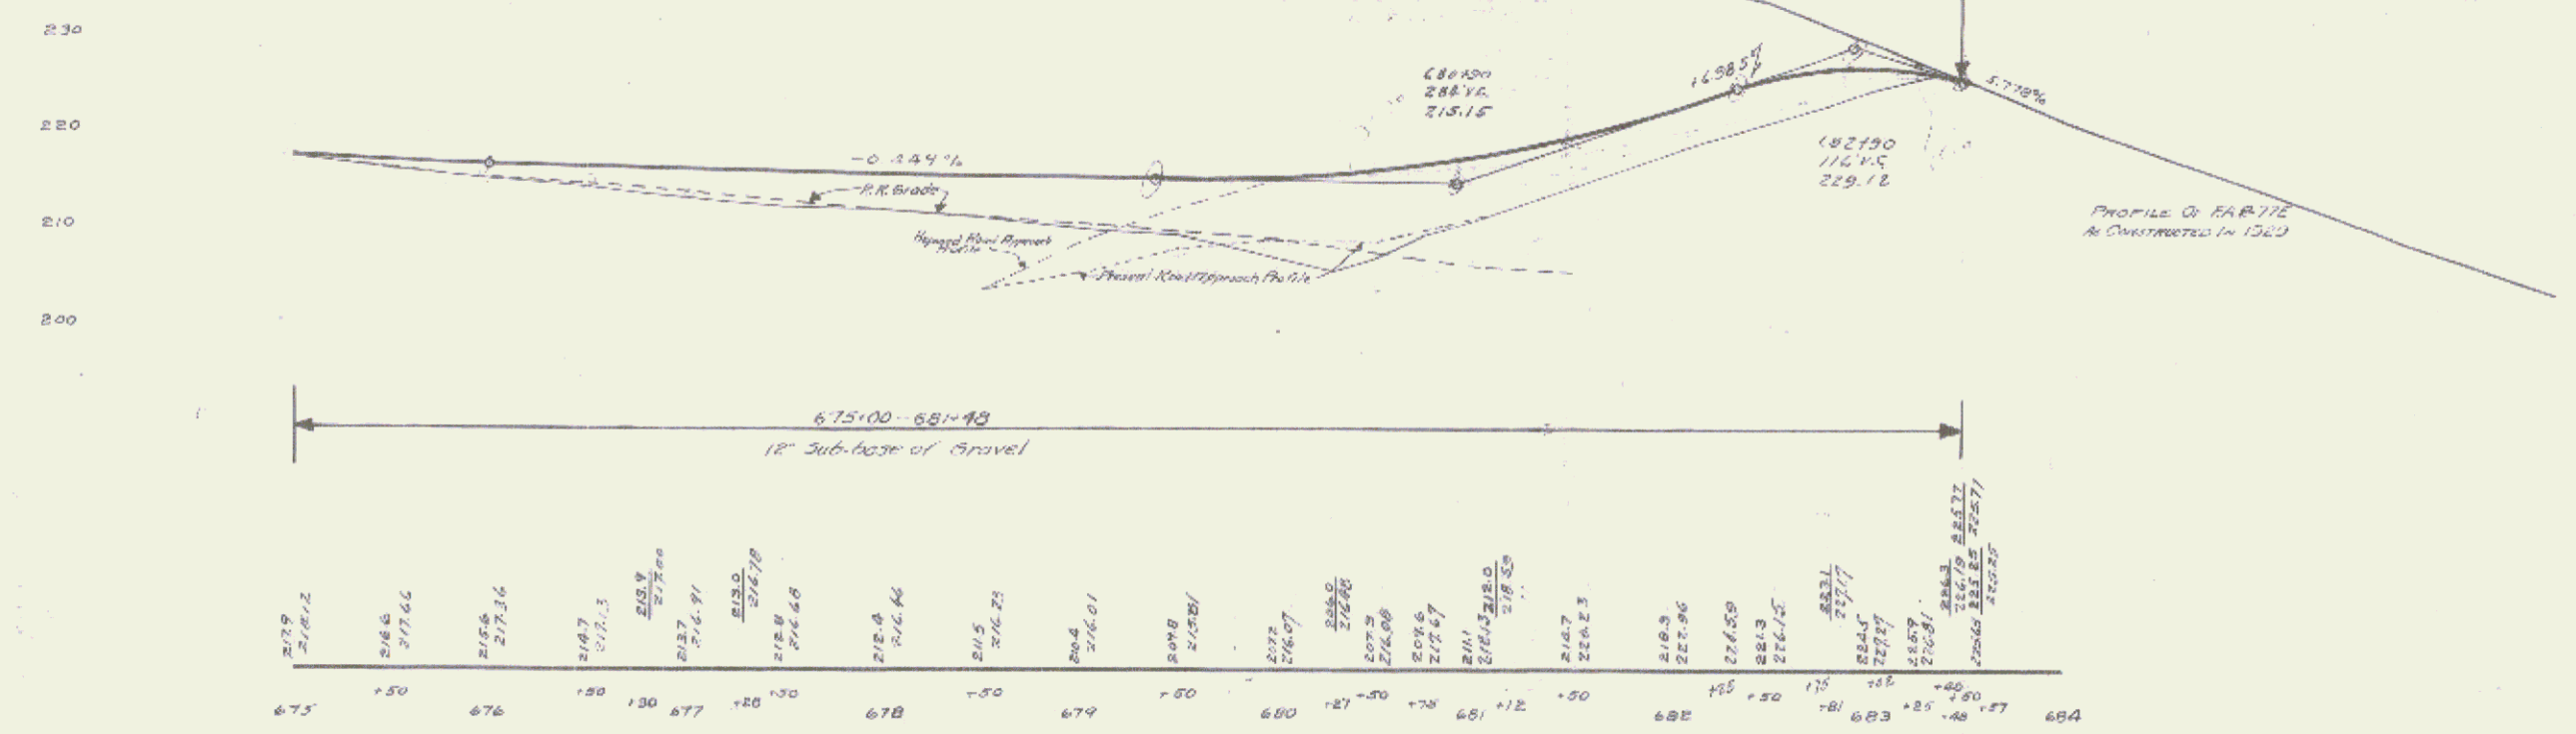

B.M. # 139 Spike in Root of 18' Maple 78' Left 682+50

(LANDSCAPING D)  
 SERIES F NO 100C  
 SHEET 22 OF 23