

SHEET NO.

1. Title Page
2. Typical Sheet-Bituminous Concrete Pavement (361-B)
3. Quantity Sheet-Items
4. Quantity Sheet-Drainage
5. Earthworks
6. S.D.W. Detail Sheet
7. Traffic Sign Location
8. Traffic Sign-Summary
9. Traffic Sign-Design & Construction Details
10. Delineator Location Sheet
- 11-13. Plan & Profile
14. A.G. CROSS IN SOLID ROCK
15. B-1 Banking
16. B-5 Slope Grading
17. B-10 Embankment on a Slope
18. B-11 Slope Stabilization
19. B-16 Divisional Islands
20. C-1 Curb
21. D-2 C.R.M.
22. D-3 Gutters
23. D-4 Underdrain, Flushing Basin
24. D-8 Drop Inlets
25. D-10 D.I. - Granite Slope Lining
26. D-11 D.I. Grates
27. D-16 D.I. Grates
28. E-1 Barricades, Signs & Lights
29. E-11 Interstate Route Markers
30. E-12 U.S. Route Markers
31. E-15 Regulatory Signs
32. E-16 Warning Signs
33. E-18 Guide Signs
34. E-19 Standard Sign Placement
35. E-20 Delineators, Hazard Marker
36. E-21 Ground Mounted Sign Support
37. E-31 Federal Aid Construction Identification Signs
38. G-3 Three Cable Guard-rail
39. G-4 Steel Marker Posts
40. J-1 Project and Boundary Marker
- 41-42. Nighttime Cross Street

<p>PROJECT NAME & NUMBER TYPE PAVT. AREA HARTFORD F 120-2(12) BIT. CONC. 2,268 S.Y.</p> <p>RECORD PLANS</p> <p>MATERIALS</p> <p>SUBBASE OF GRAVEL—DUPUIS PIT—QUECHEE, VT. SUBBASE OF SAND—POTTER PIT—QUECHEE, VT. GRAVEL BACKFILL—SMITH L'HEUREUX QUARRY (PERINI CRUSHER)—HARTFORD, VT. CUTBACK ASPHALT—HUMBLE OIL—EVERETT, MASS. BITUMINOUS CONCRETE—L.M. PIKE PLANT—W. LEBANON, N.H. CONCRETE CLASS B—MILLER READY MIX PLANT—W. LEBANON, N.H. REINFORCING STEEL—BETHLEHEM STEEL CORP.—ALBANY, N.Y.</p> <p>METAL CULVERT PIPE—NORTHEASTERN CULVERT CORP.—WESTMINSTER, VT. REINFORCED CONCRETE PIPE—HUME PIPE CO. OF NEW ENGLAND—WINDSOR, VT. GUARD RAIL ITEMS, SIGNS & EROSION CONTROL ITEMS—S.T. GRISWOLD & CO., INC.—WILLISTON, VT.</p>	<p>CONTRACTOR—PERINI CORP. FRAMINGHAM, MASS. RESIDENT ENGINEER—W.D. LAWRENCE. INSPECTORS—W. PIXLEY, R. COMI, H. DUKE, S. SIMPSON, M. WOOD & J. PERKINS. RECORD PLANS—A.G. SPIDLE.</p>	<p>CONTRACT DATED—DECEMBER 2, 1965. STARTED—DECEMBER 15, 1965 COMPLETED—JUNE 9, 1967. ACCEPTED—JUNE 14, 1967.</p>
---	---	--


DEPARTMENT OF TRANSPORTATION
PROPOSED IMPROVEMENT

TOWN OF HARTFORD
U.S. 4 SPUR
 PROJECT F-120-2(12)

BEGINNING AT A POINT IN THE EASTERLY EDGE OF U.S. ROUTE 4 AND EXTENDING EASTERLY 0.121 MILES.

LENGTH OF ROAD	0.121	638.0	FEET
LENGTH OF ROAD	0.121	638.0	FEET

1002
 2361
 346
 69
 5%
 35 MPH

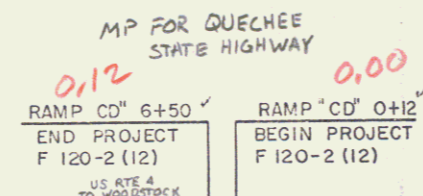

NOTE: U.S. 4 AND ALL TOWN ROADS ARE NOT IN THE CONSTRUCTION AREA EXCEPT AS INDICATED ABOVE.

RIGHT-OF-WAY DIVISION
 TOWN FILE
 PERPETUAL
 Town of U.S.4
 (To Be Returned To R.O.W. Division)

NOTE: TO BE BUILT IN ITS ENTIRETY DURING STAGE I CONSTRUCTION.

Project No. **F 120-2(12)**
 STAGE I CONSTRUCTION
 1 of 48

Copy to
 Type checked 6-14-67

HARTFORD F 120-2(12)
 CONTRACTOR—PERINI CORP.
 FRAMINGHAM, MASS.
 CONST. COMPLETED—JUNE 9, 1967.
 RECORD PLANS—A.G. SPIDLE.

PLANS AND THE S

THESE