


|             |          |
|-------------|----------|
| PLAN        | DATE     |
| DESIGNED BY | 10/21/50 |
| CHECKED BY  |          |
| APPROVED BY |          |
| NO.         | 102      |

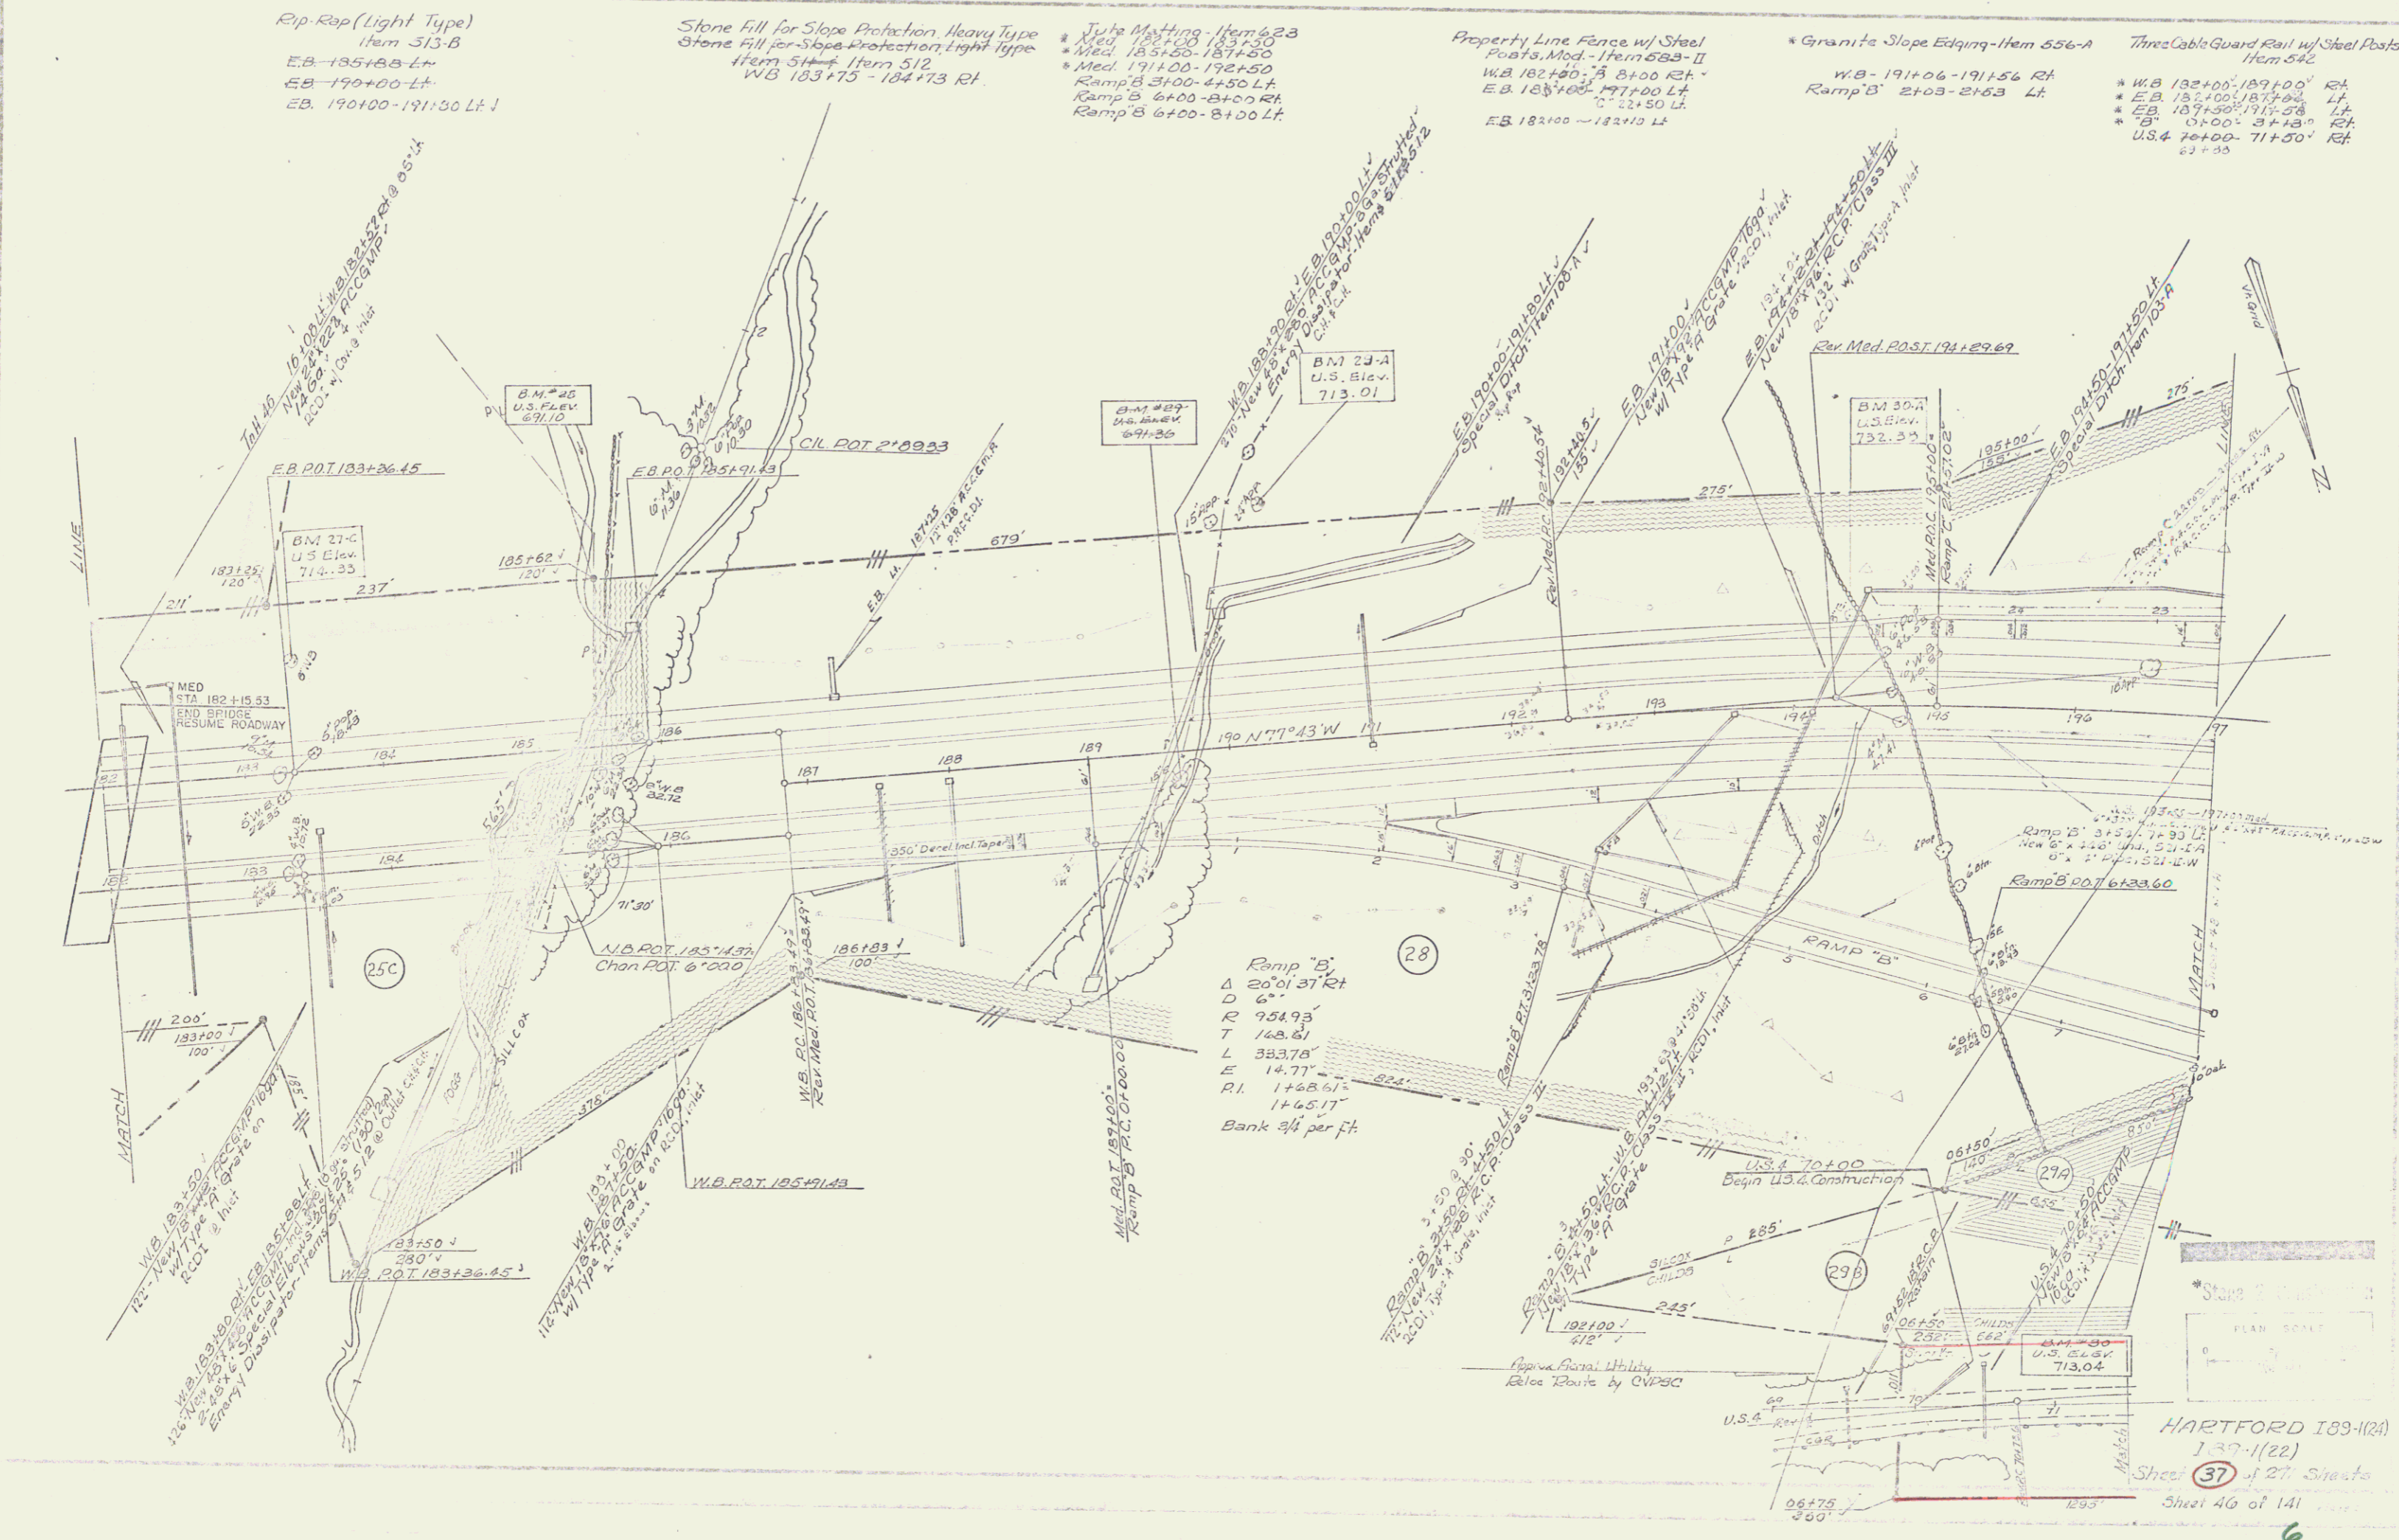

Rip-Rap (Light Type)  
Item 513-B  
E.B. 185+88-Lt  
E.B. 190+00-Lt  
E.B. 190+00-191+50 Lt.

Stone Fill for Slope Protection Heavy Type  
Stone Fill for Slope Protection Light Type  
Item 514-Lt Item 512  
W.B. 183+75-184+73 Rt.


July Meeting - Item 623  
Med. 185+50-187+50  
Med. 191+00-192+50  
Ramp B 3+00-4+50 Lt.  
Ramp B 6+00-8+00 Rt.  
Ramp B 6+00-8+00 Lt.

Property Line Fence w/ Steel  
Posts, Mod. - Item 589-II  
W.B. 182+00-8+00 Rt.  
E.B. 183+00-197+00 Lt.  
E.B. 182+00-182+10 Lt.

Granite Slope Edging - Item 556-A  
W.B. 191+06-191+56 Rt.  
Ramp B' 2+03-2+63 Lt.

Three Cable Guard Rail w/ Steel Posts  
Item 542  
\* W.B. 182+00-189+00 Rt.  
\* E.B. 182+00-183+00 Lt.  
\* E.B. 187+50-191+50 Lt.  
\* "B" 0+00-3+13 Rt.  
U.S.A. 70+00-71+50 Rt.  
21+55

Ramp "B"  
Δ 20' of 31 Rt  
D 6'  
R 954.93'  
T 148.81'  
L 353.78'  
E 14.71'  
R.I. 1468.61'  
1445.17'  
Bank 2 1/2 per ft.

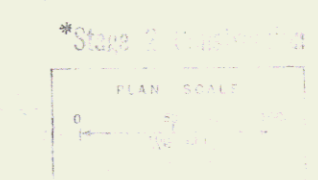

HARTFORD 189-112A  
137-1(22)  
Sheet 37 of 27 Sheets  
Sheet 46 of 141