

PLAN	DATE	BY
REVISED		
DATE		
BY		
REVISIONS		
NO.	DATE	DESCRIPTION
1		
2		
3		
4		
5		
6		
7		
8		
9		
10		

Drilling & Blasting of Solid Rock Subgrade  
 Ramp 1 1210-1240  
 1210-1240  
 1210-1240  
 1210-1240  
 1210-1240

Life Matting Item 623  
 \* Med. 200150-201+50  
 \* Med. 203+00-205+00  
 \* Med. 207+00-209+00

\* Bituminous Concrete Curb Drain Item 554  
 Ramp A 0+74 Rt.  
 Ramp B 15+00-15+19 Rt.

Rip-Rap (light type) Item 513-B  
 E.B. 207+25-208+48 Lt. V  
 E.B. 207+90 Lt.  
 W.B. 208+90 Rt - Ramp A 5+40 Lt.

\* Bituminous Concrete Curb Item 555  
 W.B. 207+25-209+25 Rt.  
 W.B. 207+25-211+00 Rt.

Ramp C  
 Δ 62°18'25" Rt.  
 D 9°30'  
 R 602.11  
 T 344.59  
 L 655.86  
 E 101.64  
 PT 14+62.29  
 13+88.77  
 Bank 1% per ft.

Demolition and Disposal of Building Item 586  
 Ramp A 9+00 Rt. #26 ✓  
 Ramp D  
 Δ 82°15'47" Rt.  
 D 8°30'  
 R 674.07  
 T 558.68  
 L 767.80  
 E 220.87  
 PT 5+58.68  
 2+79.12  
 Bank 7% per ft.


Property Line Fence w/ Steel Posts, Med. - Item 588-II  
 Ramp C 12+50-22+55 Rt.  
 Ramp D 0+00-8+00 Rt.  
 Ramp B 8+00-13+50 Rt.  
 Ramp A 2+00-9+50 Rt.

Three Cable Guard Rail w/ Steel Posts Item 542  
 \* W.B. 207+50-211+50 Rt.  
 \* E.B. 207+50-208+62 Lt.  
 U.S. 4 7+45-87+00 Rt.

Drilling and Prappling of Solid Rock Item 129  
 E.B. 211+00 Rt. - 212+00 Lt.  
 Granite Slope Edging Item 556-A  
 \* Ramp A 0+74-1+07 Lt.  
 \* Ramp B 0+74-1+07 Lt.  
 U.S. 4 7+45-11-11 Rt.  
 \* E.B. 209+87-210+37 Lt.  
 U.S. 4 7+45-78+00 Lt. (L-1)  
 \* Ramp B 13+82-14+00 Lt. (L-1)  
 U.S. 4 7+45-78+00 Lt. (L-1)  
 U.S. 4 7+45-87+00 Rt. (L-1)  
 \* Ramp D 1+70-2+20 Lt.

Standard Steel Beam Guard Rail w/ Steel Posts Item 545-A  
 \* Ramp A 1+30-5+40 Lt.  
 \* Ramp A 1+30-5+40 Lt.  
 U.S. 4 8+45-83+43 Lt.  
 \* U.S. 4 79+90 Lt. - Ramp A 0+74 Rt.

Removal & Disposal of Present Guard Rail, Item 543  
 U.S. 4 - 33+03-36+43  
 75+00-33+72

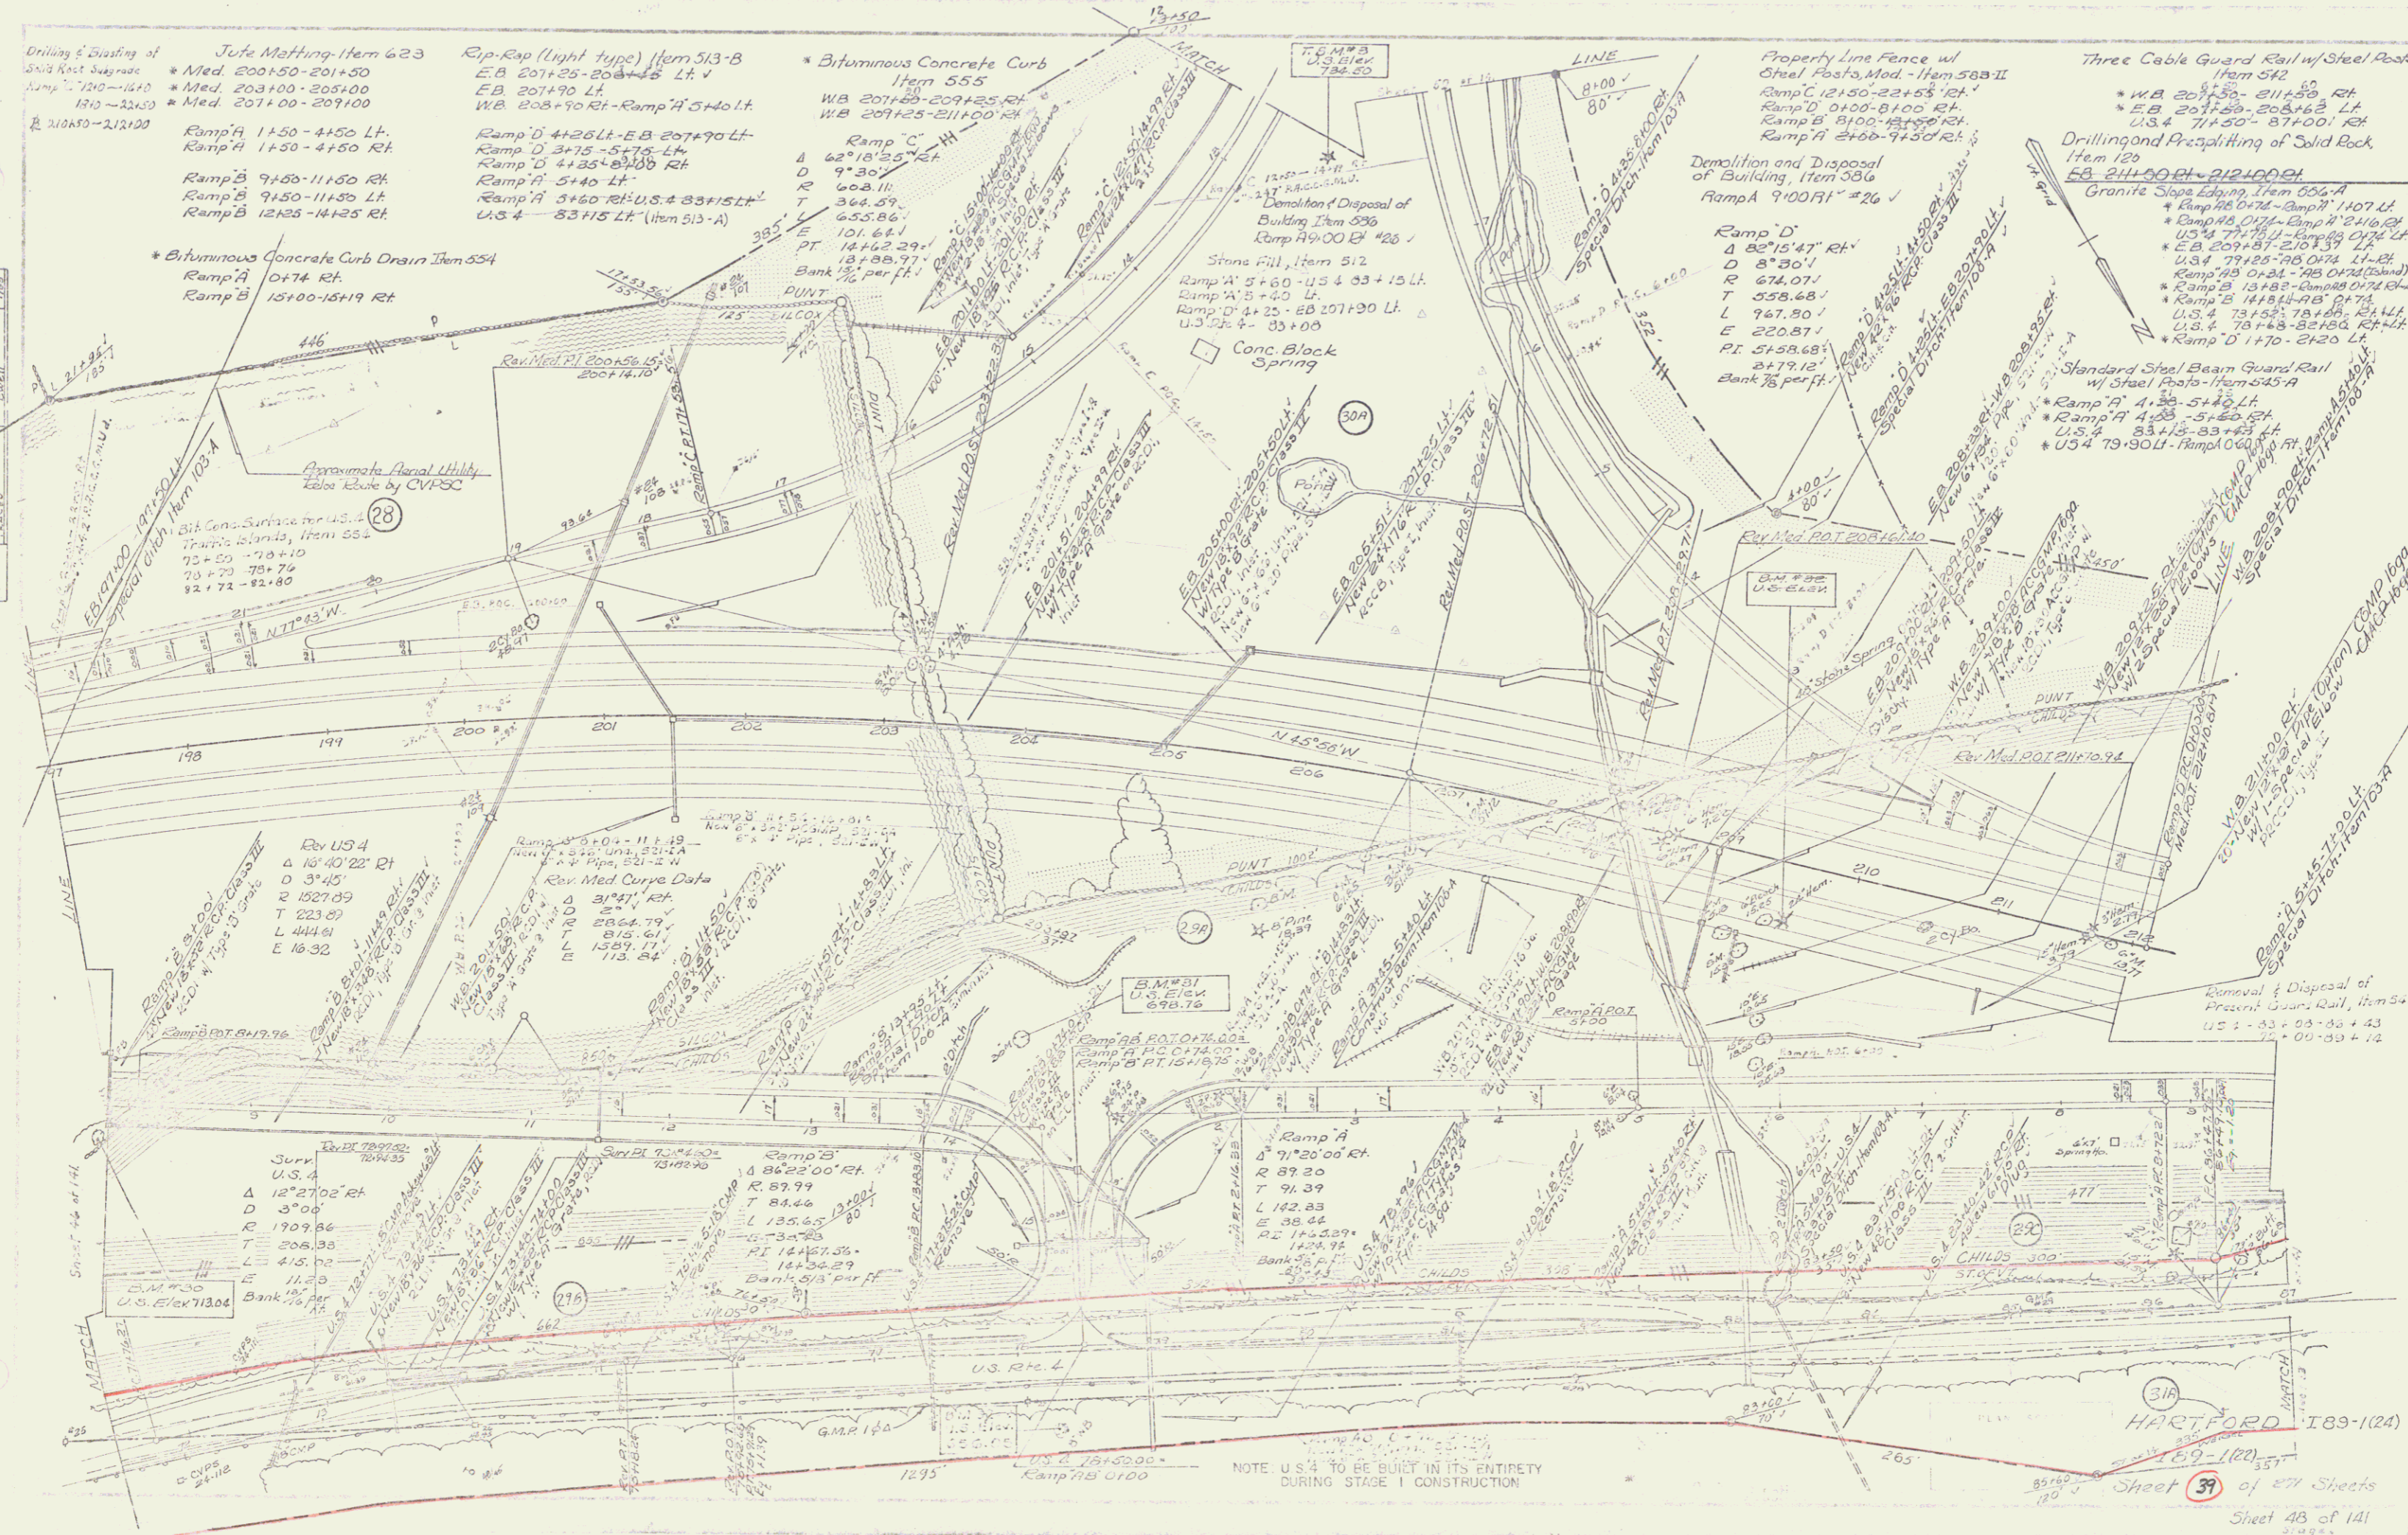

NOTE: U.S. 4 TO BE BUILT IN ITS ENTIRETY DURING STAGE I CONSTRUCTION

HARTFORD 189-1(24)  
 Sheet 39 of 277 Sheets  
 Sheet 48 of 141  
 7