


Parcel	Kind of Data	Instrument	Owner	Quantity	Recorded	Remarks
A	O.C.D.	1-17-34	RES. G.C. HULLATT	37.07	69	188-34
B	O.C.D.	1-6-34	W.E. DAVIS	"	69	188-34
C	O.C.D.	9-9-34	C.E. KITCHIN	"	96-97	9-2-34

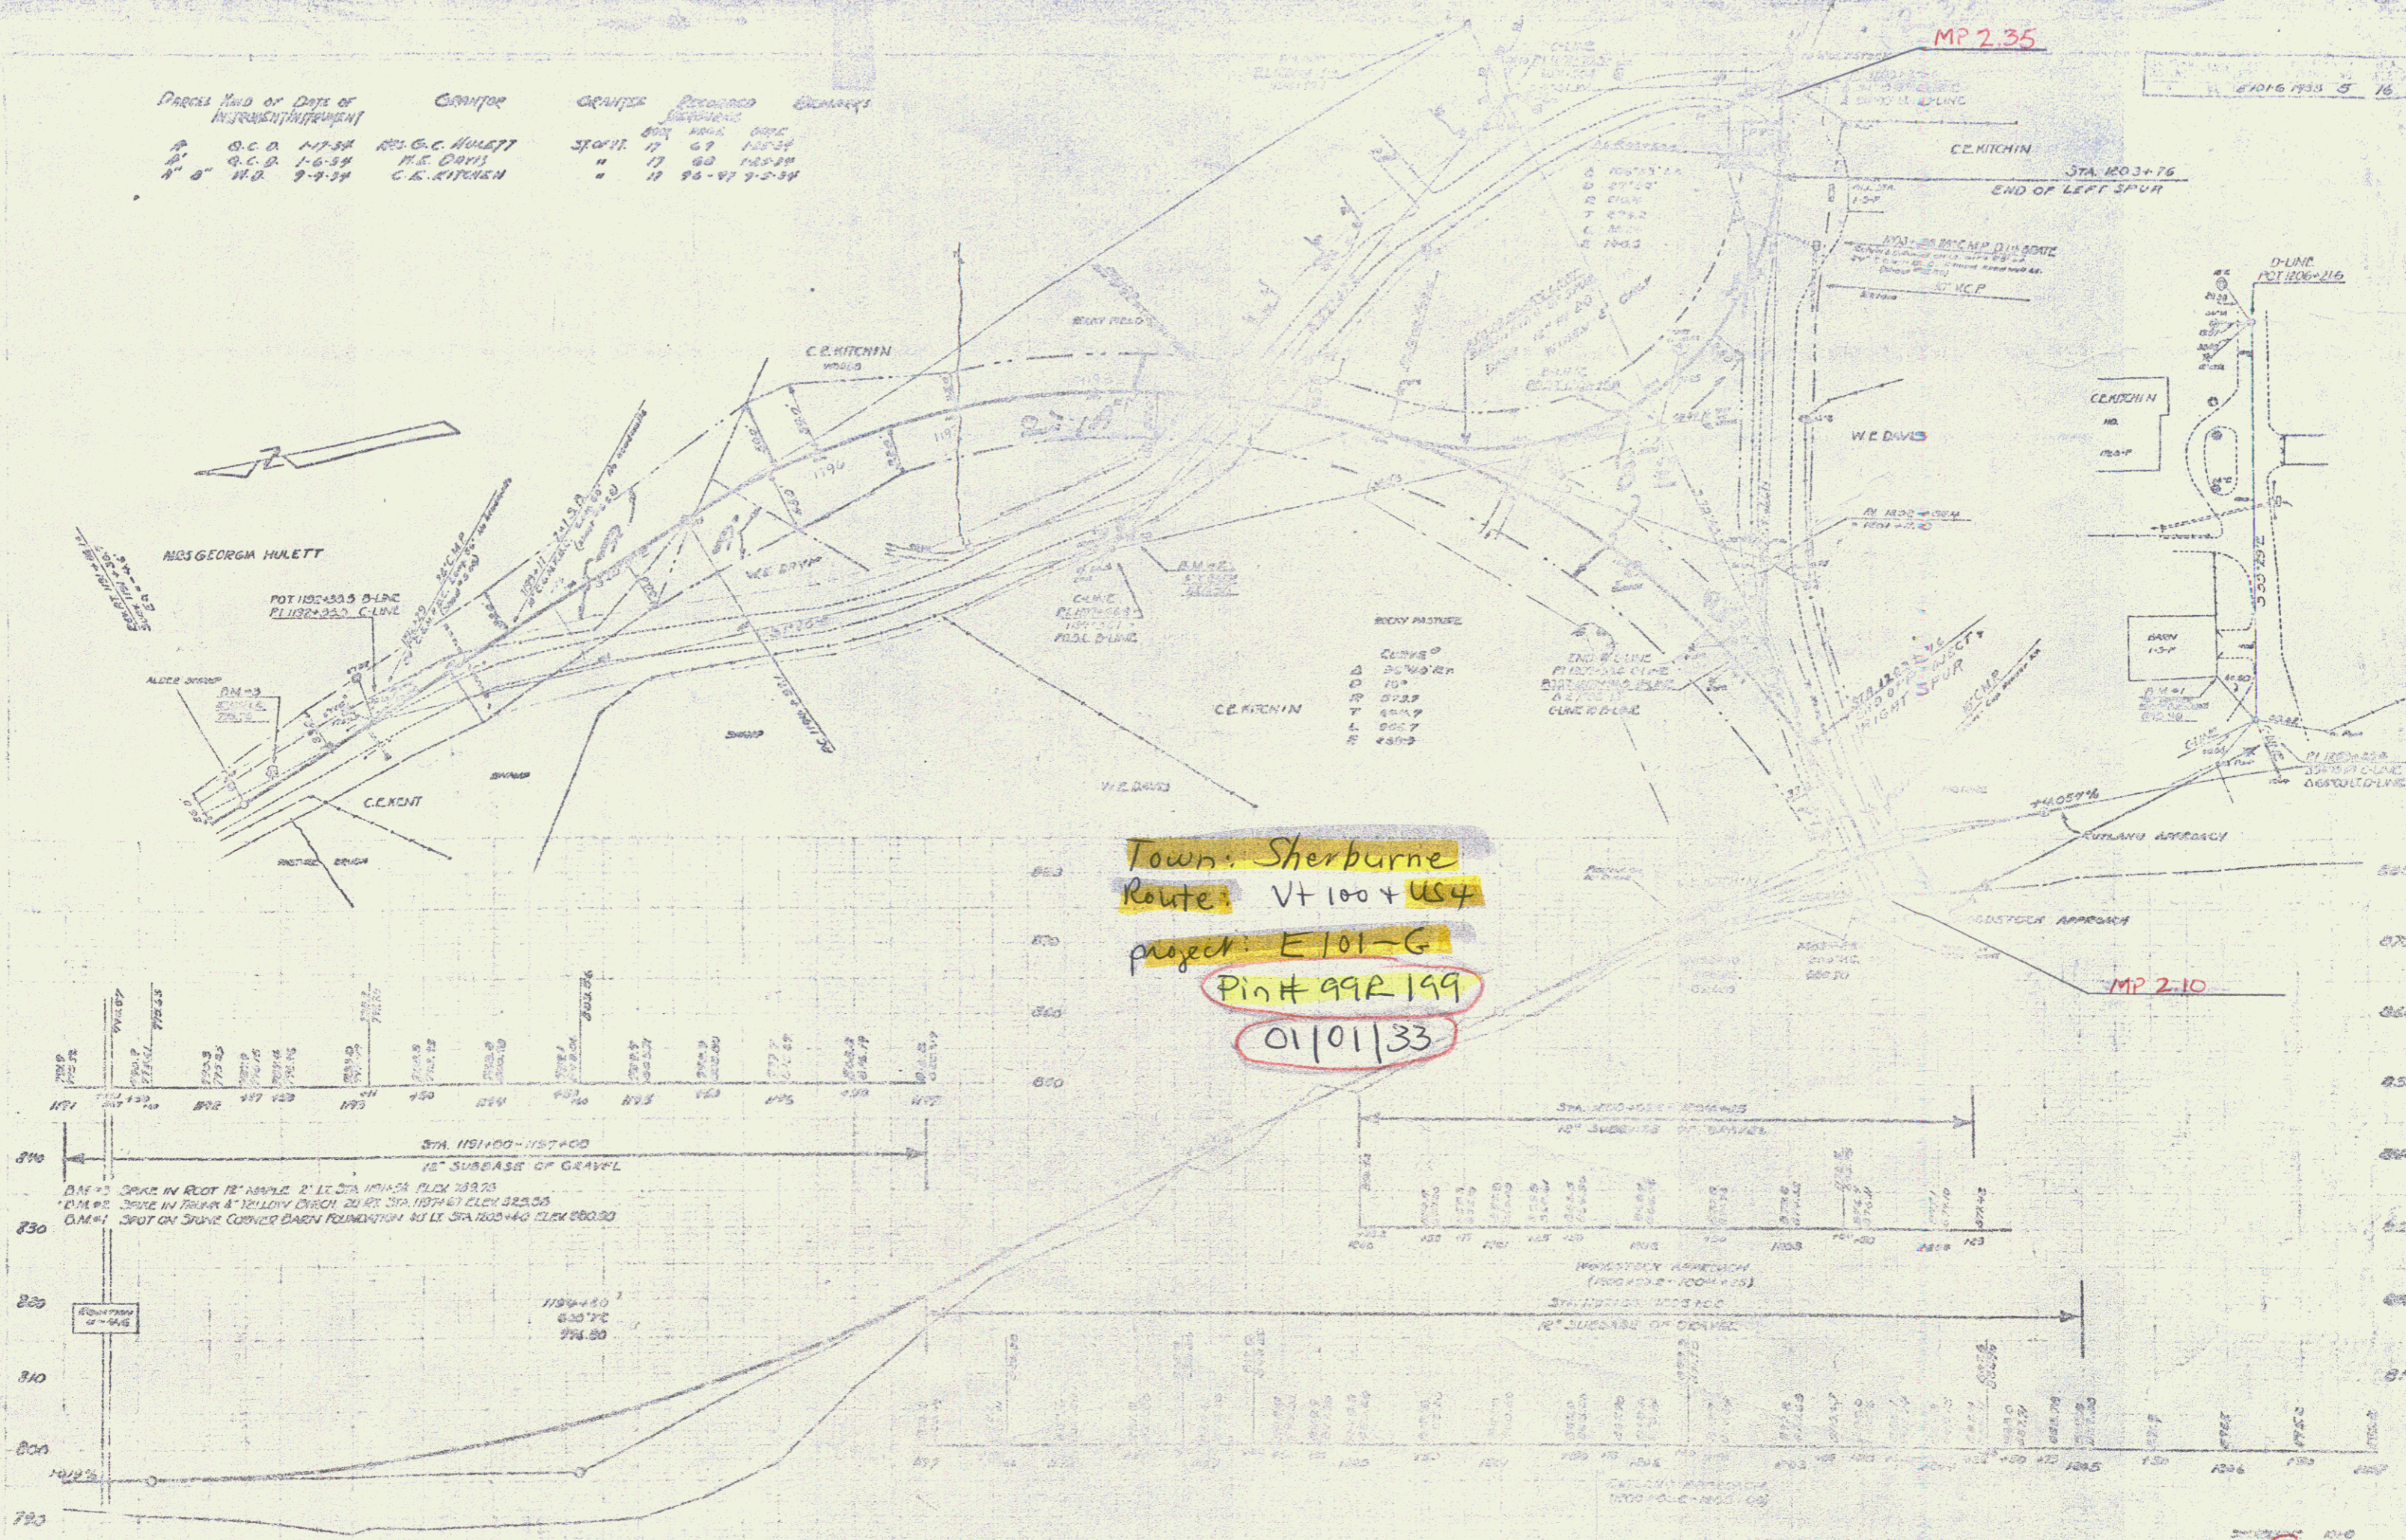

Town: Sherburne
 Route: VT 100 + US 4
 project: E 101-G
 Pin # 99R 199
 01/01/33

MP 2.35

MP 2.10

5