



PARCEL	INSTRUMENT	DATE	GRANTOR	GRANTEE	BOOK	PAGE	RECORDED SHERBURNE	DATE	REMARKS
#3	Q.C.D.	10-19-46	FRANK TROMBETTA	ST. OF VT.	19	139-140	10-19-46		
#2	W.D.C.E.	10-25-46	MARIANO & ANNA FERNANDEZ	"	19	141-143	11-2-46		

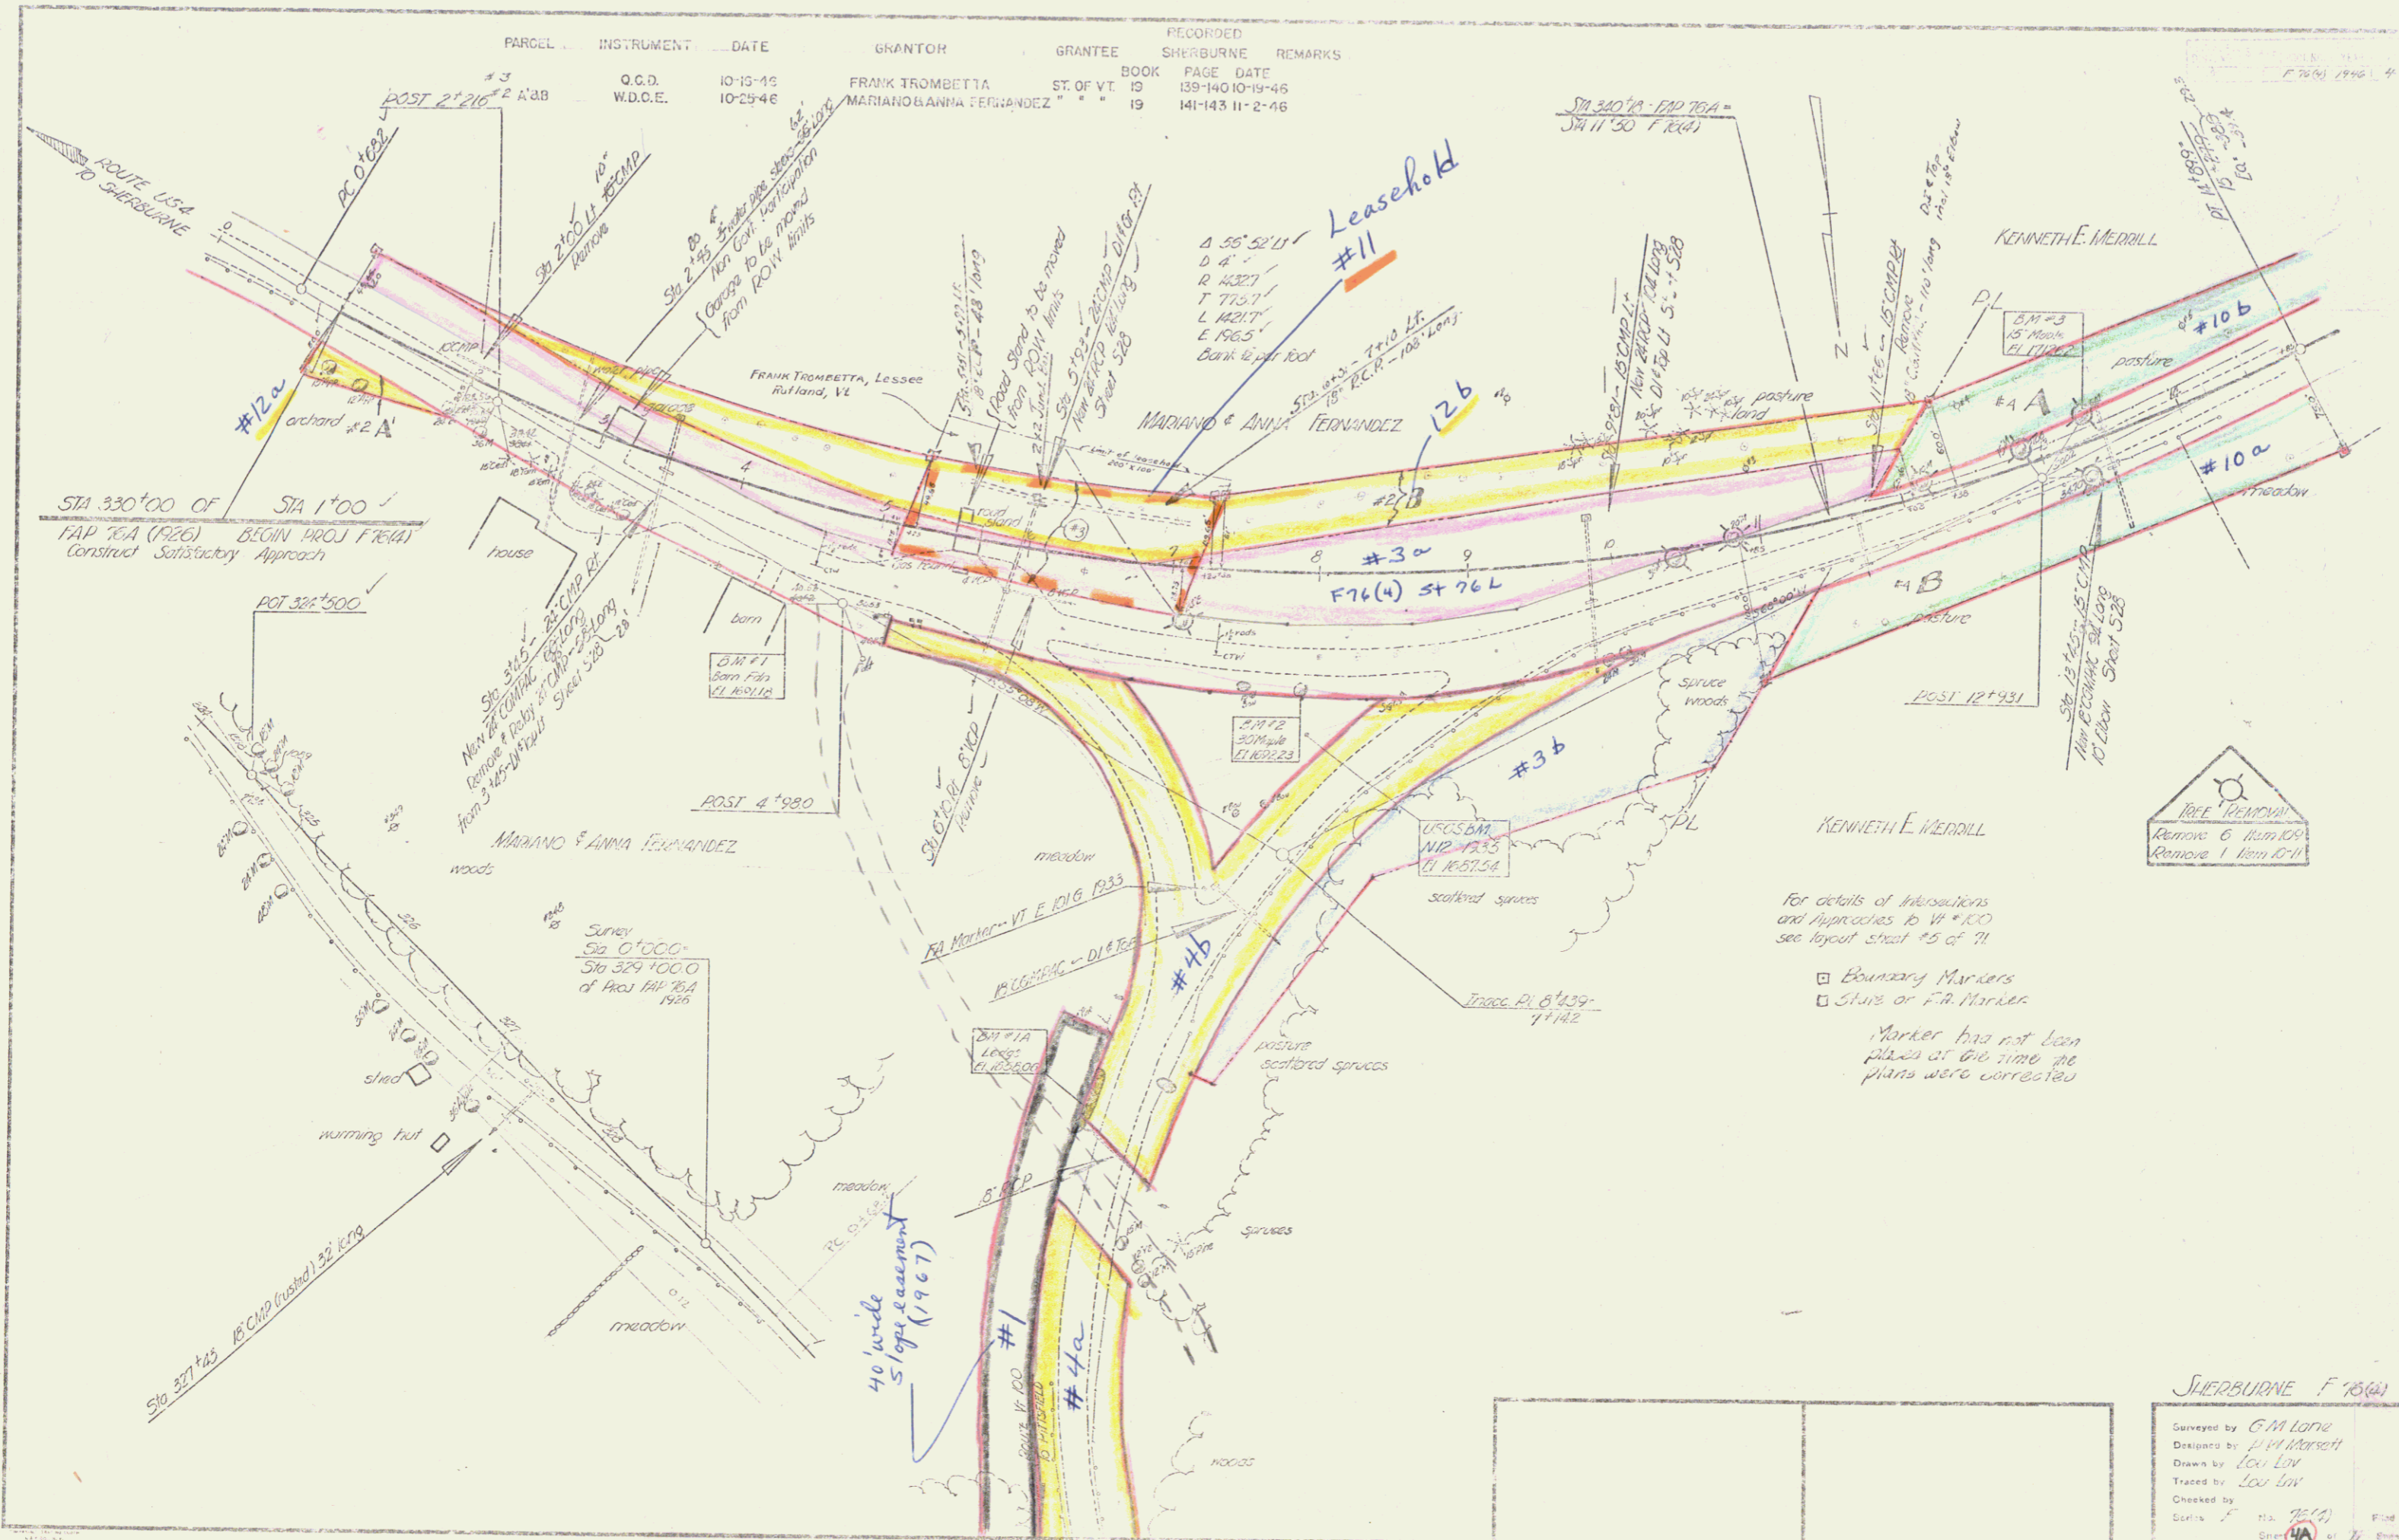

For details of Intersections and Approaches to Vt 100 see layout sheet #5 of 71

- Boundary Markers
- Stone or F.A. Marker

Marker has not been placed at this time the plans were corrected

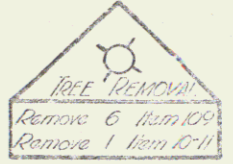

SHERBURNE F 1864

Surveyed by G.M. Lane
 Designed by J.W. Marslett
 Drawn by Lou Lov
 Traced by Lou Lov
 Checked by
 Scale: 1" = 100'
 Sheet 11 of 11