


PARCEL	INSTRUMENT	DATE	GRANTOR	GRANTEE	RECORDED SHERBURNE BOOK PAGE DATE	REMARKS
#12 A	W.D.O.E.	9-18-46	JOS. A. ABEL	STOF V.T.	19 135-137 10-19-46	
#11 A	Q.G.D.	11-29-46	FLORENCE T. HANDY, MORTIMER R. PROCTOR, SANBORN & CHAS. F. PARTRIDGE		19 155-157 1-11-47	

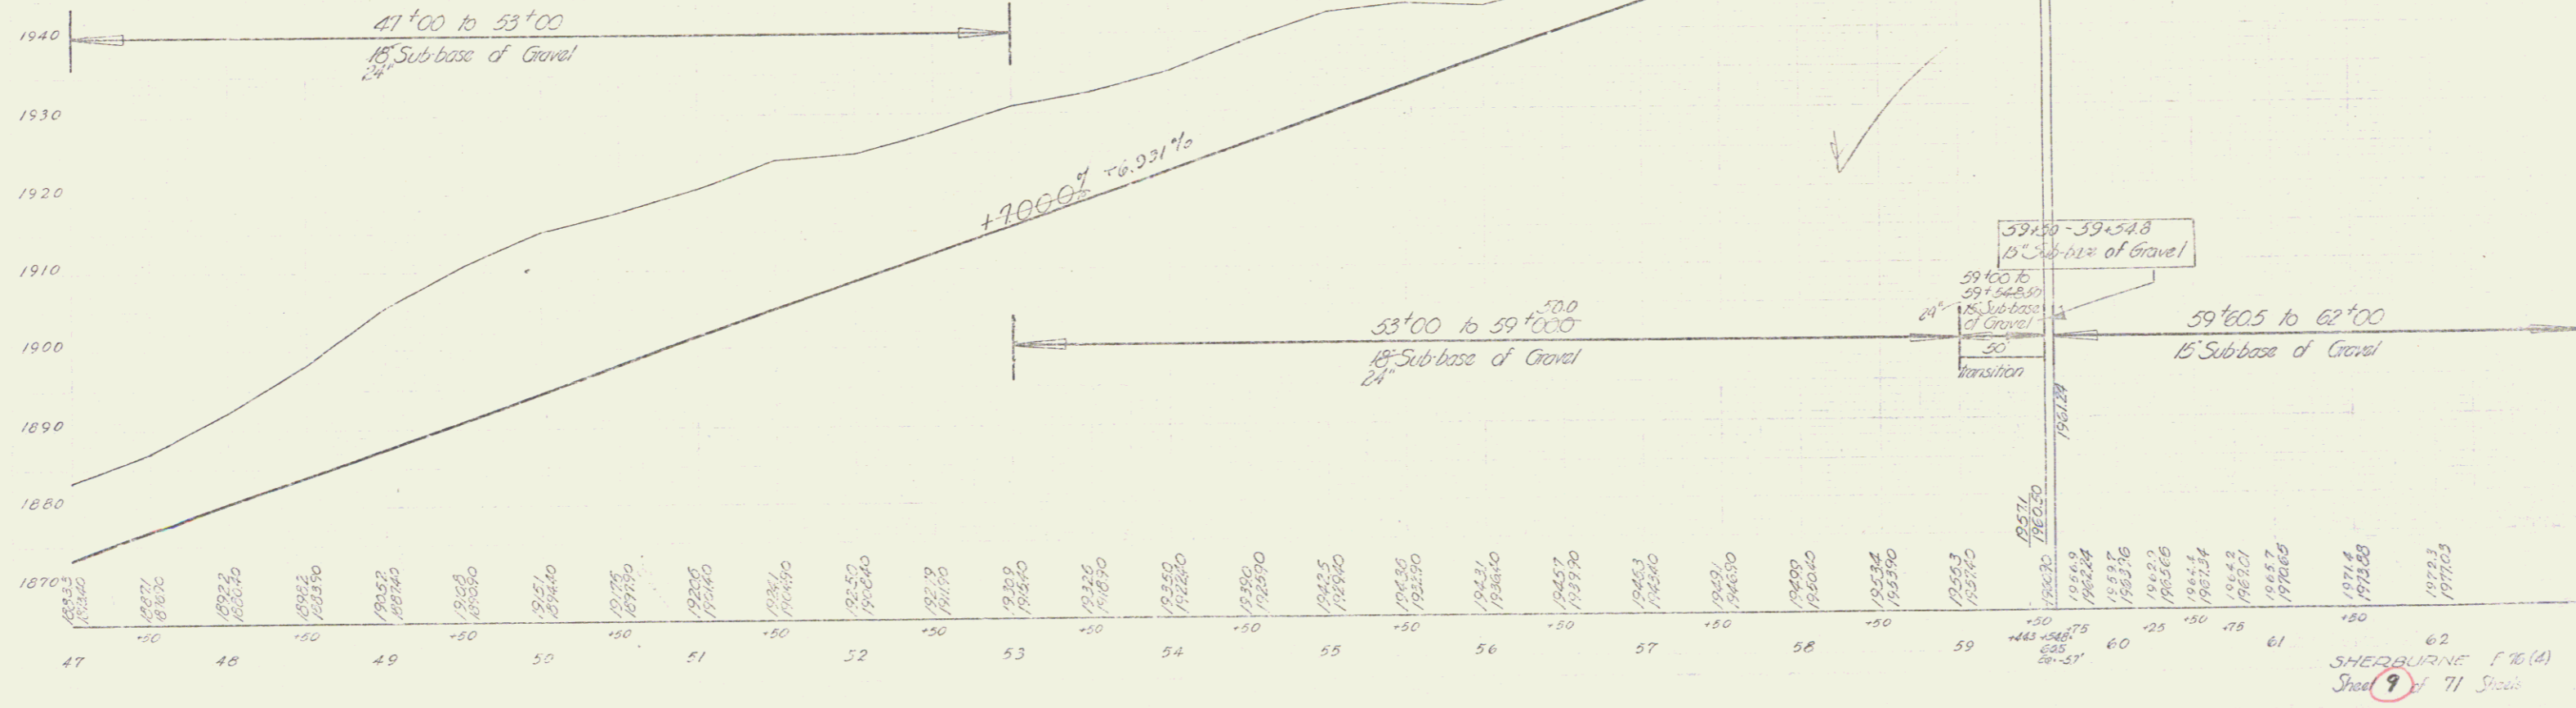

- B.M. #12 S.I.R. 10" Yellow Birch 110' Lt. Sta. 50+45 Elev. 1905.62
- B.M. #13 S.I.R. 30" Maple 82' Lt. Sta. 52+75 Elev. 1919.28
- B.M. #14 S.I.R. 12" Spruce 17' Lt. Sta. 54+97 Elev. 1939.19
- B.M. #15 S.I.R. 15" Yellow Birch 43' Lt. Sta. 58+10 Elev. 1934.50
- B.M. #16 S.I.R. 3" Maple 15' Sta. 61+02 Elev. 1968.64
- B.M. #16A S.I.R. 2-15" Yellow Birches 71' Lt. Sta. 61+12 Elev. 1966.64

SHERBURNE F 70 (A)
Sheet 9 of 71 Sheets