


PARCEL	INSTANT	DATE	GRANTOR	GRANTEE	RECORDED SHEET-BURNING BOOK PAGE DATE	REMARKS
13A	OOD	1-6-47	MORTIMER R. PROCTOR ST. OF VI	GREEN MTN. CLUB, INC.	19 157-18 1-11-47	
13A	CORR WDOE	1-6-47	MORTIMER R. PROCTOR ST. OF VI	GREEN MTN. CLUB, INC.	19 157-18 1-11-47	

CAD

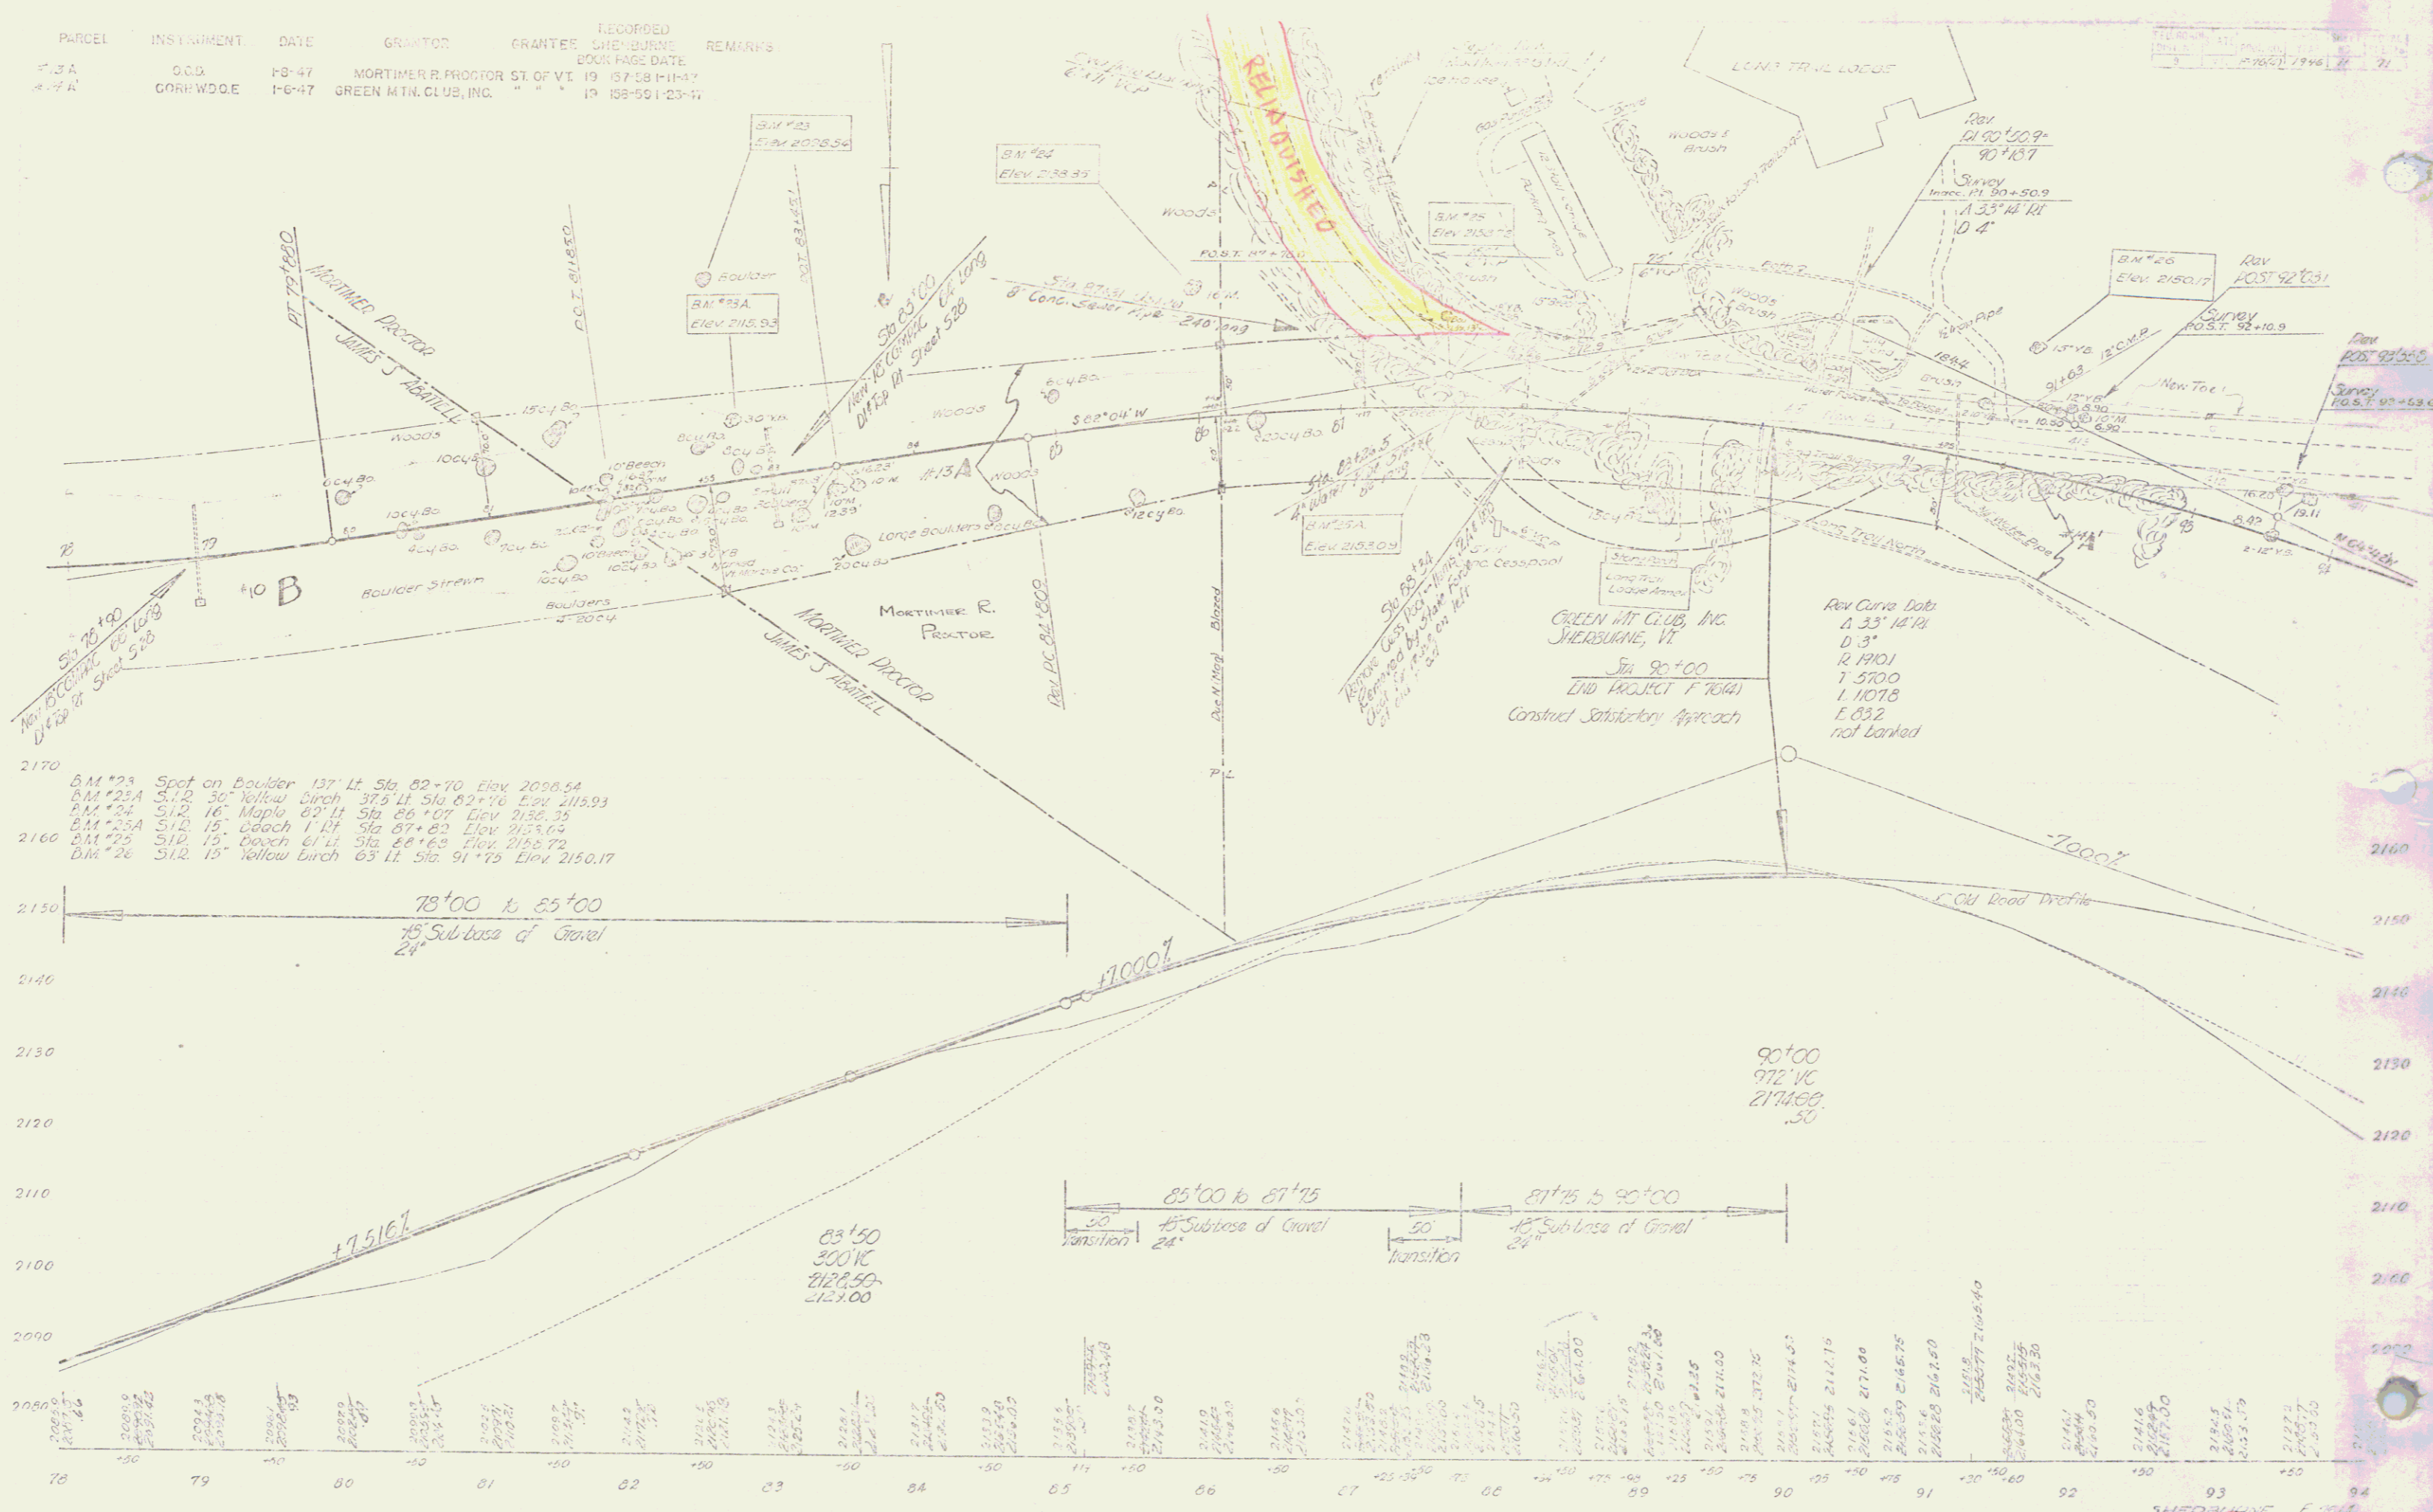

Rev Curve Data  
 A 33' 14" R  
 D 3"  
 Sta 90+00  
 7 5700  
 1 1078  
 E 832  
 not banked

GREEN MTN CLUB, INC  
 SHERBURNE, VT  
 Sta 90+00  
 END PROJECT F 7094  
 Const'd Substructure Approach