






PARCEL	INSTRUMENT	DATE	GRANTOR	GRANTEE	BOOK	PAGE	RECORDED	REMARKS
#3	Q.C.D.	10-19-46	FRANK TROMBETTA	ST. OF VT.	19	139-140	10-19-46	
#2	W.D.C.E.	10-25-46	MARIANO & ANNA FERNANDEZ	"	19	141-143	11-2-46	

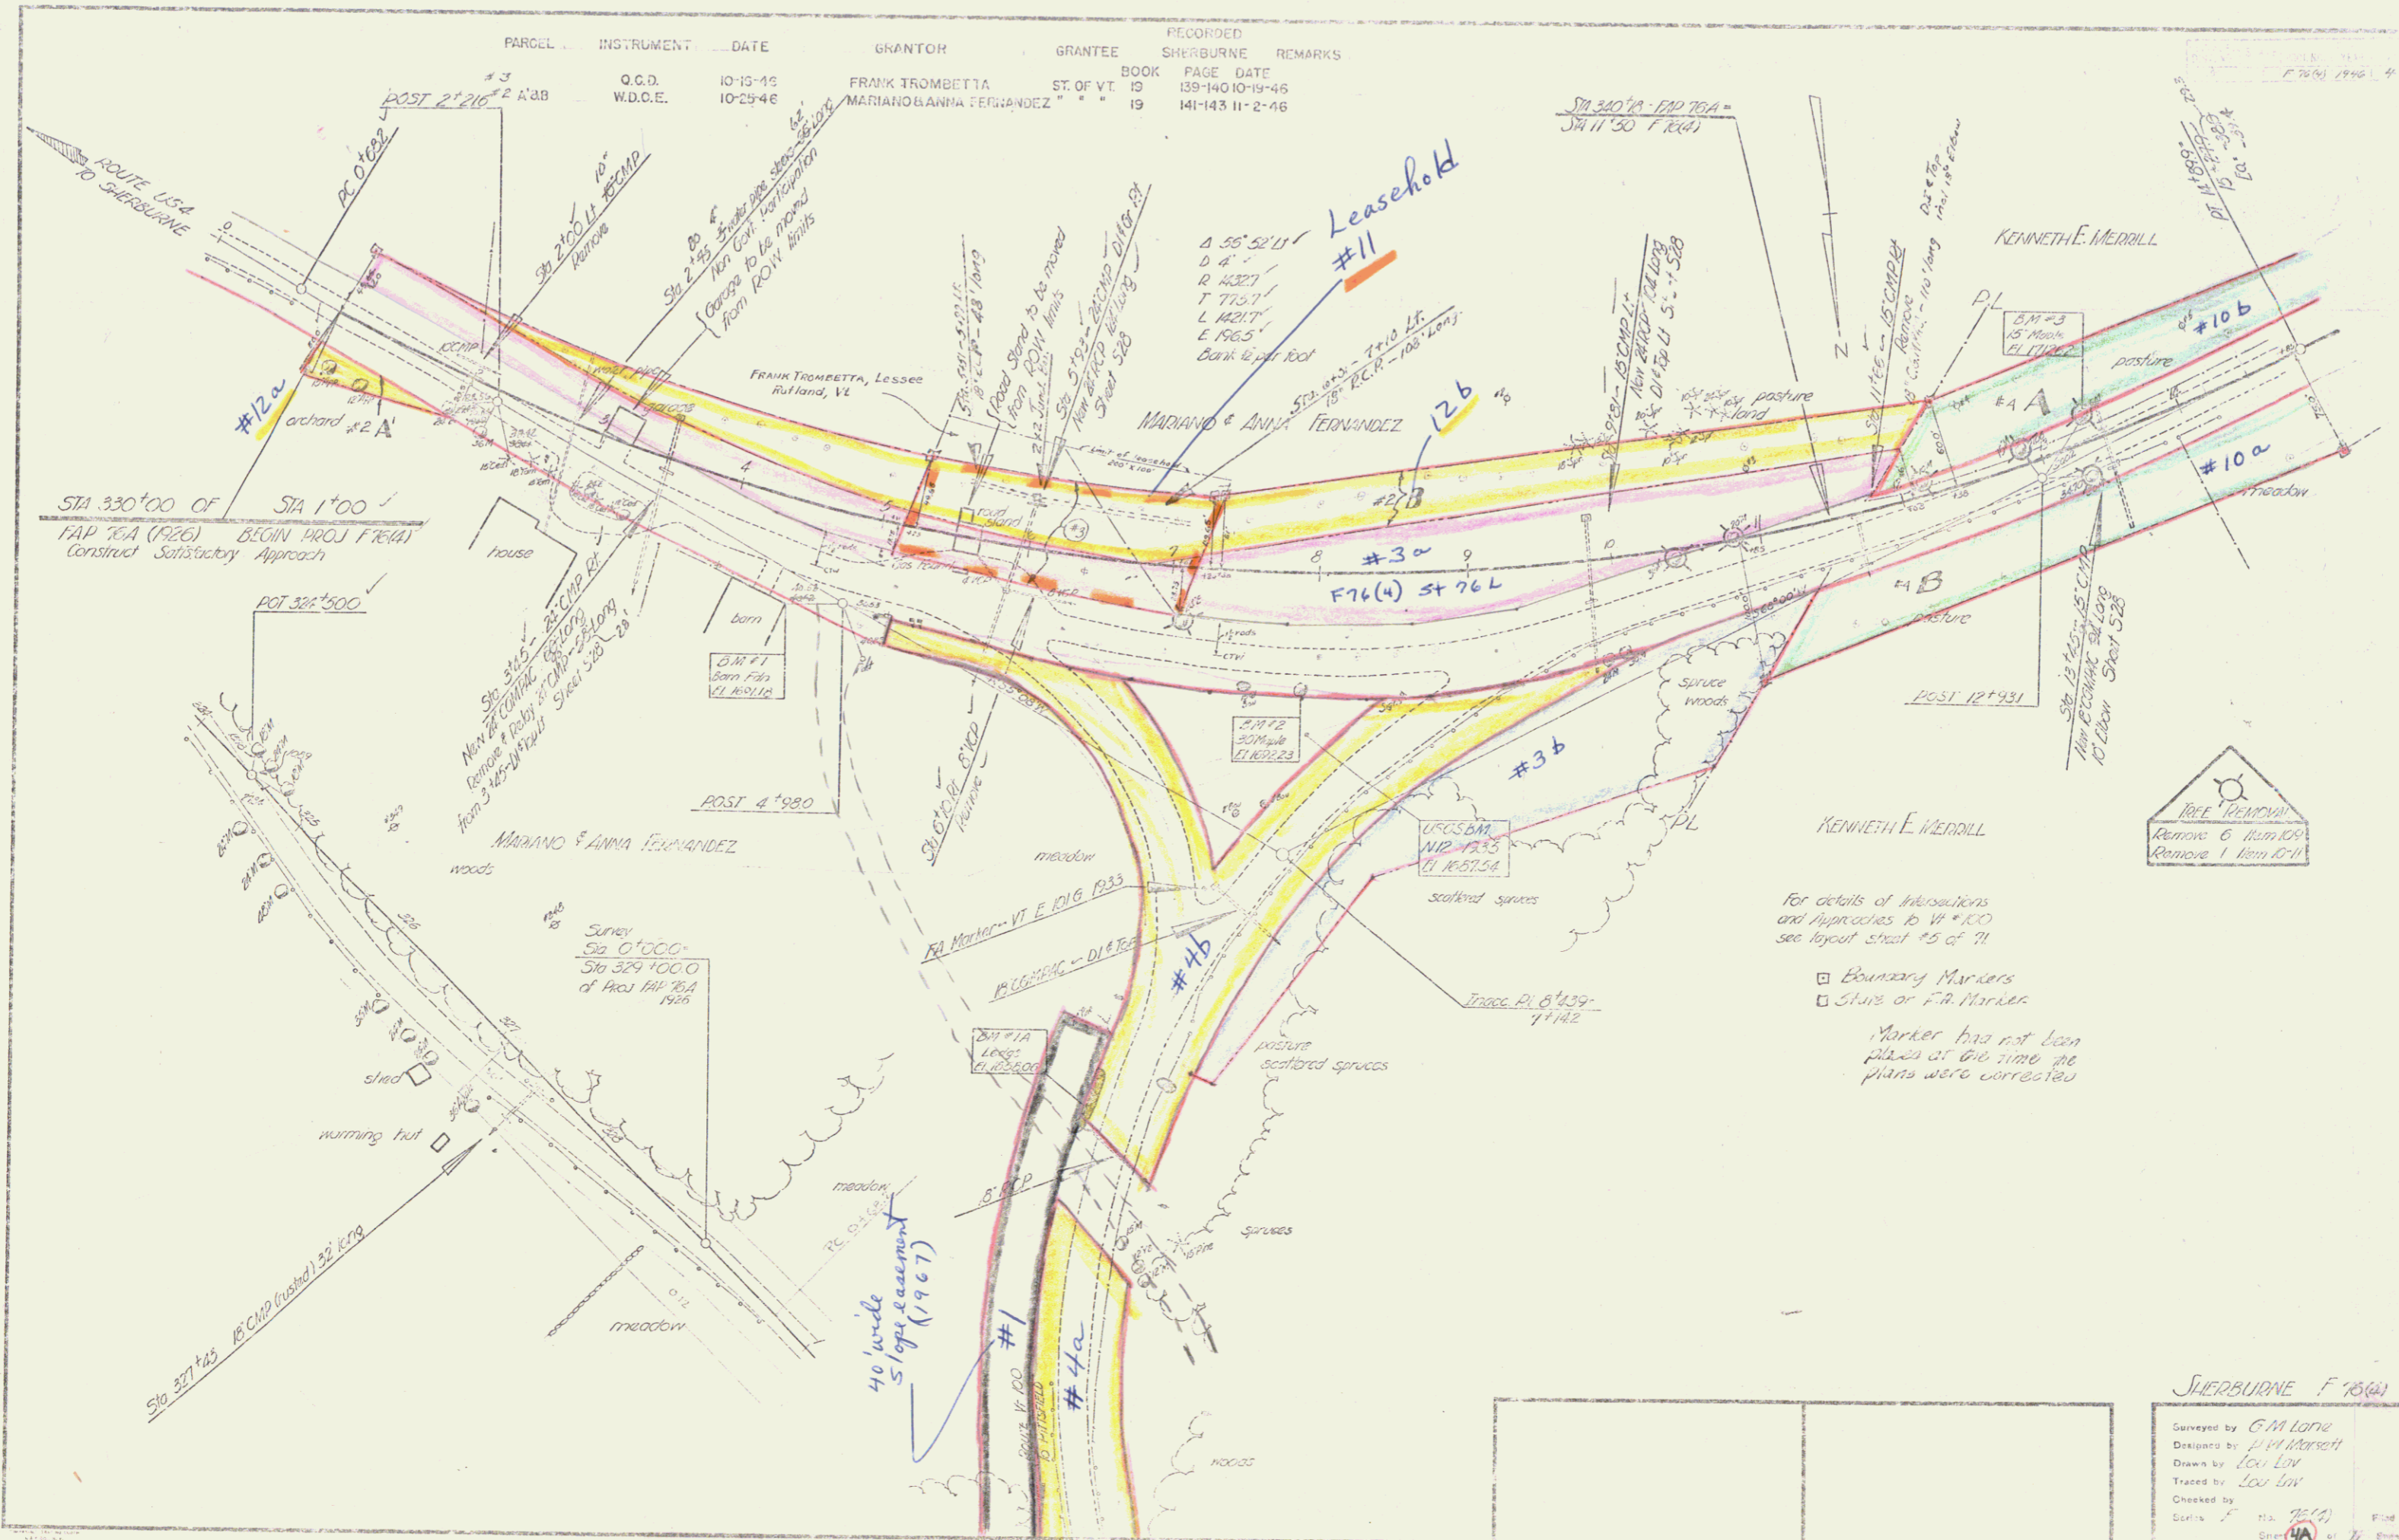

For details of Intersections and Approaches to Vt 100 see layout sheet #5 of 71


- Boundary Markers
- Stone or F.A. Marker

Marker has not been placed at this time the plans were corrected



SHERBURNE F 1864

Surveyed by G.M. Lane  
 Designed by J.W. Marslett  
 Drawn by Lou Lov  
 Traced by Lou Lov  
 Checked by  
 Scale: 1" = 100'  
 Sheet 11 of 11

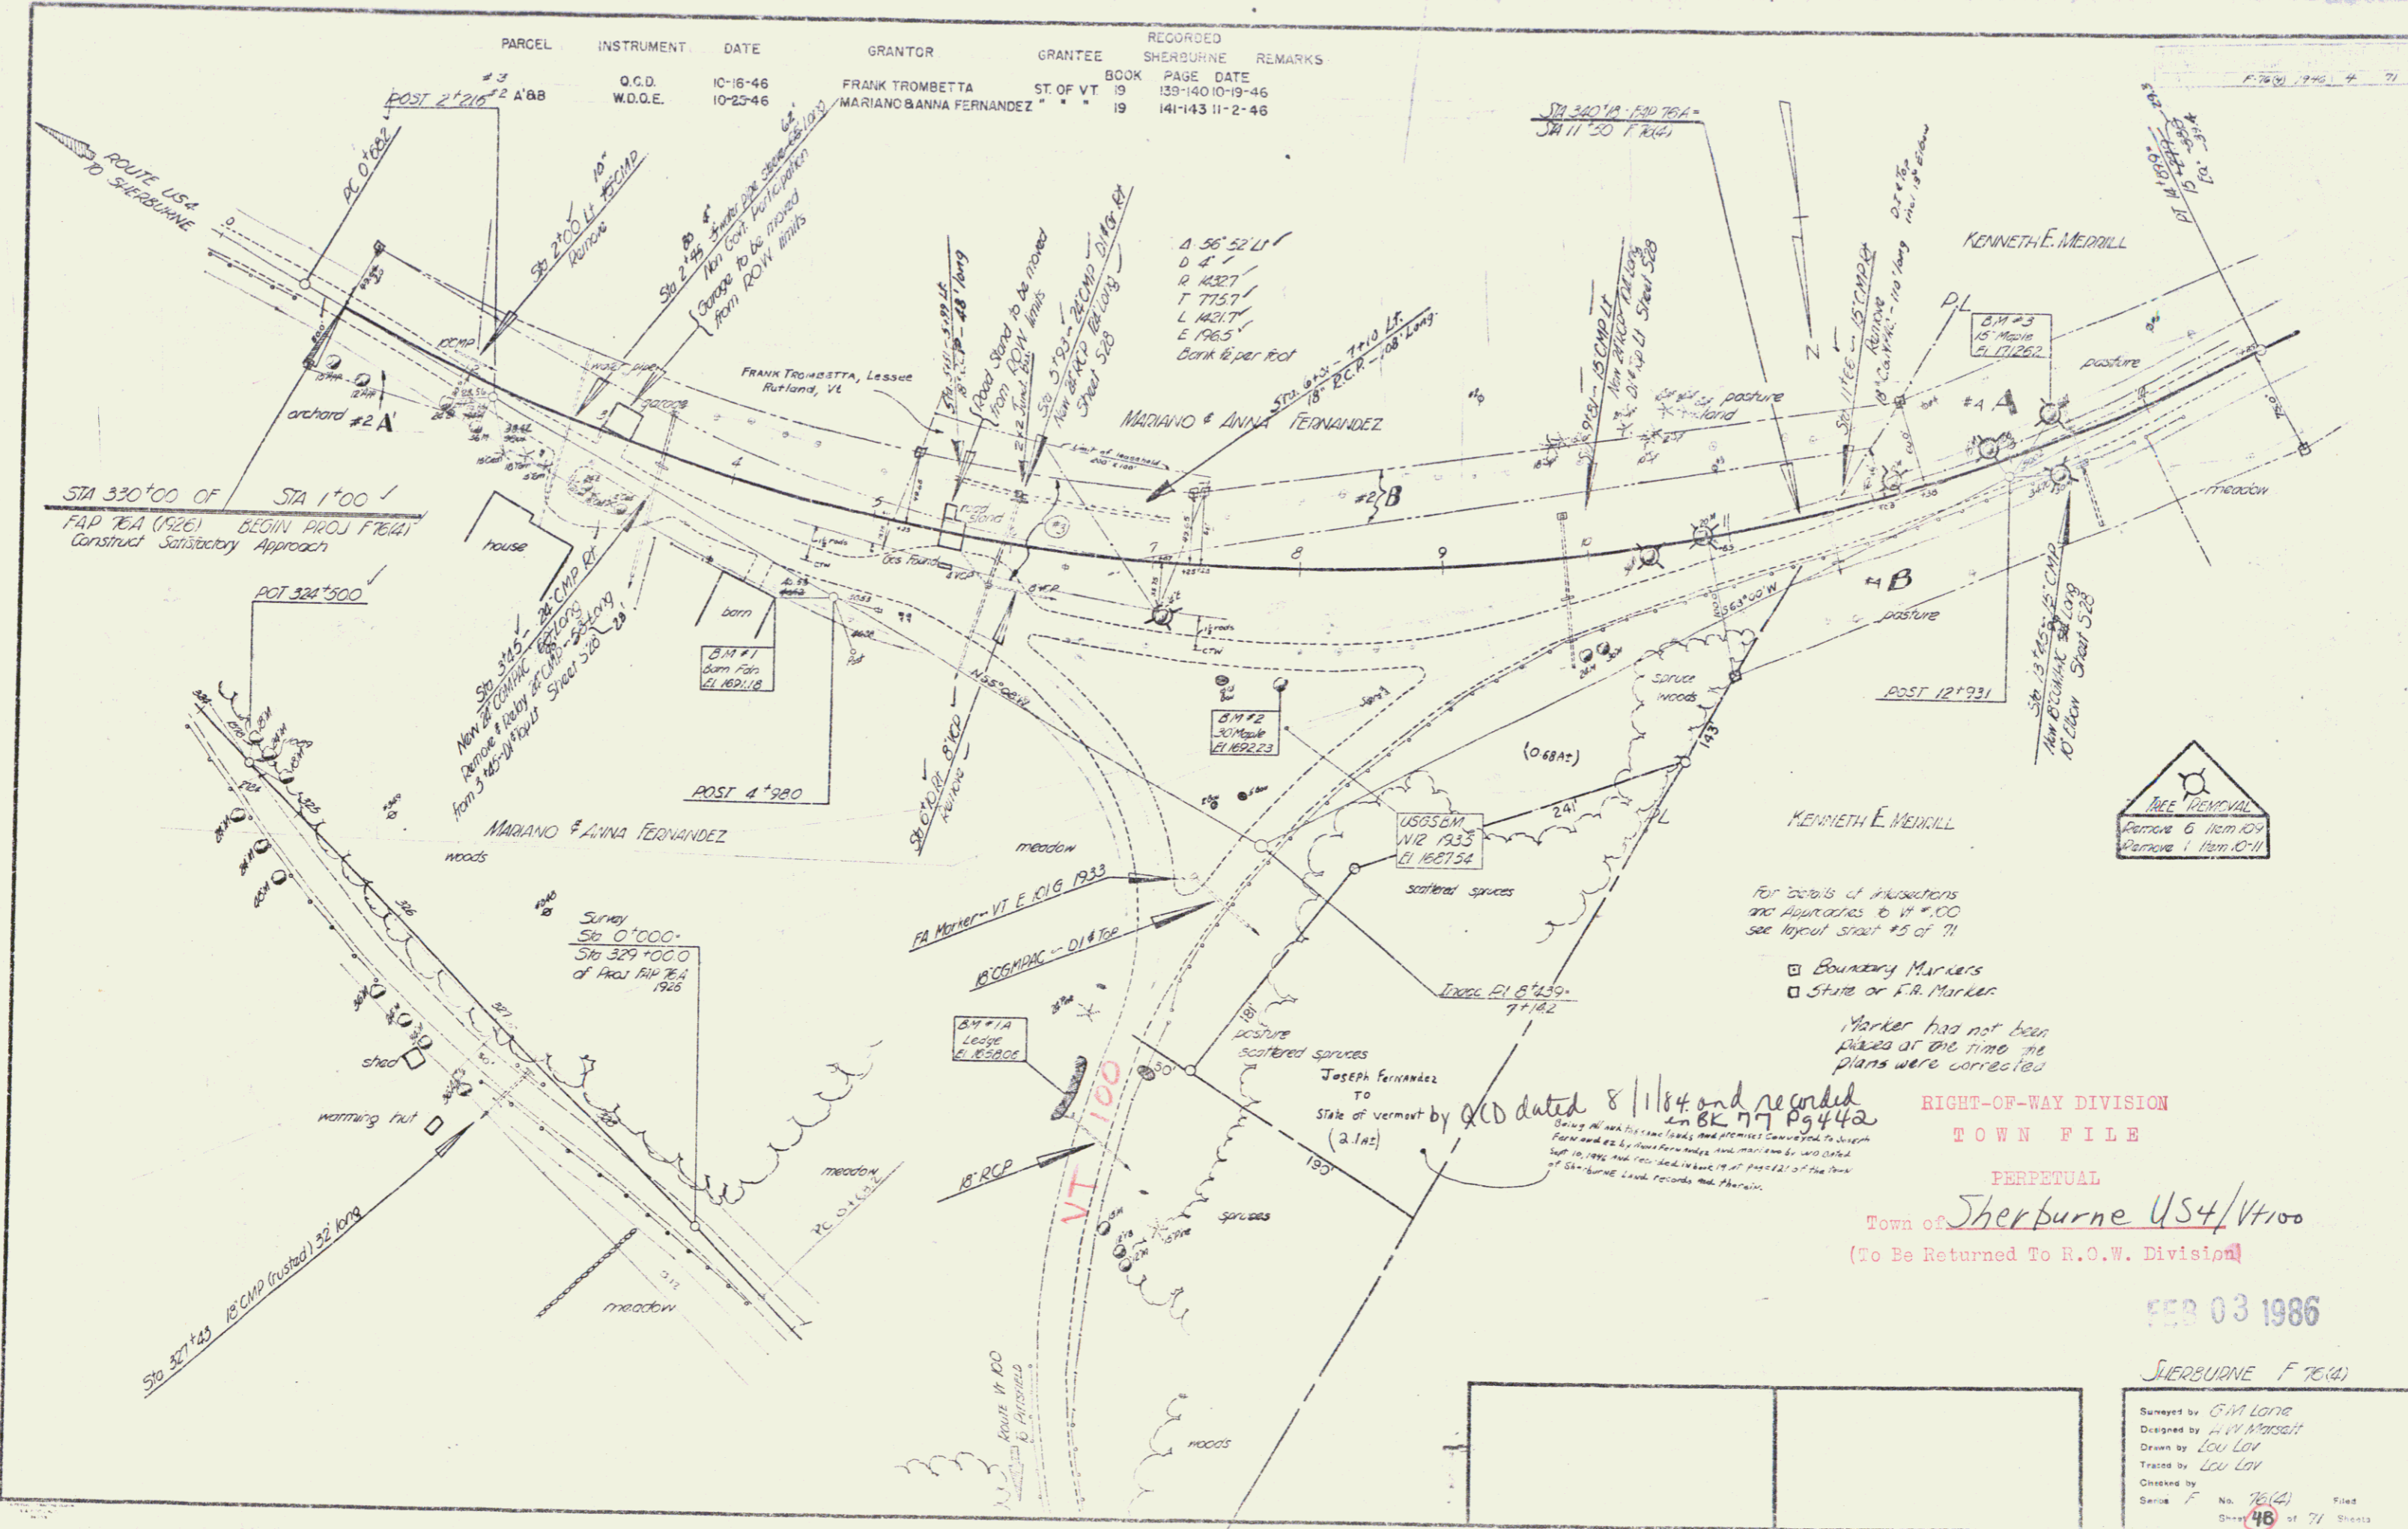

PARCEL	INSTRUMENT	DATE	GRANTOR	GRANTEE	RECORDED	REMARKS
#3	O.C.D.	10-16-46	FRANK TROMBETTA	ST. OF VT	BOOK 139-140	PAGE 10-19-46
#2	W.D.O.E.	10-23-46	MARIANO BANNA FERNANDEZ	"	BOOK 141-143	PAGE 11-2-46

For details of instructions and abbreviations to V.T. 100 see layout sheet #5 of 71

- Boundary Markers
- Stone or F.R. Marker

Marker has not been placed at this time the plans were corrected



Decided dated 8/1/84 and recorded on 8/17/84  
 Being all area shown on plan and premises conveyed to Joseph Fernandez by deed dated 8/1/84 and recorded on 8/17/84. The fee and interest in the land shown on plan and premises conveyed to Joseph Fernandez by deed dated 8/1/84 and recorded on 8/17/84. The fee and interest in the land shown on plan and premises conveyed to Joseph Fernandez by deed dated 8/1/84 and recorded on 8/17/84.


RIGHT-OF-WAY DIVISION  
 TOWN FILE  
 PERPETUAL  
 Town of Sherburne US4/Vt100  
 (To Be Returned To R.O.W. Division)

FEB 03 1986

SHERBURNE F 70(4)

Surveyed by G.M. Long  
 Designed by H.W. Marshall  
 Drawn by Lou Lov  
 Traced by Lou Lov  
 Checked by  
 Series F No. 70(4) Filed  
 Sheet 46 of 71 Sheets

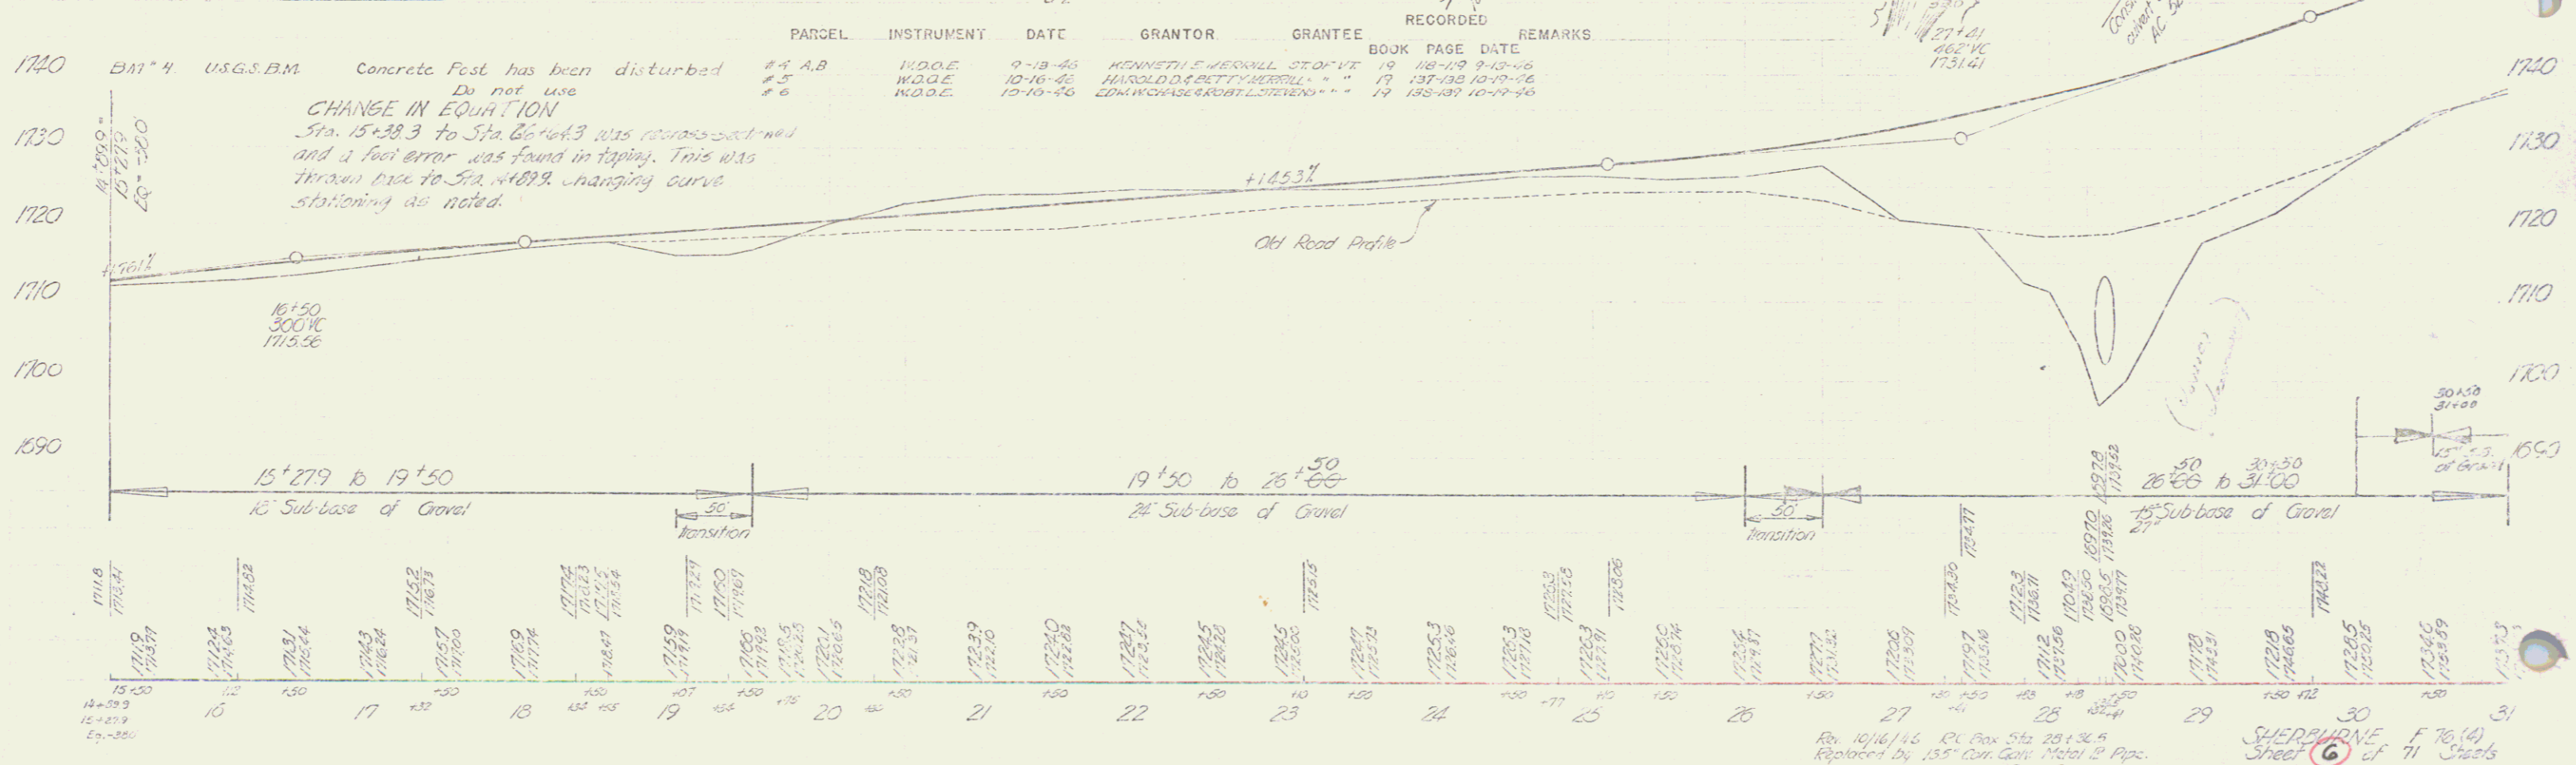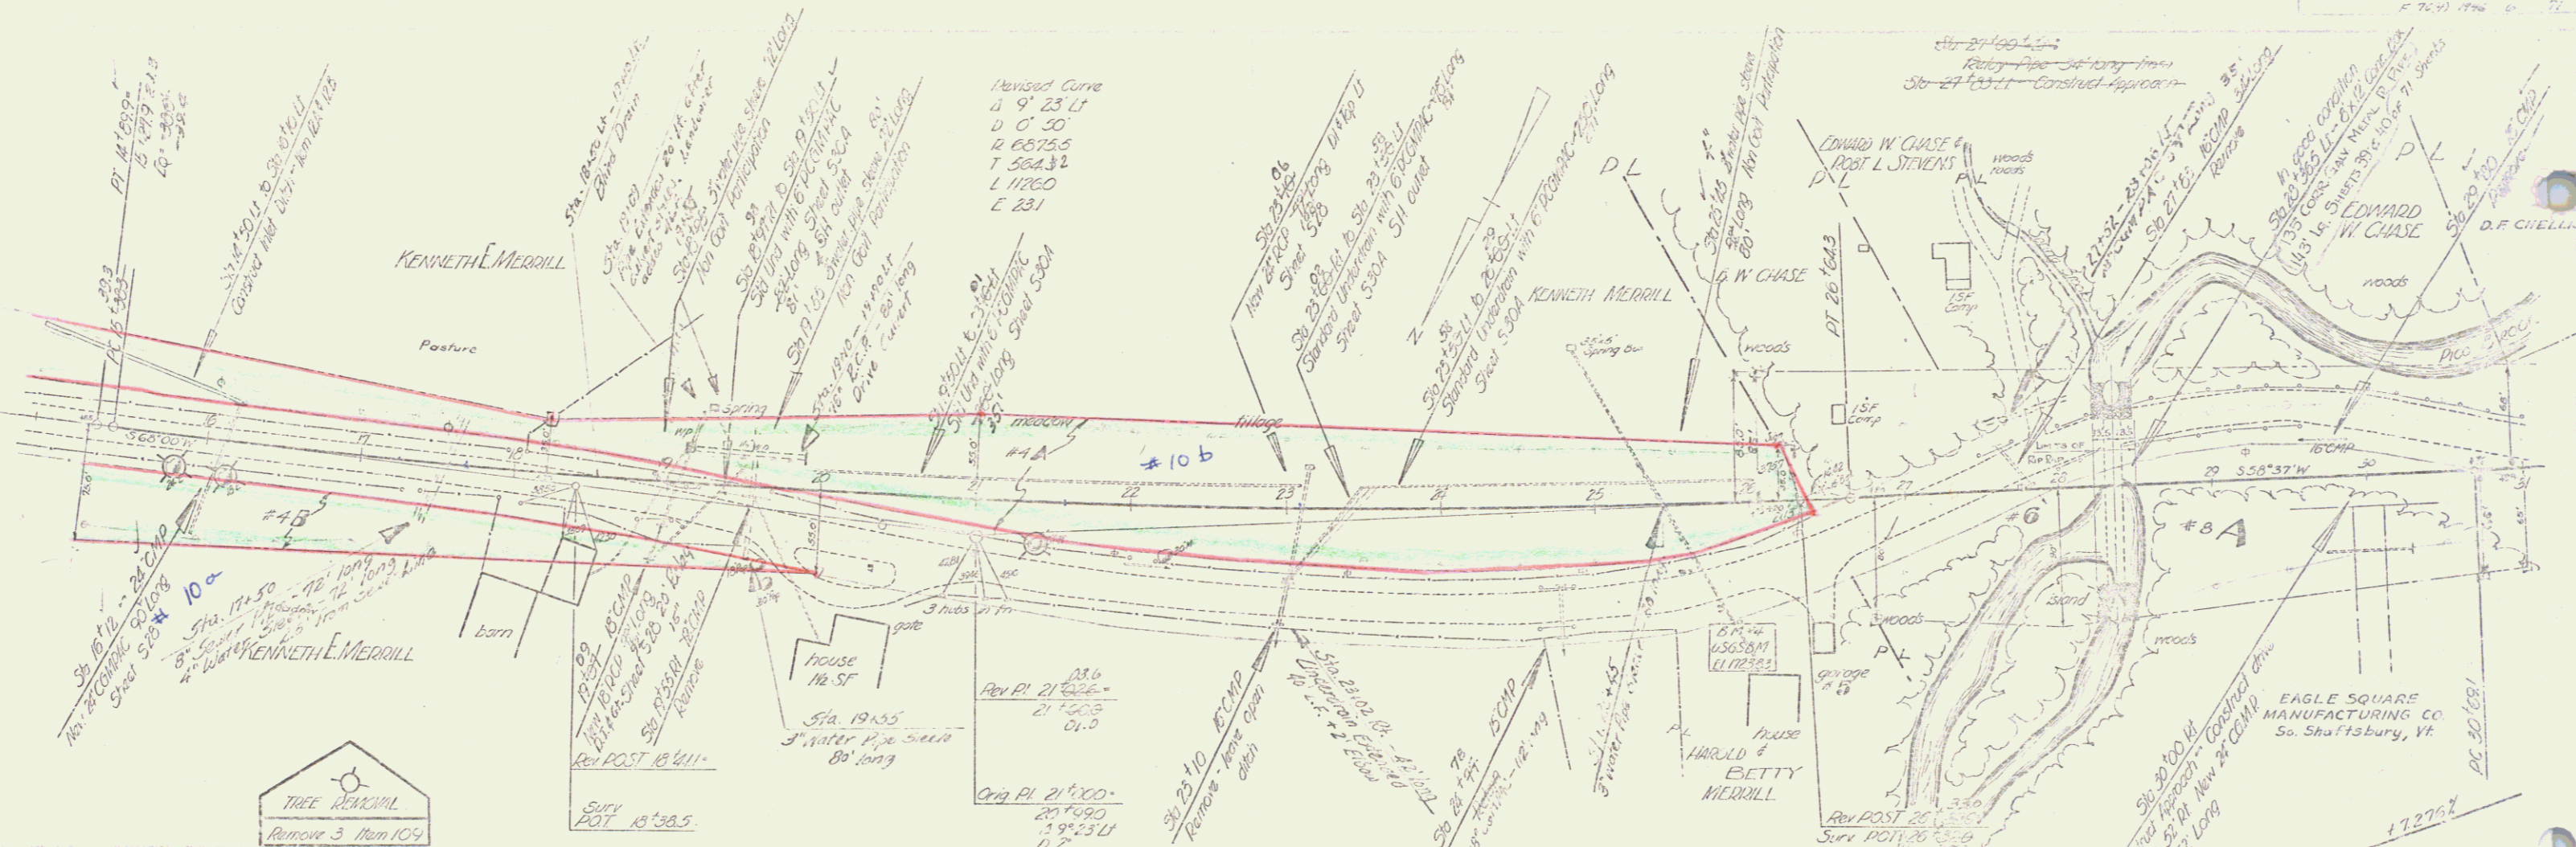


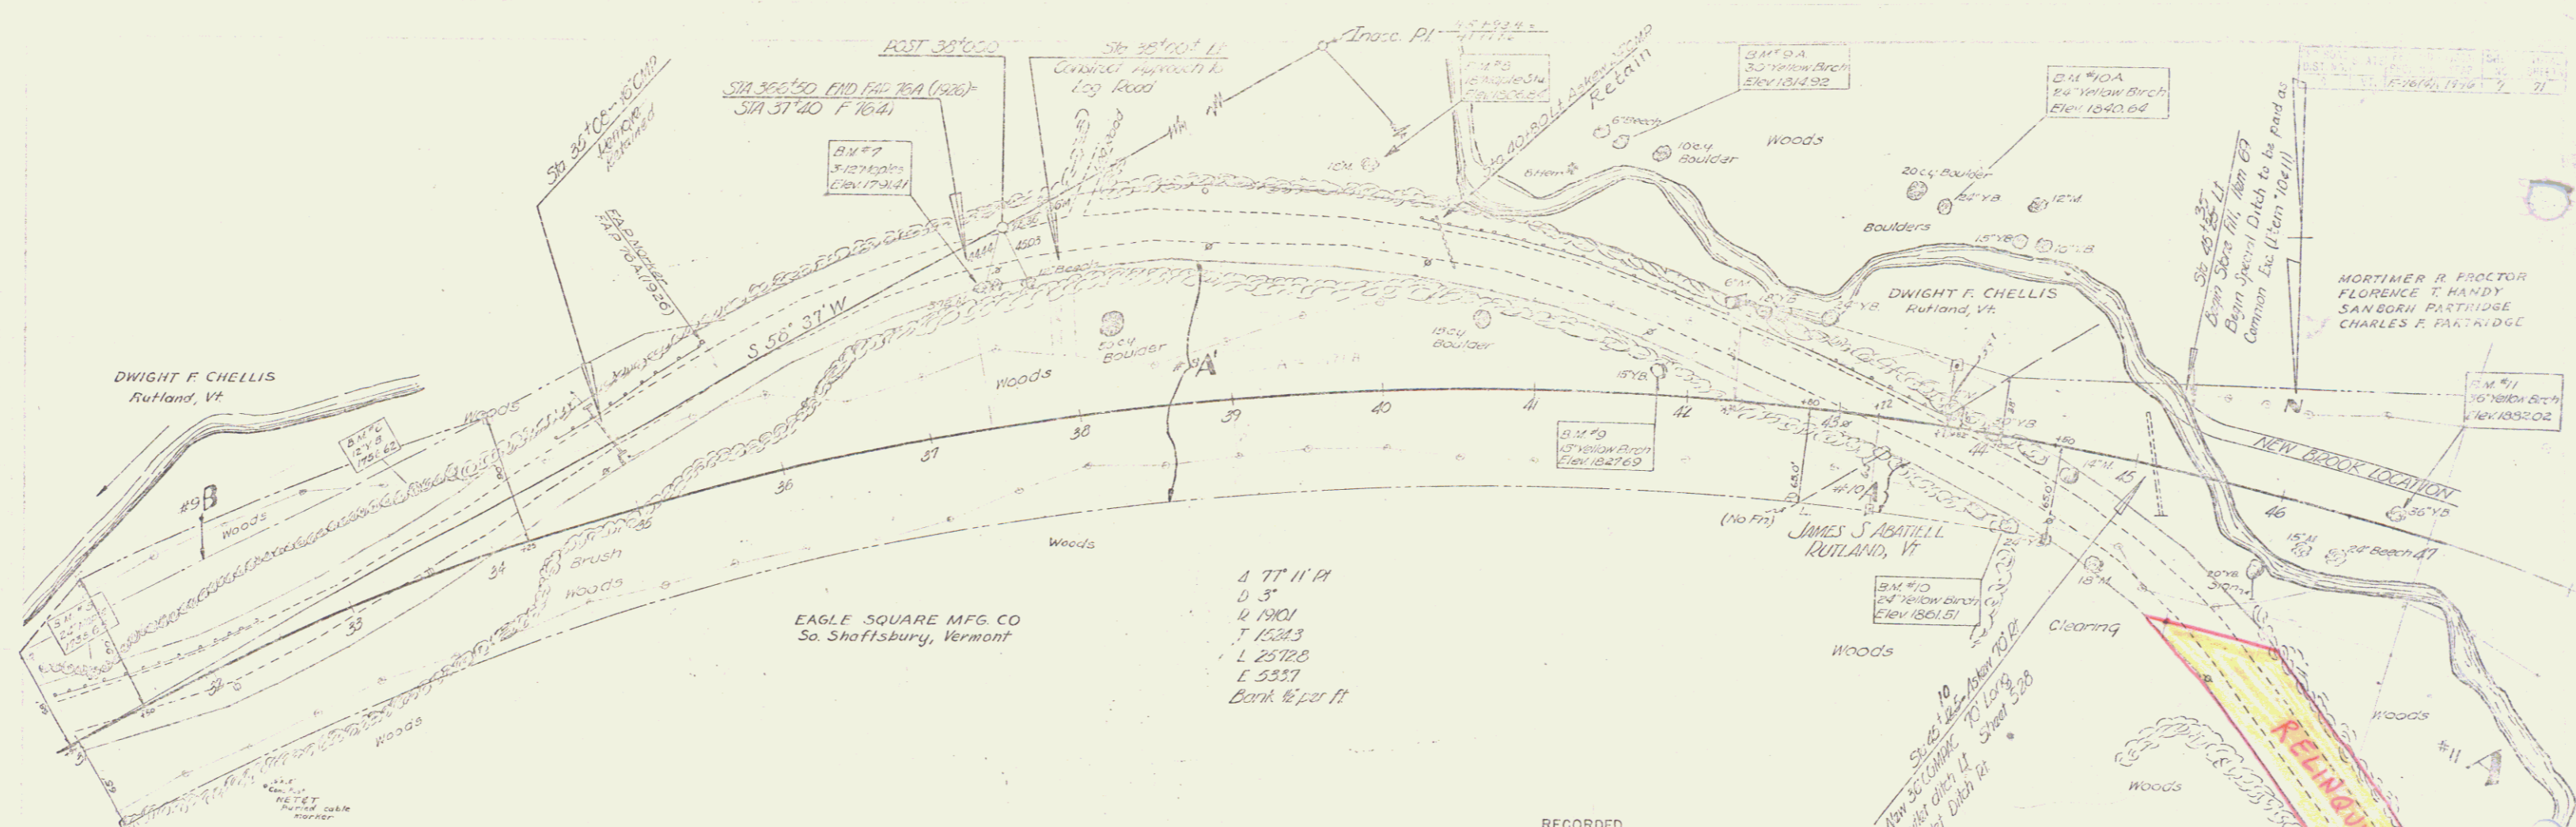


B.M. #5	S.12	24" Maple	29' Lt	Sta. 31 + 30	Elev 1738.65
B.M. #6	S.12	12" Yellow Birch	33' Lt	Sta. 33 + 71	Elev 1756.62
B.M. #7	S.12	3-12" Maples	33' Lt	Sta. 37 + 67	Elev 1791.41
B.M. #8	S.12	13" Maple	96' Lt	Sta. 40 + 13	Elev 1506.84
B.M. #9	S.12	15" Yellow Birch	12.5' Lt	Sta. 42 + 13	Elev 1827.69
B.M. #9A	S.12	30" Yellow Birch	6.5' Lt	Base Line 1 + 21	Elev 1814.92
B.M. #10	S.12	24" Yellow Birch	40.5' Lt	Sta. 44 + 72	Elev 1861.91
B.M. #10A	S.12	24" Yellow Birch	2' Lt	Base Line 3 + 40	Elev 1840.64
B.M. #11	S.12	36" Yellow Birch	70.5' Lt	Sta. 46 + 97	Elev 1882.02

PARCEL	INSTRUMENT	DATE	GRANTOR	GRANTEE	RECORDED	SHERBURNE	REMARKS
#9 B	W.D.O.E.	10-16-46	DWIGHT F. CHELLIS	ST OF VT.	19	140-141	10-18-46
#e A	CORR. W.D.O.E.	11-7-46	EAGLE SQUARE MFG. CO.		19	143-144	11-16-46

9-46  
1-46  
L. Jones  
L. Jones

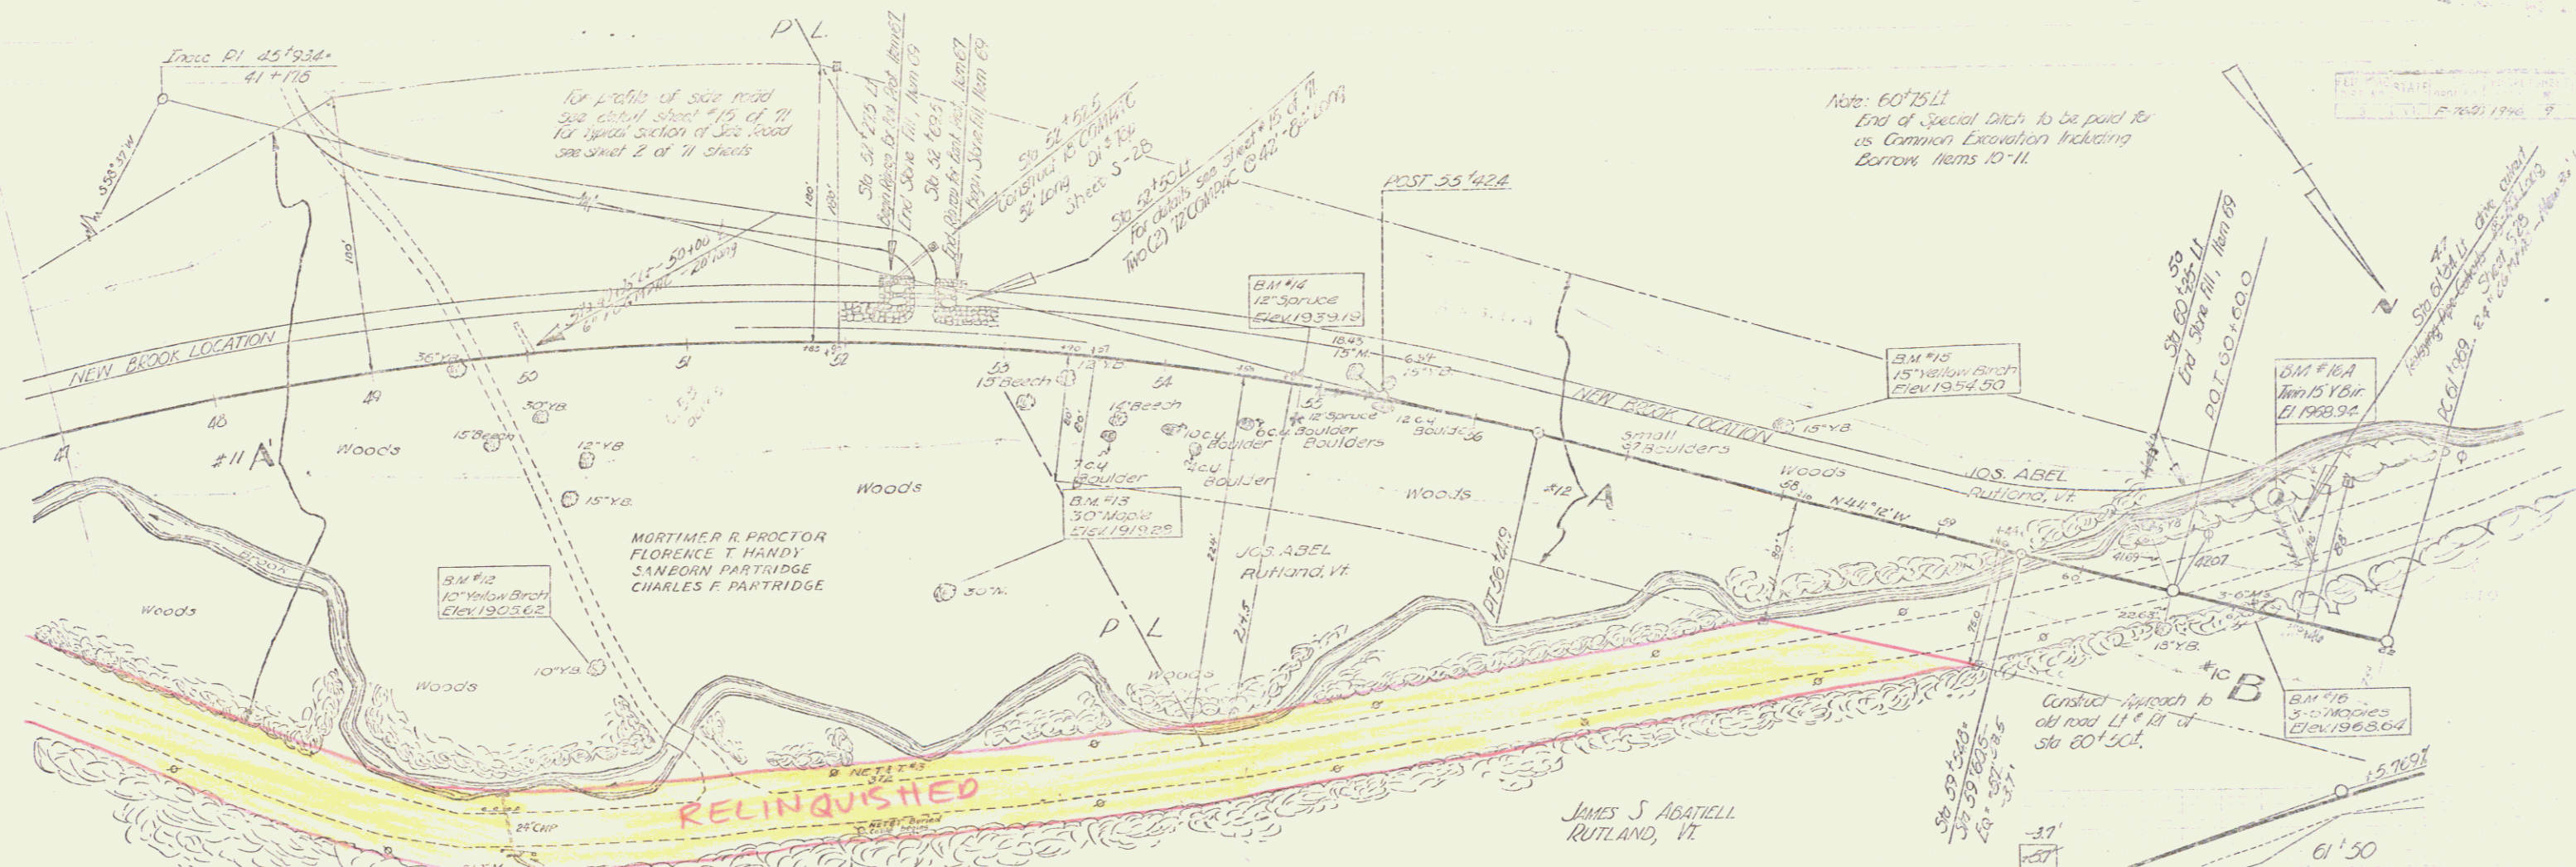

1960	PARCEL	INSTRUMENT	DATE	GRANTOR	GRANTEE	RECORDED SHERBURNE BOOK PAGE DATE	REMARKS
	#12A	WD.O.E.	9-18-46	JOS. A. ABEL	STOF VT.	19 136-137 10-19-46	
	#11A	Q.G.D.	11-29-46	FLORENCE T. HANDY, MORTIMER R. PROCTOR, SANBORN & CHARLES F. PARTRIDGE		19 155-157 1-11-47	

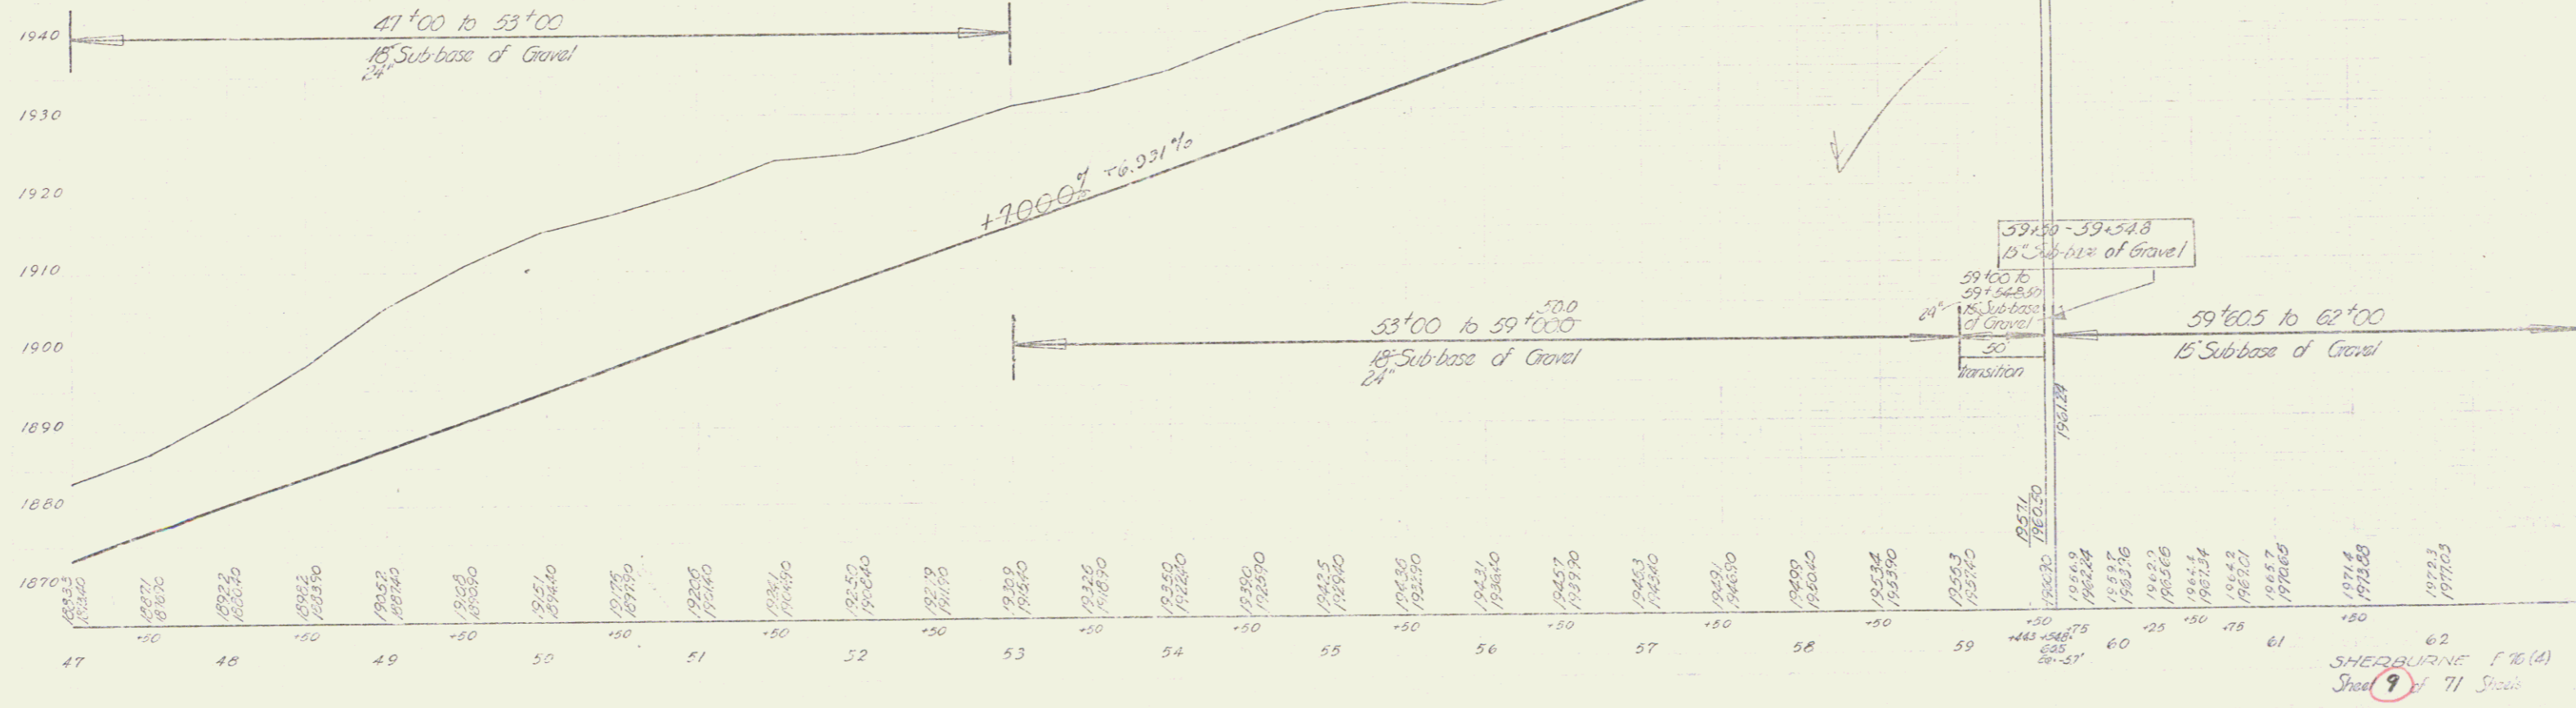


- B.M. #12 S.I.R. 10" Yellow Birch 110' Lt. Sta 50+45 Elev 1905.62
- B.M. #13 S.I.R. 30" Maple 82' Lt. Sta 52+75 Elev 1919.28
- B.M. #14 S.I.R. 12" Spruce 17' Lt. Sta 54+97 Elev 1939.19
- B.M. #15 S.I.R. 15" Yellow Birch 43' Lt. Sta 58+10 Elev 1954.50
- B.M. #16 S.I.R. 3" Maple 15' Sta 61+02 Elev 1968.64
- B.M. #16A S.I.R. 2-15" Yellow Birches 71' Lt. Sta 61+12 Elev 1960.92

SHERBURNE F 70 (A)  
Sheet 9 of 71 Sheets


PARCEL	INSTRUMENT	DATE	GRANTOR	GRANTEE	BOOK	PAGE	RECORDED SHERBURNE DATE	REMARKS
#70 ABB	W.D.O.E.	9-18-46	JAMES S. ABATIELL	ST. OF VT.	19	135-136	10-18-46	

$\Delta 53'44" LI$   
 $D 3'$   
 $R 190.1$   
 $T 985.6$   
 $L 173.11$   
 $E 23.11$   
 Bank  $\frac{1}{2}$  per ft except truck  
 lane 10' bank  $\frac{1}{2}$  per ft.

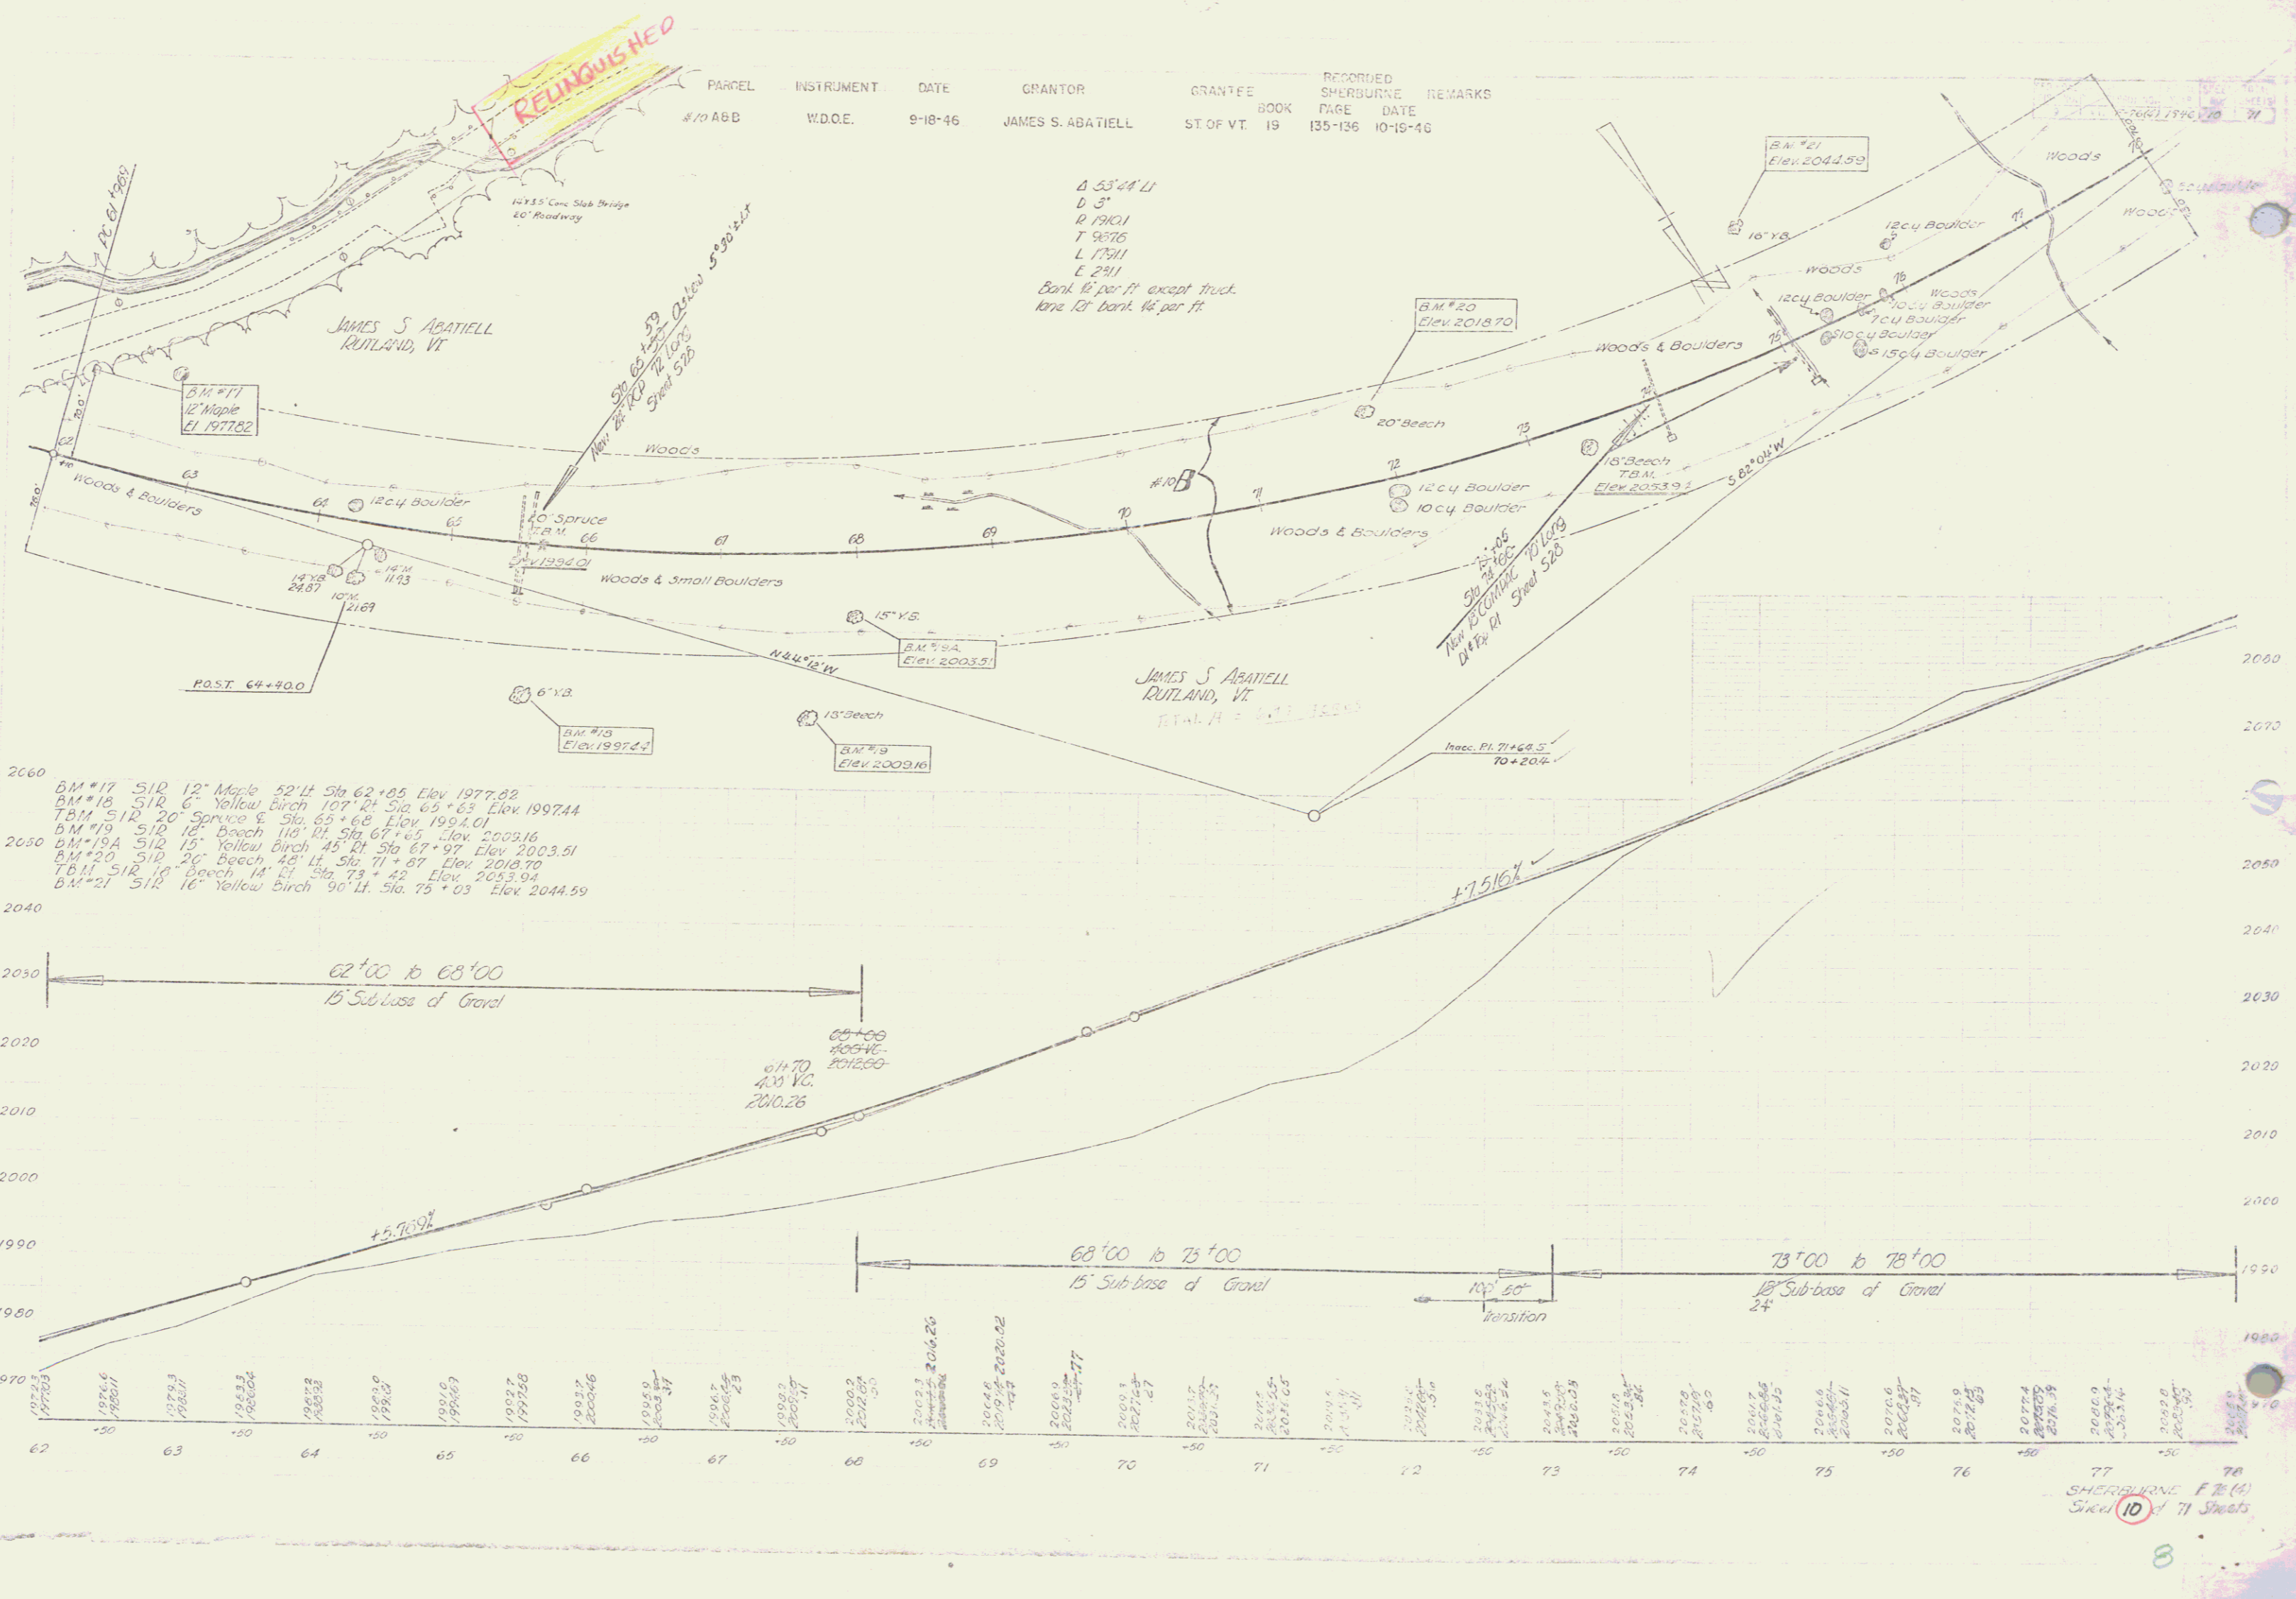


SHERBURNE FILE #1  
Sheet 10 of 71 Sheets

PARCEL	INSTANT	DATE	GRANTOR	GRANTEE	RECORDED SHEET-BURNS BOOK PAGE DATE	REMARKS
13A	OOD	1-8-47	MORTIMER R. PROCTOR ST. OF VI	GREEN MTN. CLUB, INC.	19 157-18 1-11-47	
13A	CORR WDOE	1-6-47	MORTIMER R. PROCTOR ST. OF VI	GREEN MTN. CLUB, INC.	19 158-50 1-23-47	

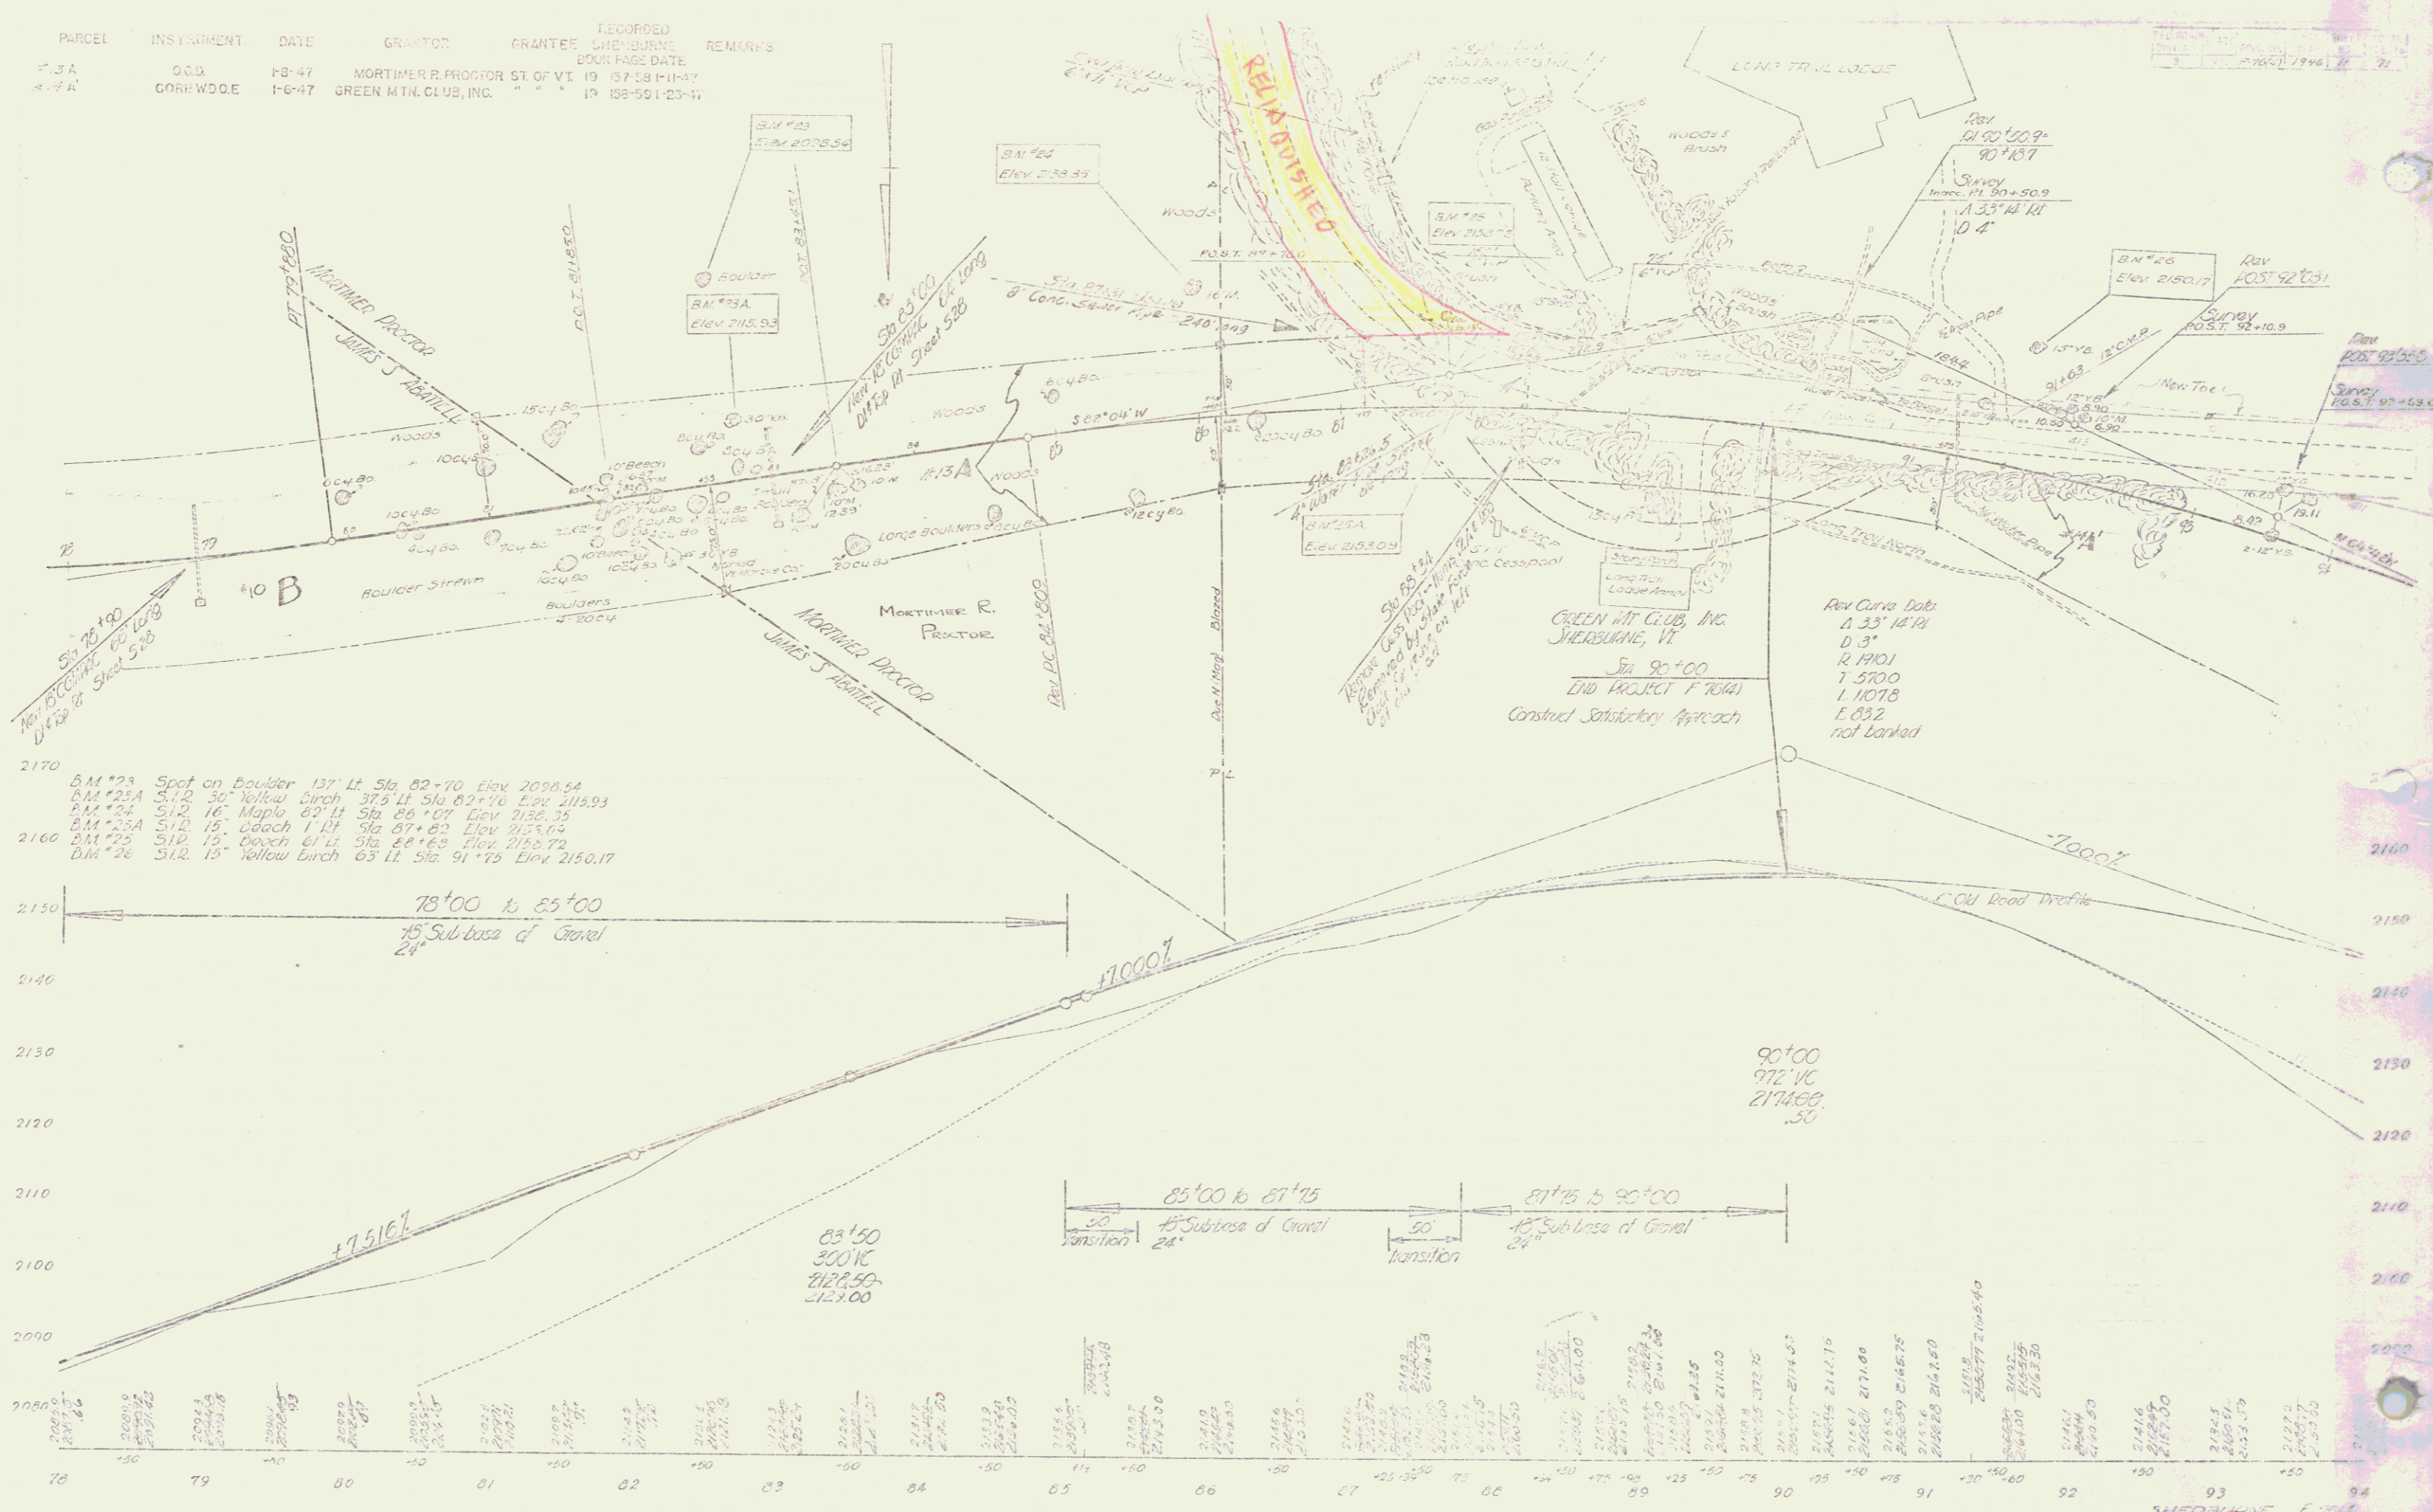

2170

BM*23	Spot on Boulder	137' Lt Sta. 82+70	Elev. 2098.54
BM*23A	S1/2 30' Yellow Birch	37.5' Lt Sta. 82+70	Elev. 2115.93
BM*24	S1/2 16' Maple	42' Lt Sta. 80+07	Elev. 2158.35
BM*25A	S1/2 15' Doach 1 Lt	Sta. 87+80	Elev. 2157.63
BM*25	S1/2 15' Doach 6 Lt	Sta. 88+69	Elev. 2156.72
BM*26	S1/2 15' Yellow Birch	63' Lt Sta. 91+75	Elev. 2150.17

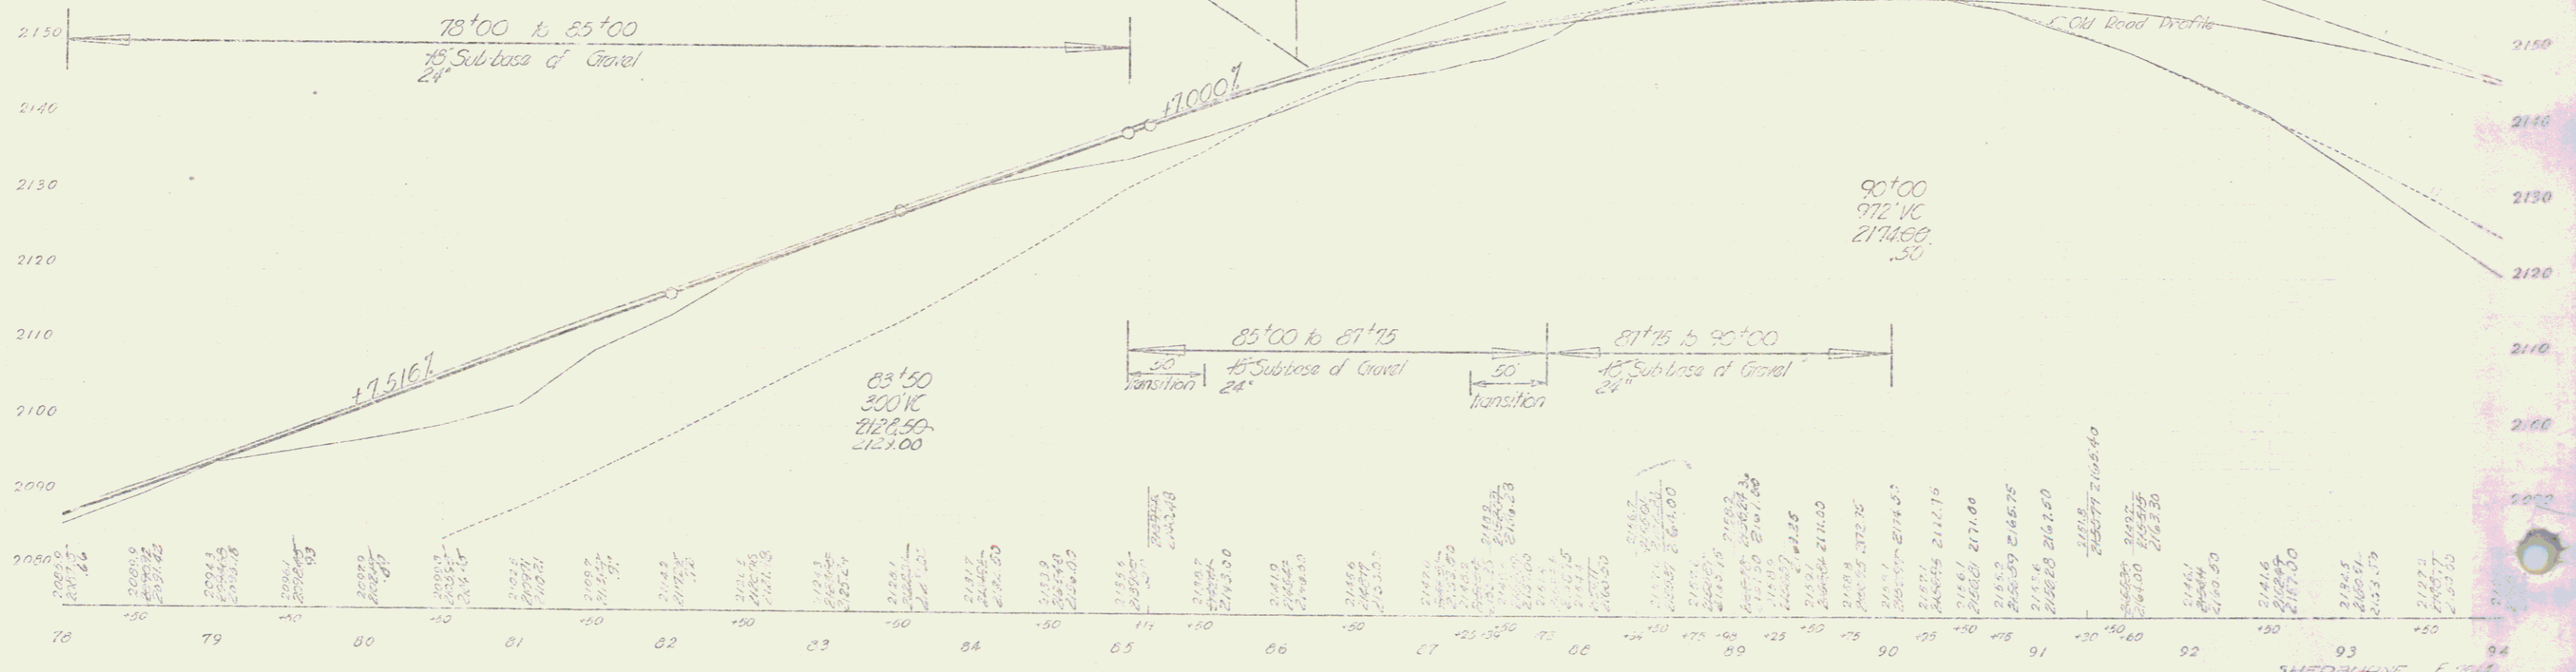

78+00 to 85+00  
 15' Subbase of Gravel  
 24"

85+00 to 87+75  
 15' Subbase of Gravel  
 24"

87+75 to 90+00  
 15' Subbase of Gravel  
 24"

90+00  
 972 VC  
 2174.60  
 .50

90+00  
 1.33' R  
 10.4'

92+00  
 1.33' R  
 10.4'

94+00  
 1.33' R  
 10.4'

SHERRBURNE F. 1211  
 Sheet 11 of 11 Sheets