
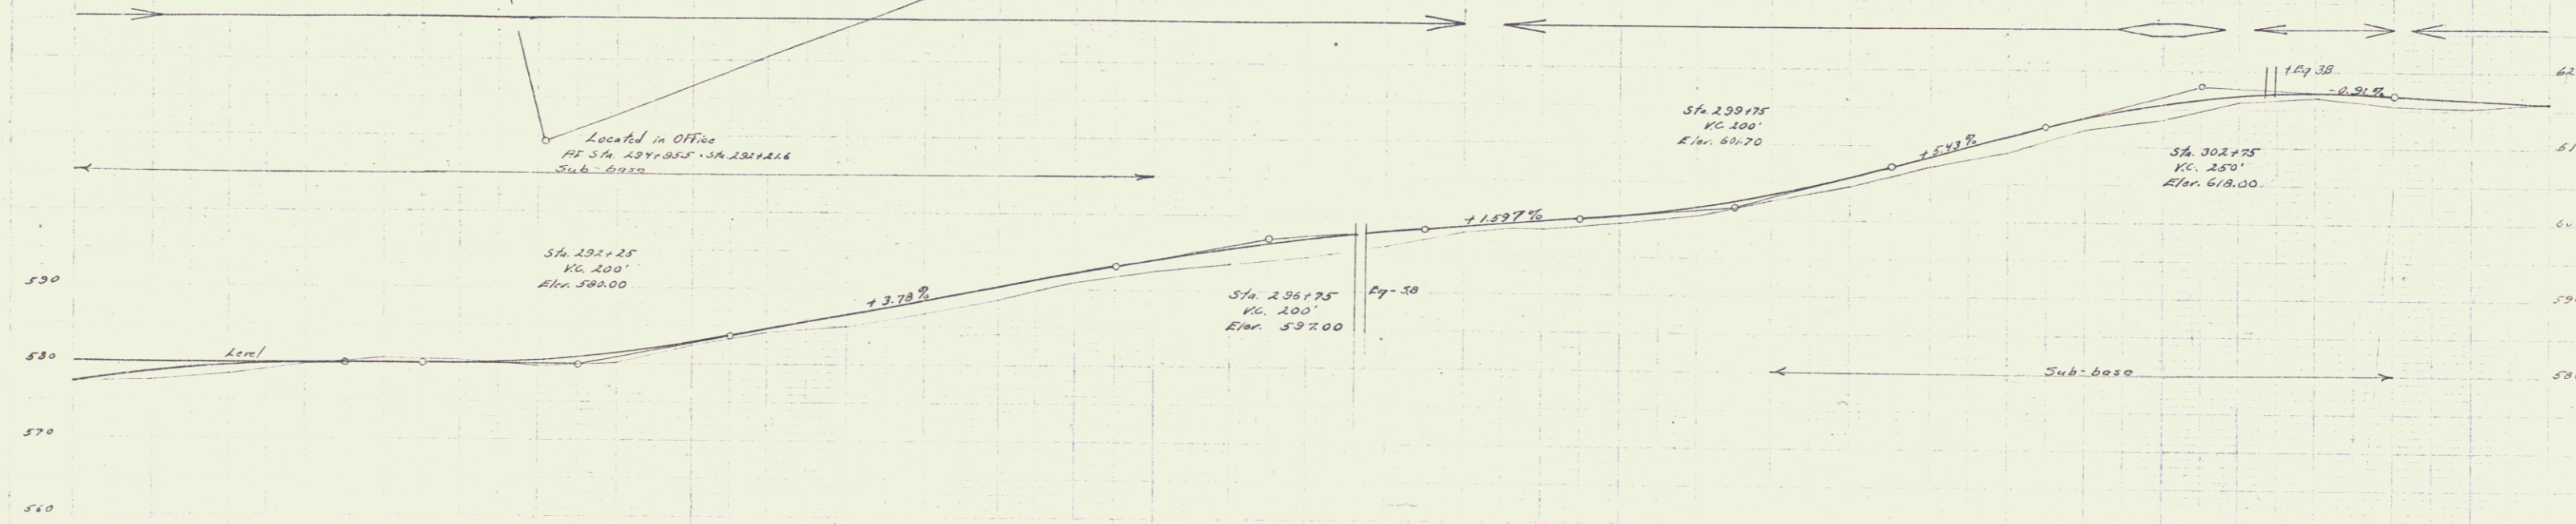


WOODEN GUARD RAIL REQUIRED
 ON LEFT
 Sta. 298+17 To Sta. 298+41 Length 24 FT.
 ON RIGHT
 Sta. 292+72 To Sta. 301+90 Length 1148 FT.
 TOTAL THIS SHEET 1192 FT.

NEW CULVERTS REQUIRED
 Sta. 298+29 18" Corc. Iron Pipe Length 34' Sta. 293+00 To Sta. 296+100 Length 700 FT.
 1-2 1/2" S Concrete 18 Cu. Yds. Sta. 300+00 To Sta. 301+00 Length 700 FT.

SUB-BASE REQUIRED

Scale: 1" = 40' (Horizontal), 1" = 10' (Vertical)
 Date: 7/24/49
 Sheet: 7 of 49

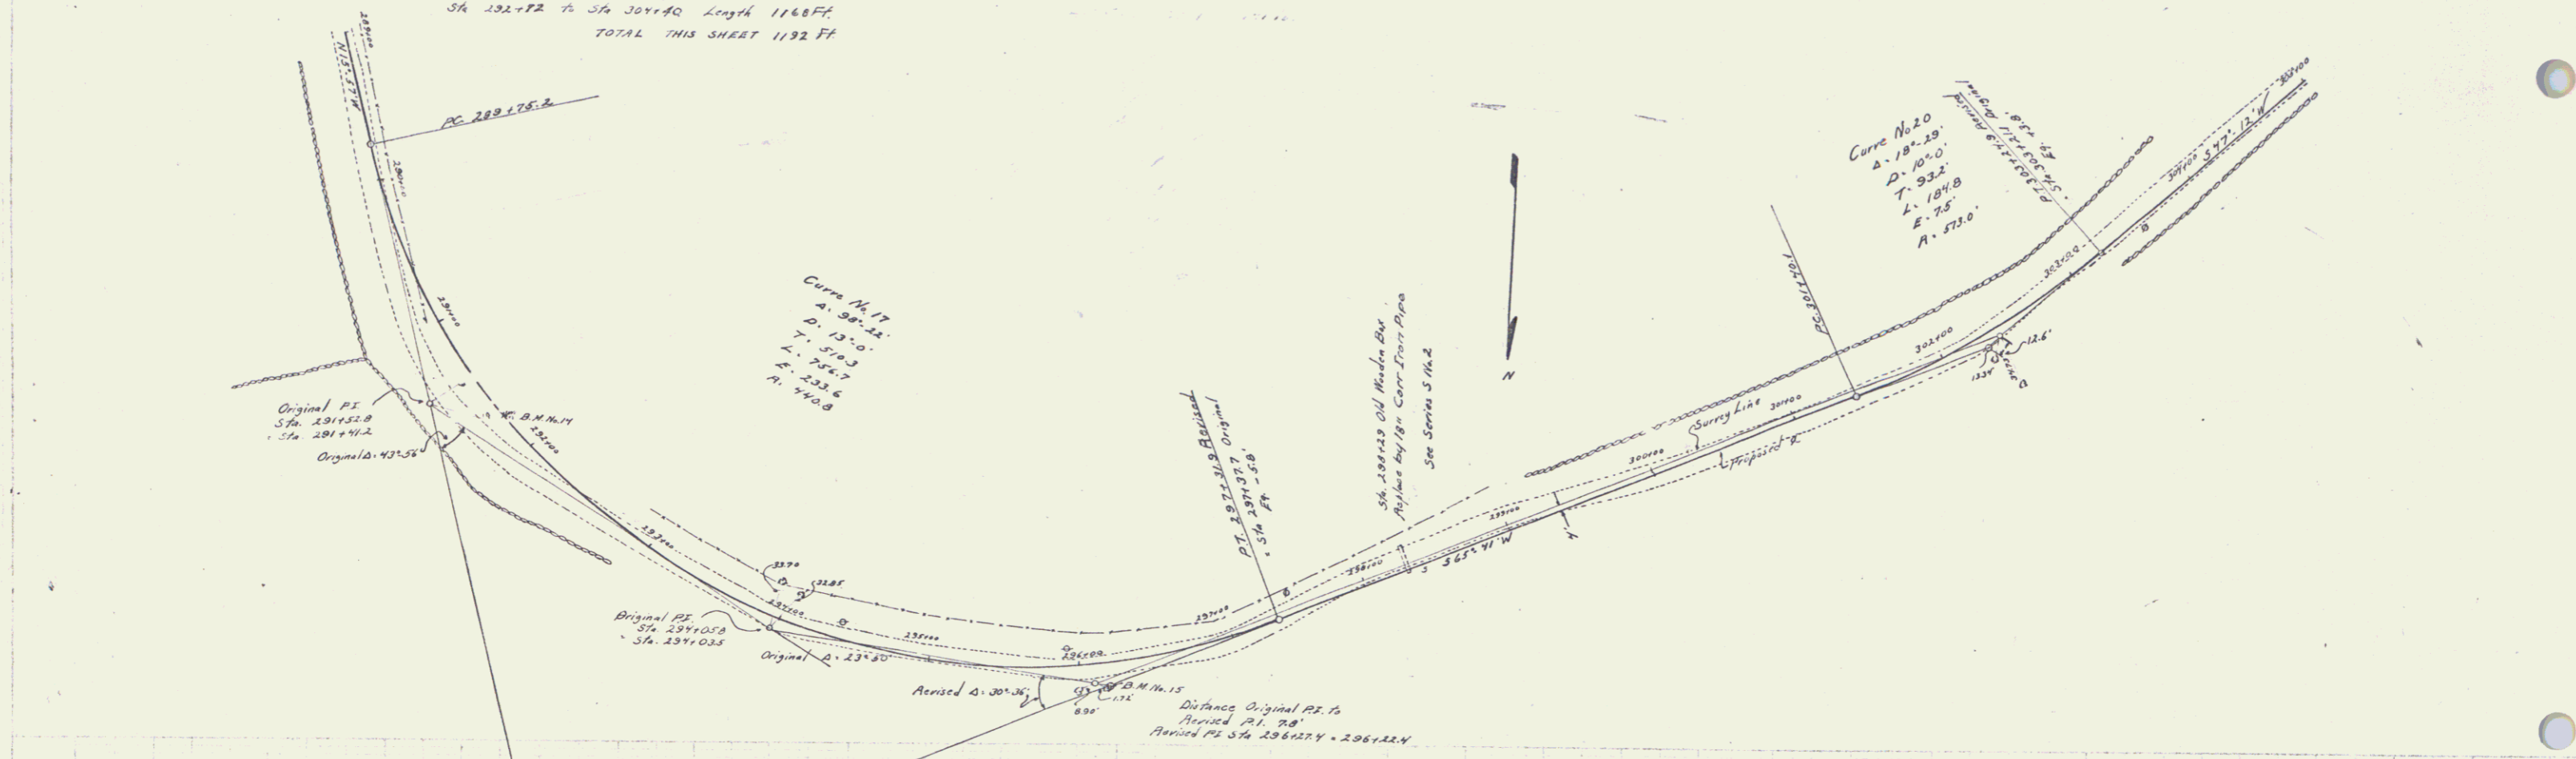

Station	Elevation	Notes
297+00	580.00	B.M. 14
297+10	580.00	
297+20	580.00	
Series E. N. 364
 Sheet 7 of 49