


PLAN
 DATE: 3-31-52
 DRAWN BY: ABBBY
 CHECKED BY: ABBBY
 SCALE: AS SHOWN

PROFILE
 DATE: 3-31-52
 DRAWN BY: ABBBY
 CHECKED BY: ABBBY
 SCALE: AS SHOWN

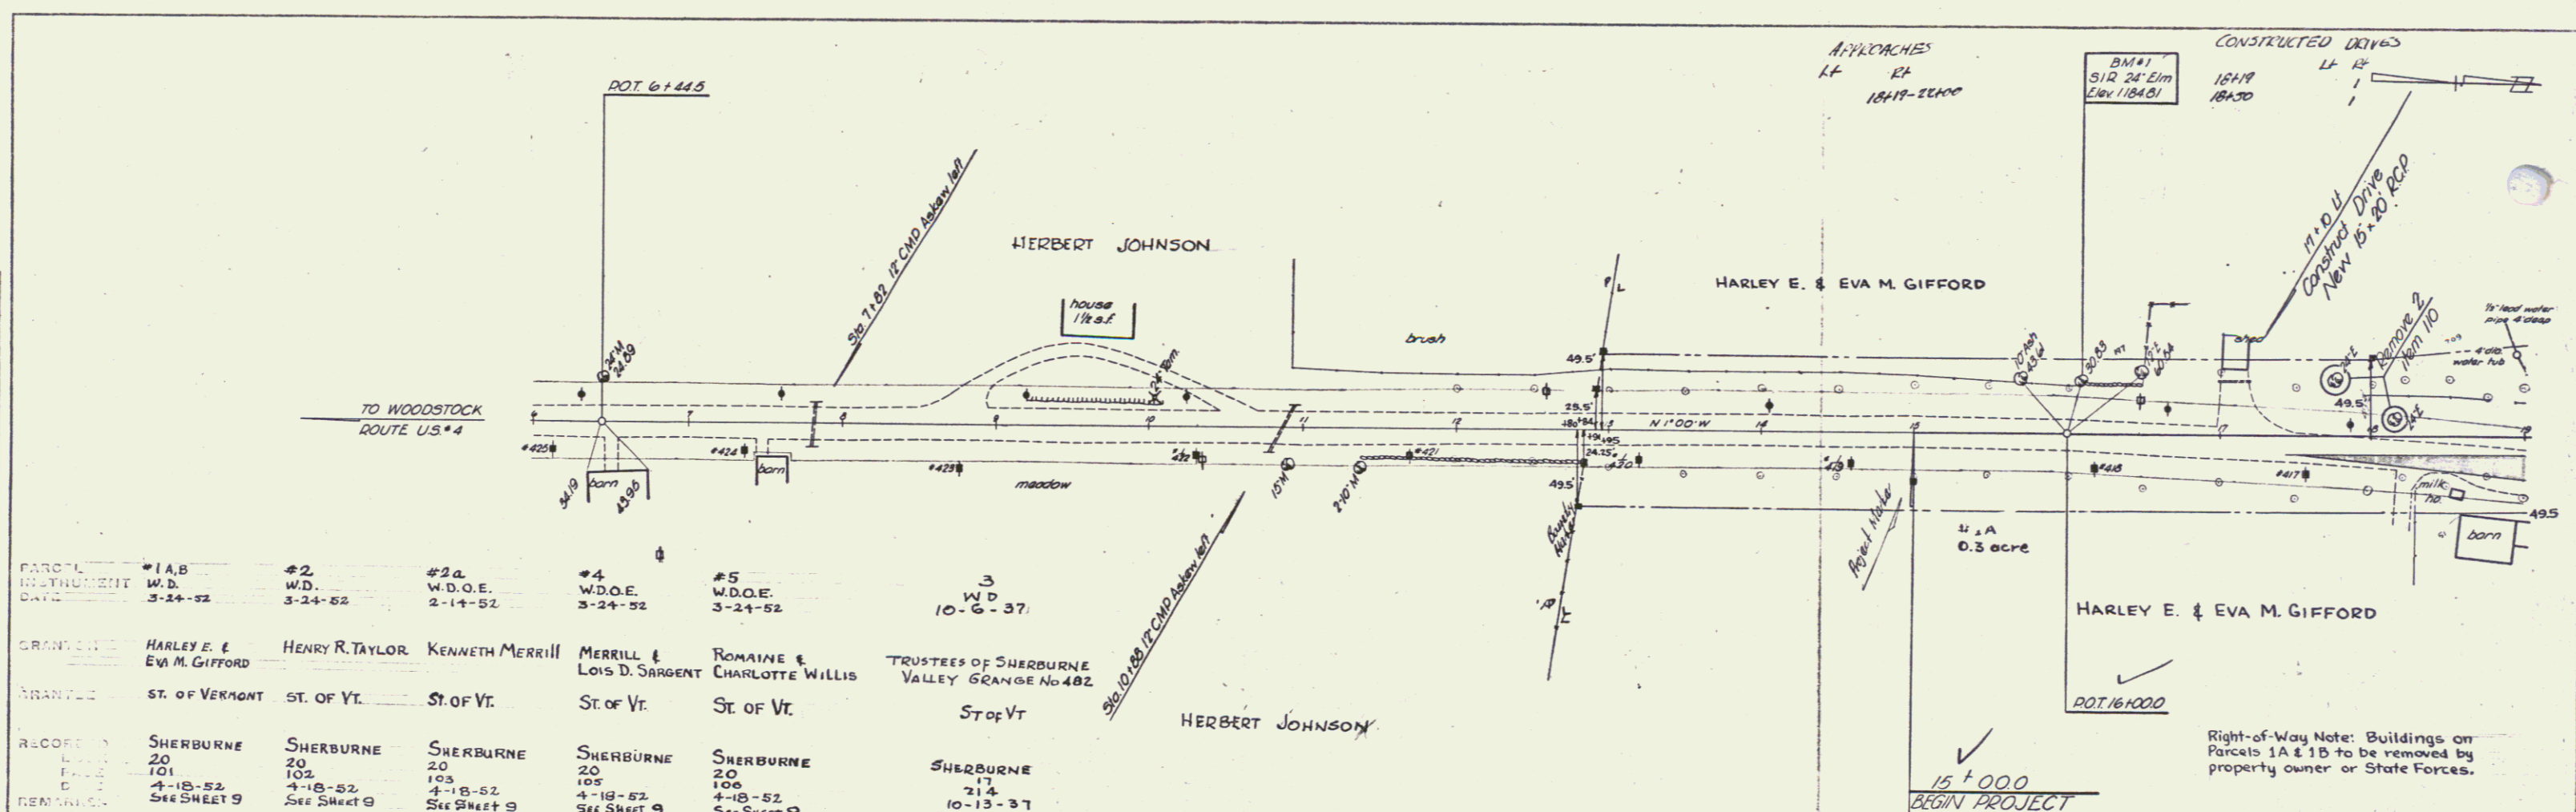

PARCEL	#1 A B	#2	#2 a	#4	#5	3
INSTRUMENT	W.D.	W.D.	W.D.O.E.	W.D.O.E.	W.D.O.E.	W.D.
DATE	3-24-52	3-24-52	2-14-52	3-24-52	3-24-52	10-6-37
GRANTEE	HARLEY E. & EVA M. GIFFORD	HENRY R. TAYLOR	KENNETH MERRILL	MERRILL & LOIS D. SARGENT	ROMAINE & CHARLOTTE WILLIS	TRUSTEES OF SHERBURNE VALLEY GRANGE No. 402
STATE	ST. OF VERMONT	ST. OF VT.	ST. OF VT.	ST. OF VT.	ST. OF VT.	ST. OF VT.
RECORD	SHERBURNE 20 101	SHERBURNE 20 102	SHERBURNE 20 103	SHERBURNE 20 105	SHERBURNE 20 106	SHERBURNE 17 214
REMARKS	See SHEET 9	See SHEET 9	See SHEET 9	See SHEET 9	See SHEET 9	10-13-37 See SHEET 9.

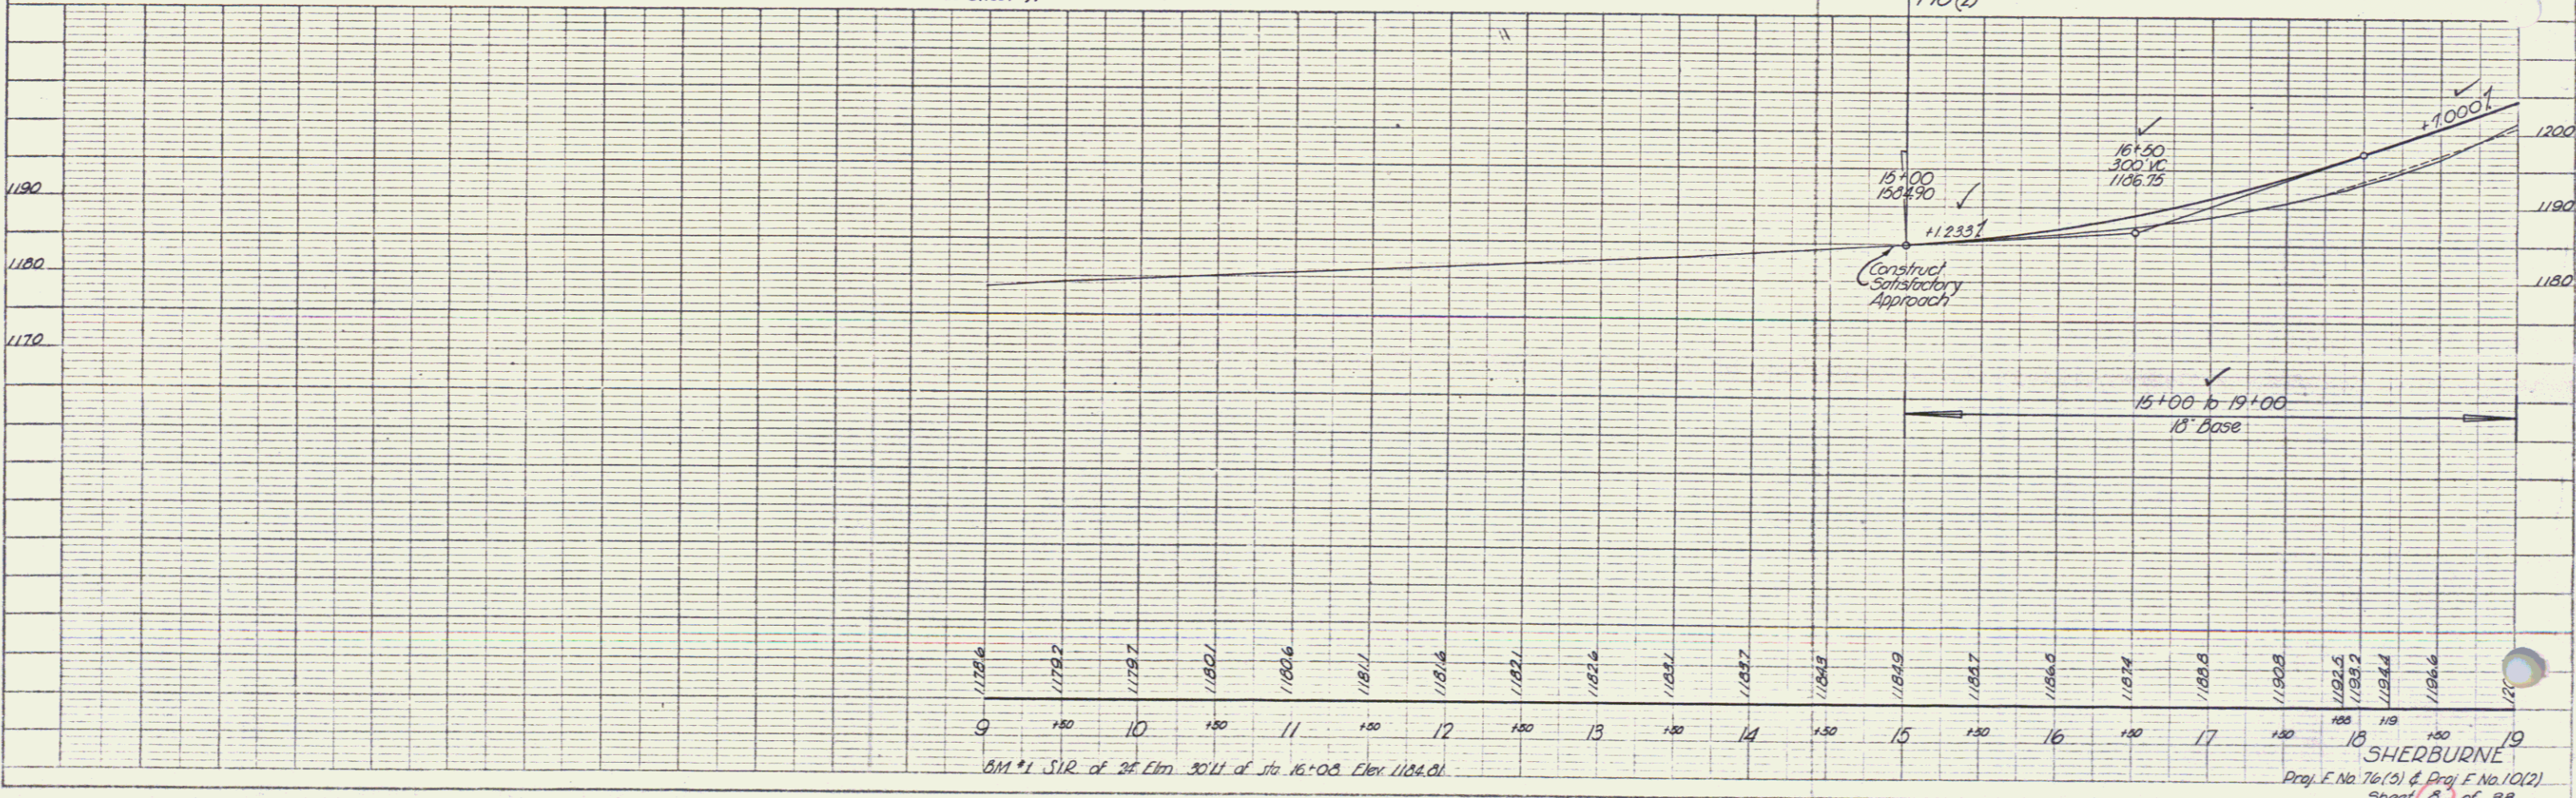


PLATE 11 - PLAN - PROFILE - 11 x 17 - 1/4" = 1" - 1/4" STANDARD
 SCALE: 1" = 40' HORIZ. 1" = 10' VERT.

SHERBURNE
 Proj. E. No. 76(5) & Proj. F. No. 10(2)
 Sheet 8 of 33