


DRILLING & BLASTING - ITEM 114
12+50 - 16+00

Surveying
9-25
S. GUYE

Sherburne
9-25
S. GUYE

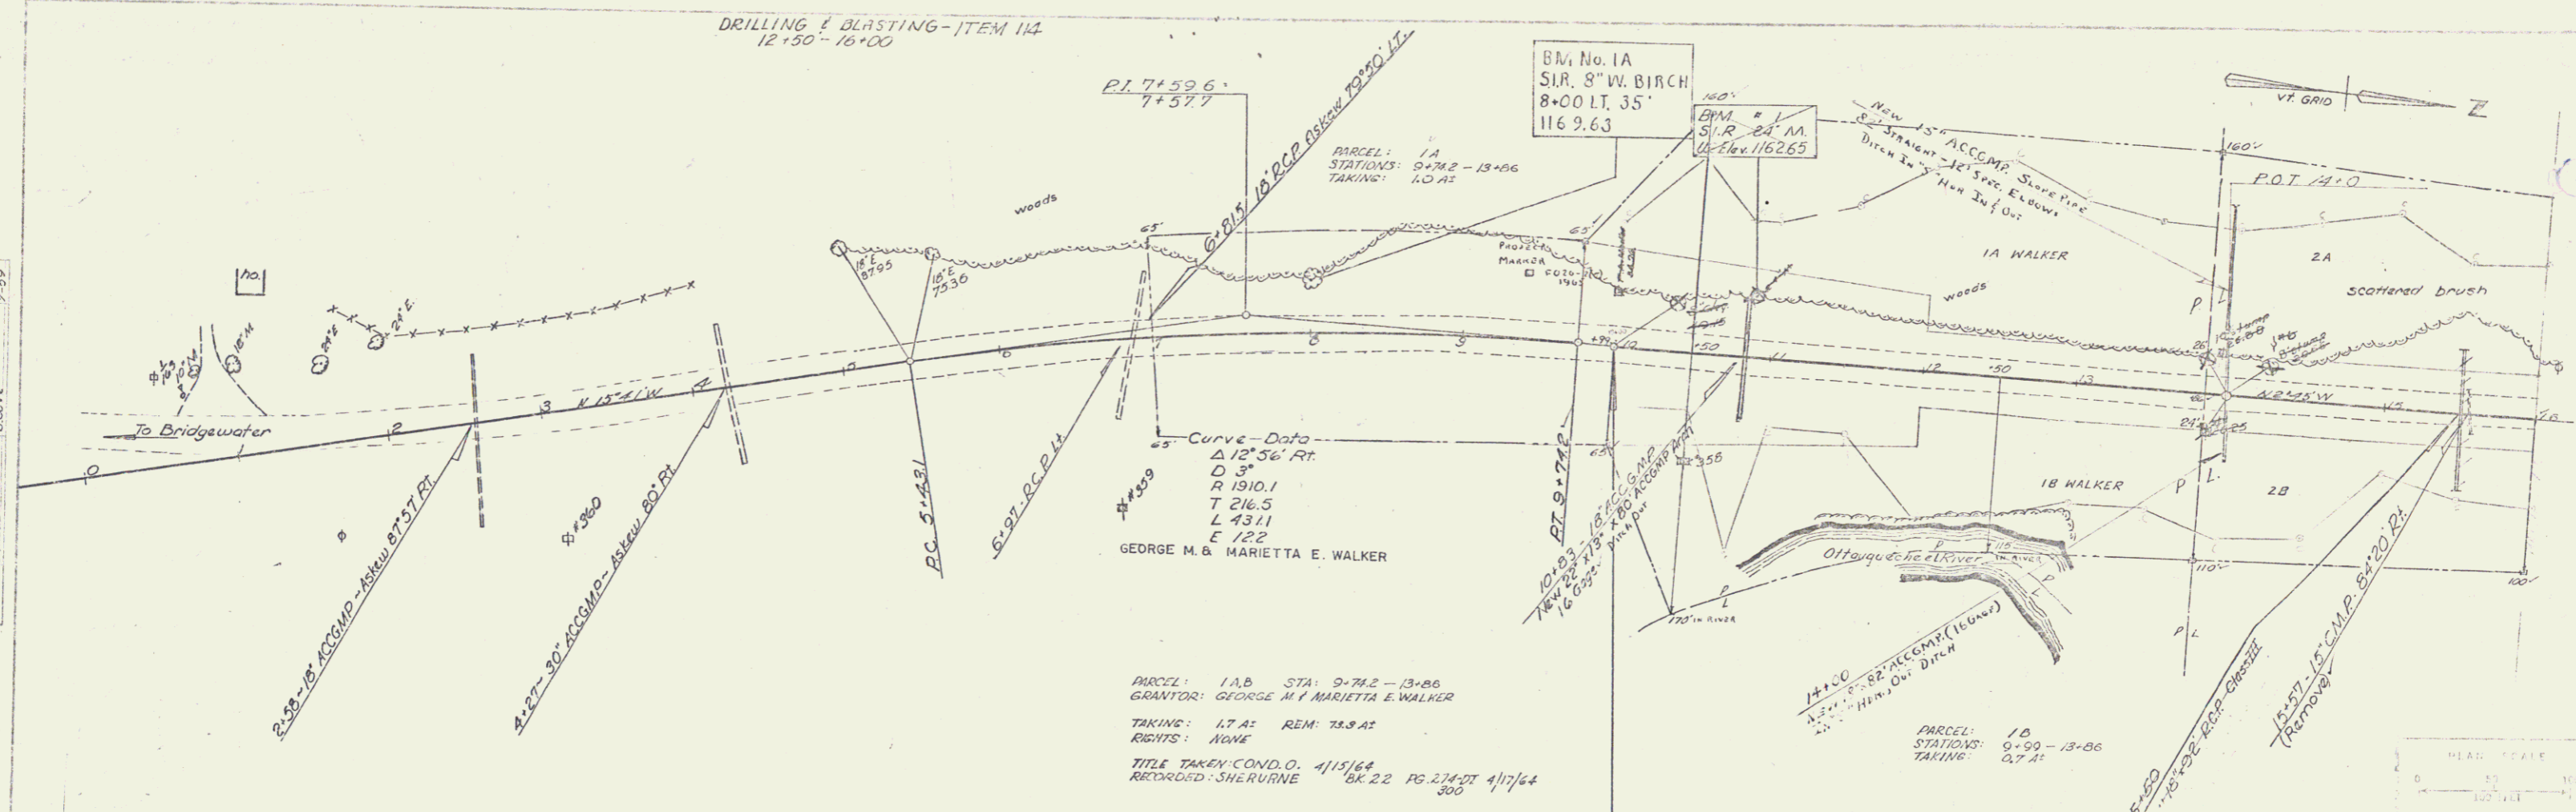

STA 5+00 STA 9+99 ✓
 Begin Project F 10 (3) Begin Project
 (1955) F 020-2 (6)



PROF. SCALE
 HORIZ. 1" = 100'
 VERT. 1" = 10'