


P.M. 0-58  
 2-59  
 Russell  
 S.G. 7-90  
 TRACED

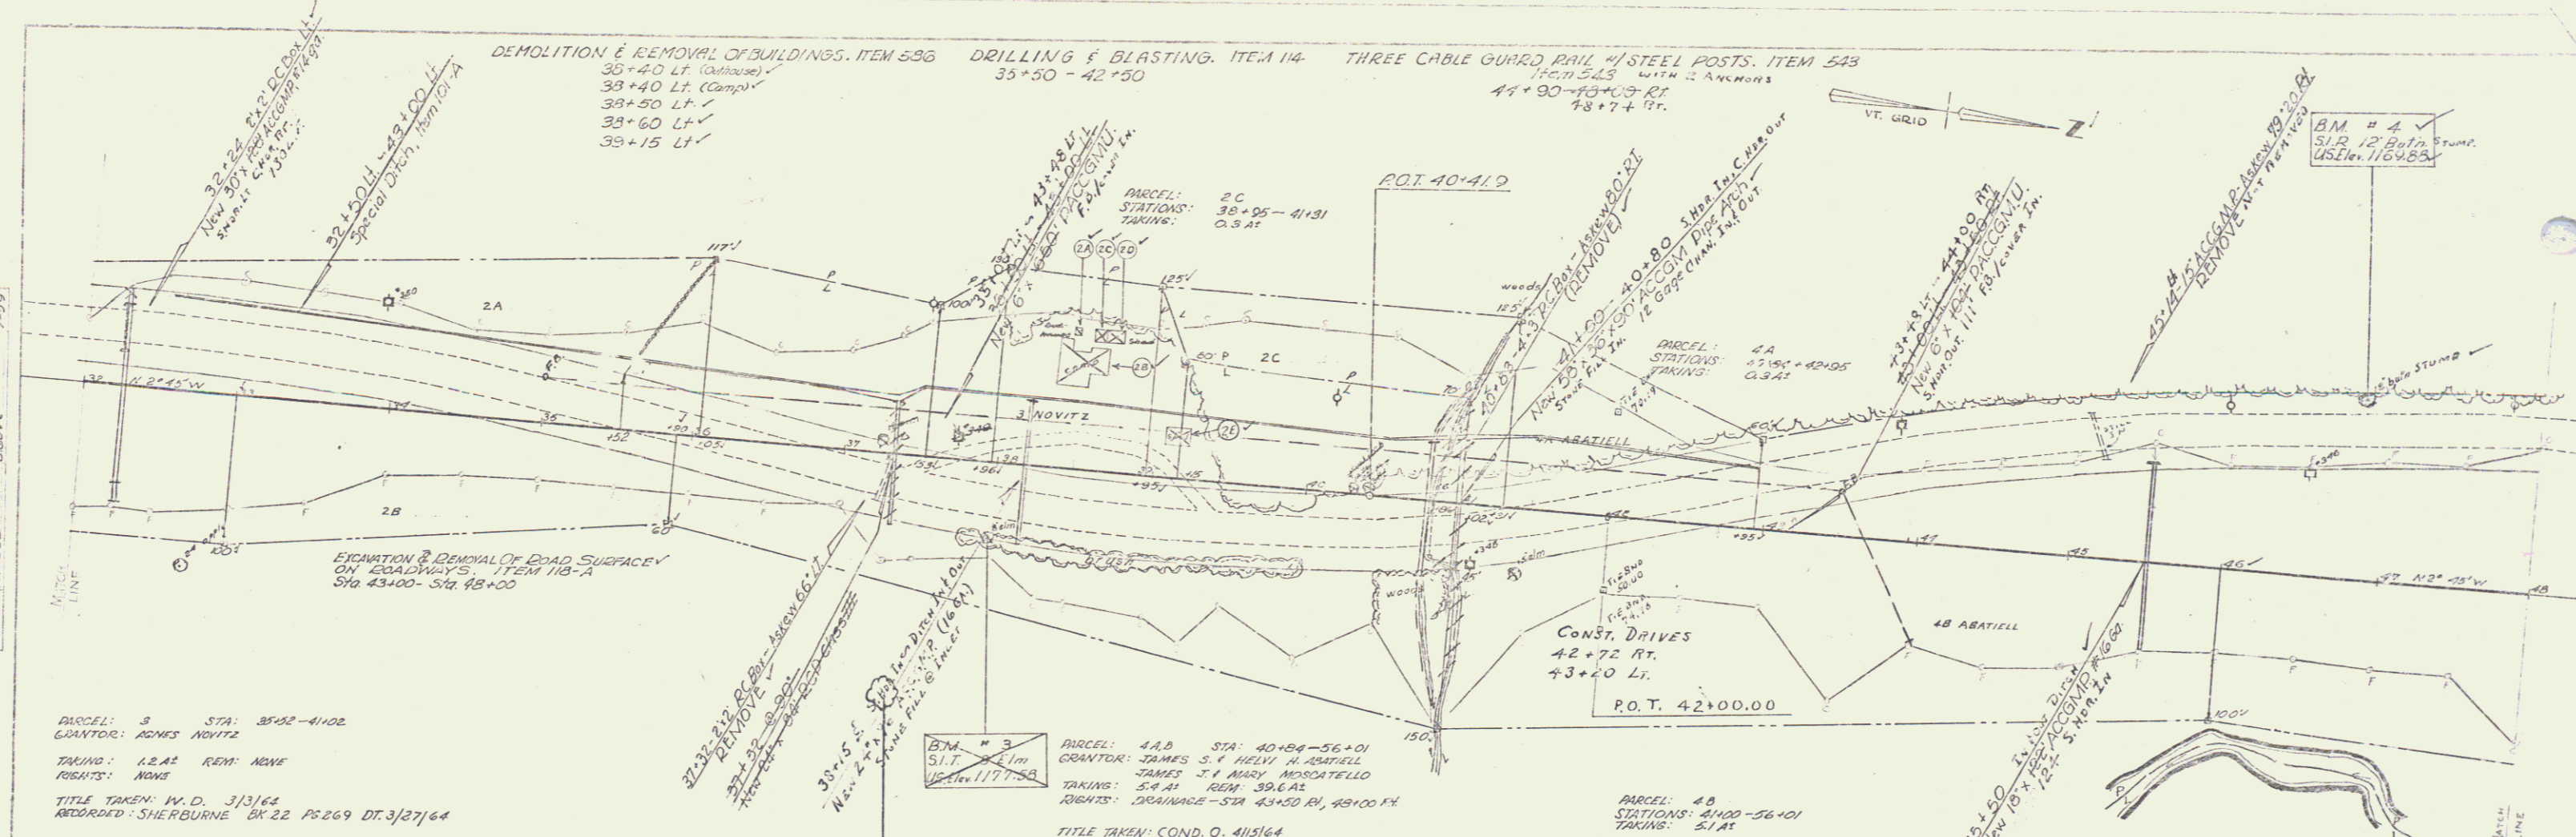


PARCEL: 3 STA: 35+02-41+02  
 GRANTOR: ARNOLD NOVITZ  
 TAKING: 1.2.62 REM: NONE  
 RIGHTS: NONE  
 TITLE TAKEN: M.D. 3/3/64  
 RECORDED: SHERBURNE BK 22 PG 269 DT. 3/27/64

PARCEL: 4A STA: 40+04-56+01  
 GRANTOR: JAMES S. & HELEN A. ABATELL  
 TAKING: 5.9.61 REM: 39.6.62  
 RIGHTS: DRAINAGE - STA 43+50 RT. 49+00 RT.  
 TITLE TAKEN: COND. O. 4/15/64  
 RECORDED: SHERBURNE BK 22 PG 274 DT. 4/11/64

PARCEL: 4B  
 STATIONS: 44+00-56+01  
 TAKING: 5.1.61

B.M. No. 3A  
 SIT. 10" CHERRY  
 37+40 Rt 160'  
 ELEV. 1163.90

Spacing of ground  
 contour lines

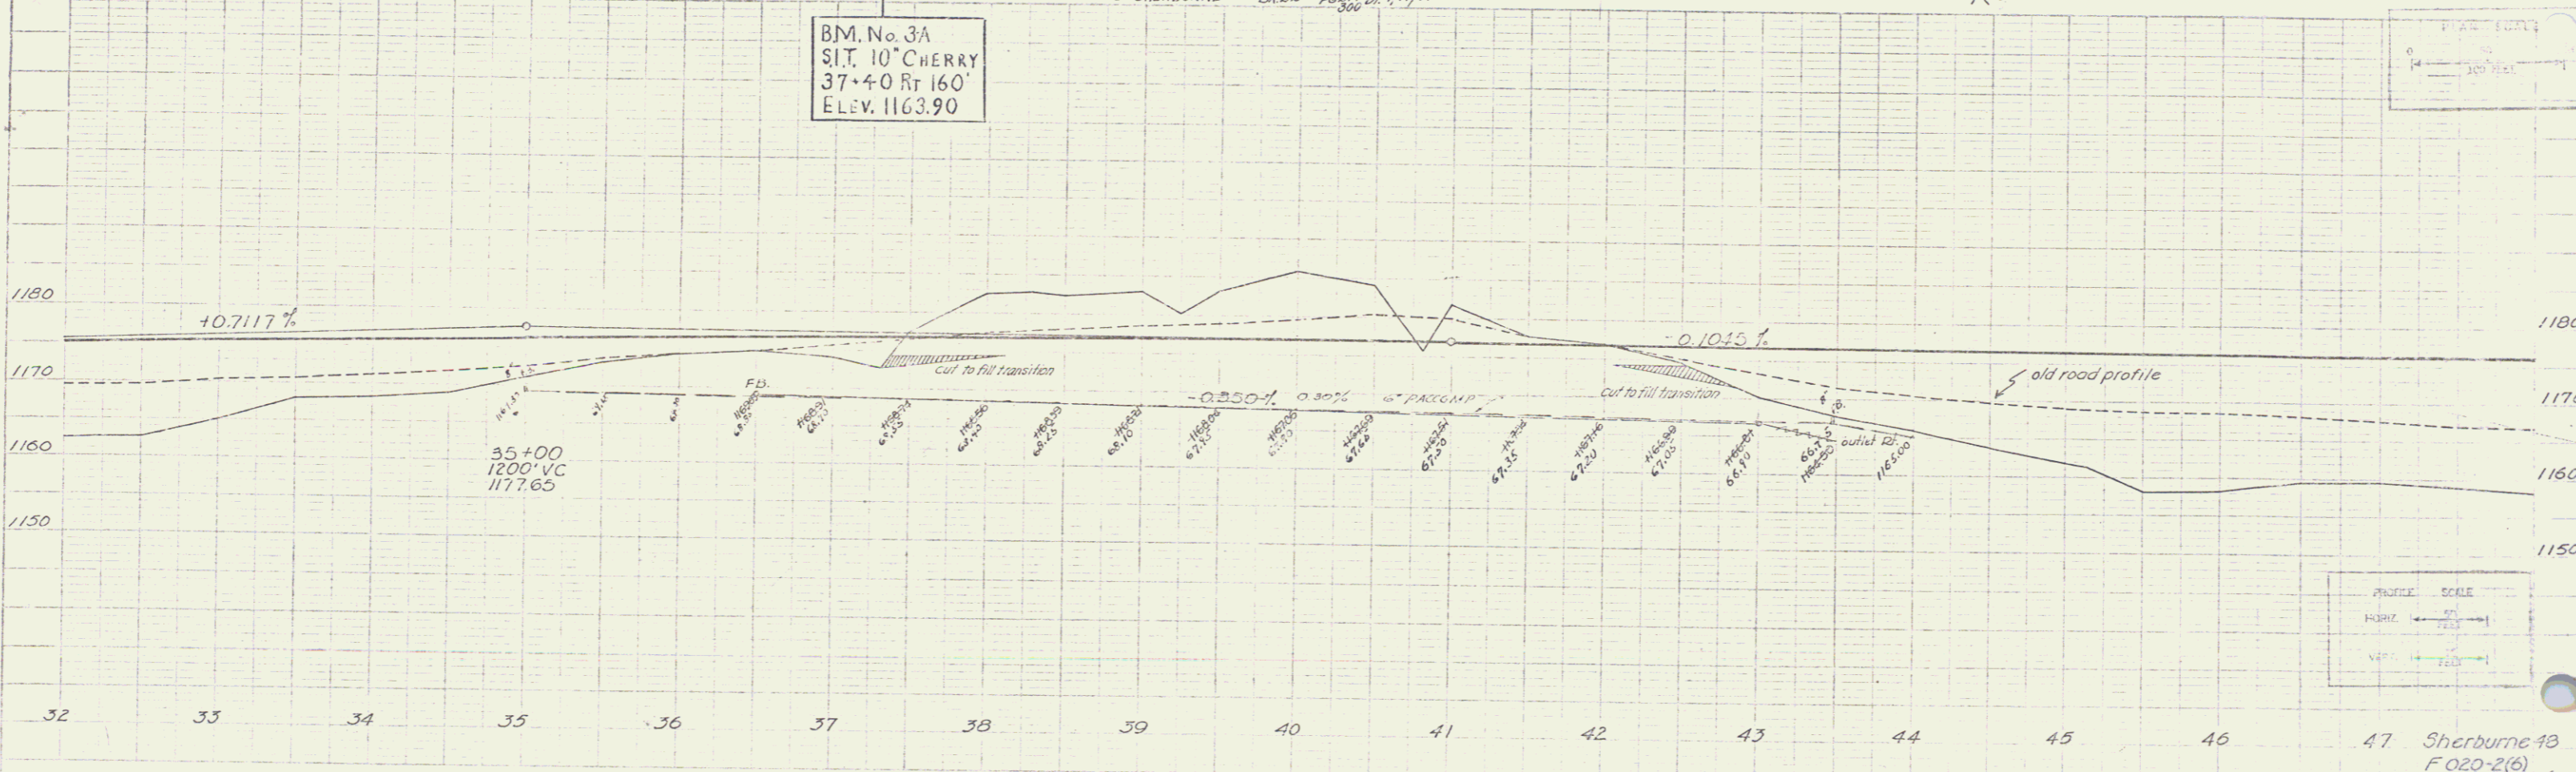

PROFILE SCALE  
 HORIZ. 1" = 100'  
 VERT. 1" = 10'

47 Sherburne 4B  
 F 020-2(6)  
 Sheet 17 of 216 Sheets