

STONE FILL ITEM 502
 50+65-52+50 RT
 52+50-55+25 RT
 50+50 ~ 55+00 RT

THREE CABLE GUARD RAIL w/STEEL POSTS
 Item 543
 48+00 ~ 56+00 RT
 49+30 ~ 52+00 RT - 2 Avn.
 52+39 ~ 56+00 RT - 2 Avn.

Channel Excavation of Earth, Item 106-A
 59+65 RT ~ 59+50 RT
 59+50 RT ~ 55+50 RT

DRILLING / BLASTING - ITEM 114
 59+50 - 63+50



Demolition & Removal of Building - Item 586
 55+25 E

B.M. No. 5-A
 S.I.T 3" POPLAR
 59+20 Lt. 85'
 ELEV. 1180.85

Construct Drive
 56+50 Lt
 58+50 Lt
 49+00 Rt.
 52+50 Rt.
 53+50 Lt.
 56+25 Lt.
 58+25 Lt.

VT. GRID

Scale
 1" = 40'
 1" = 80'
 1" = 160'

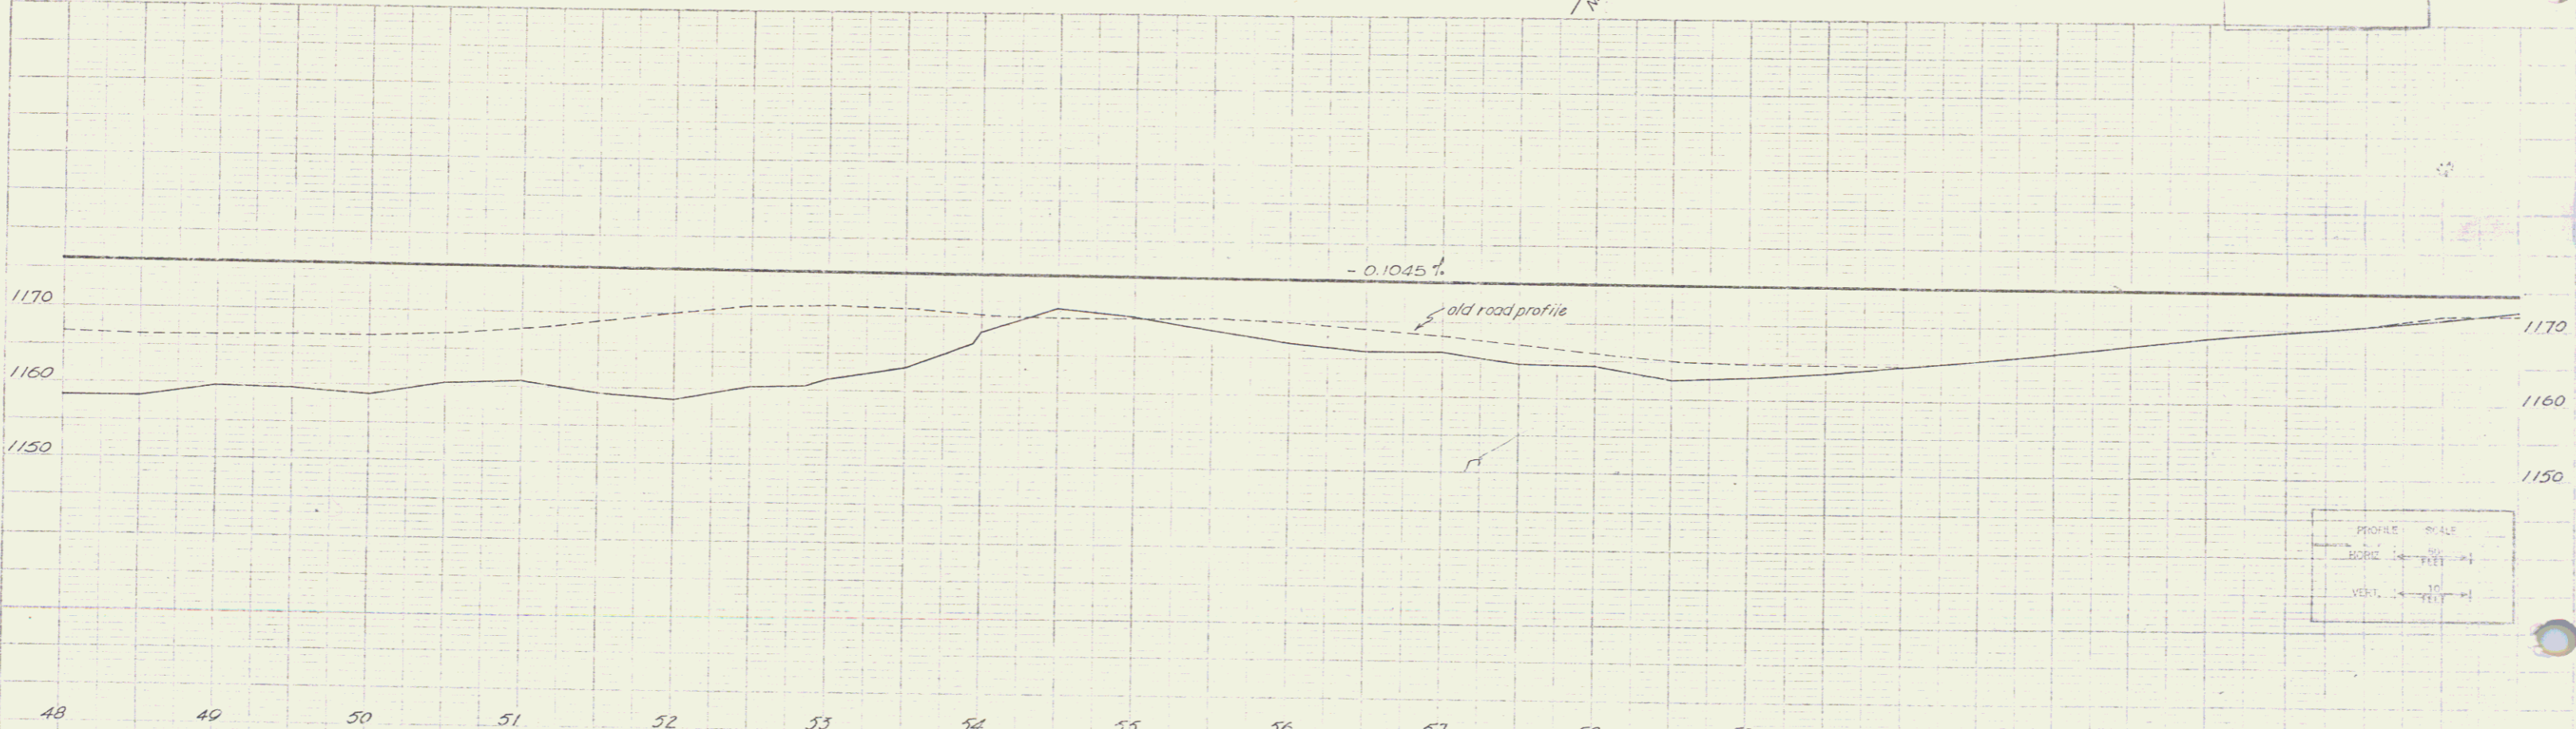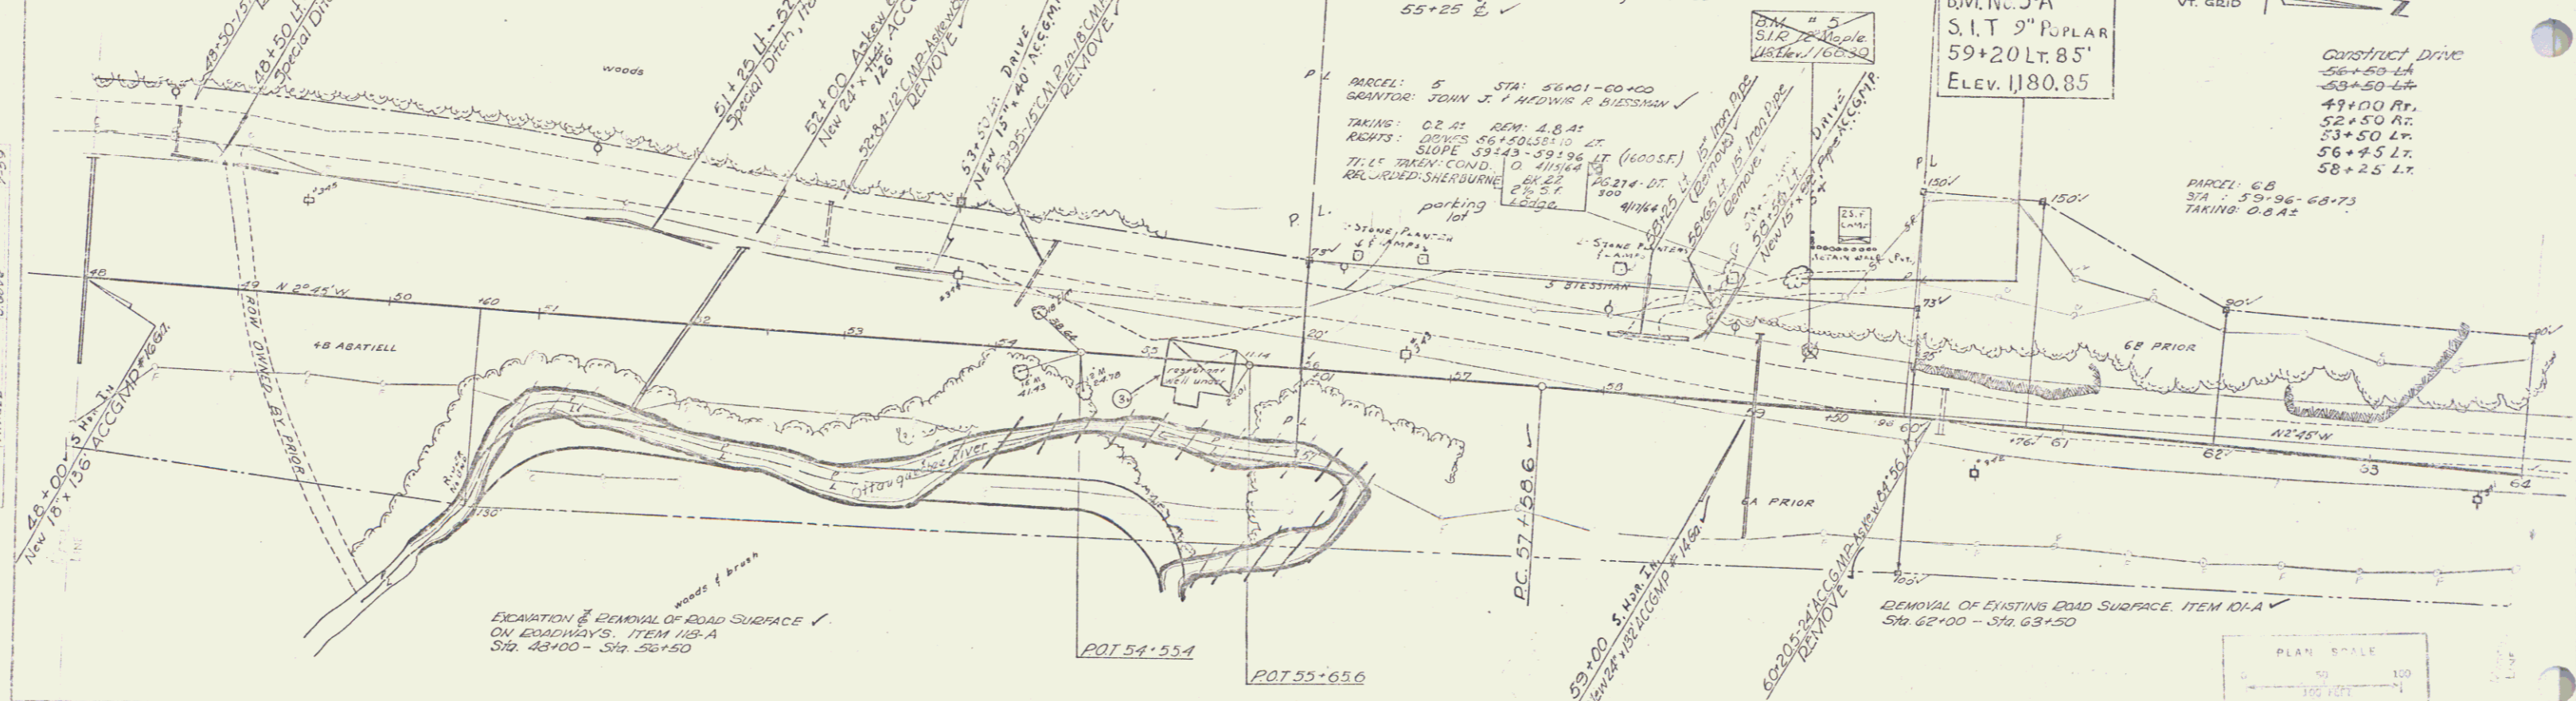

Sherburne 64
 F 020-2(e)
 Sheet 18 of 216

5