
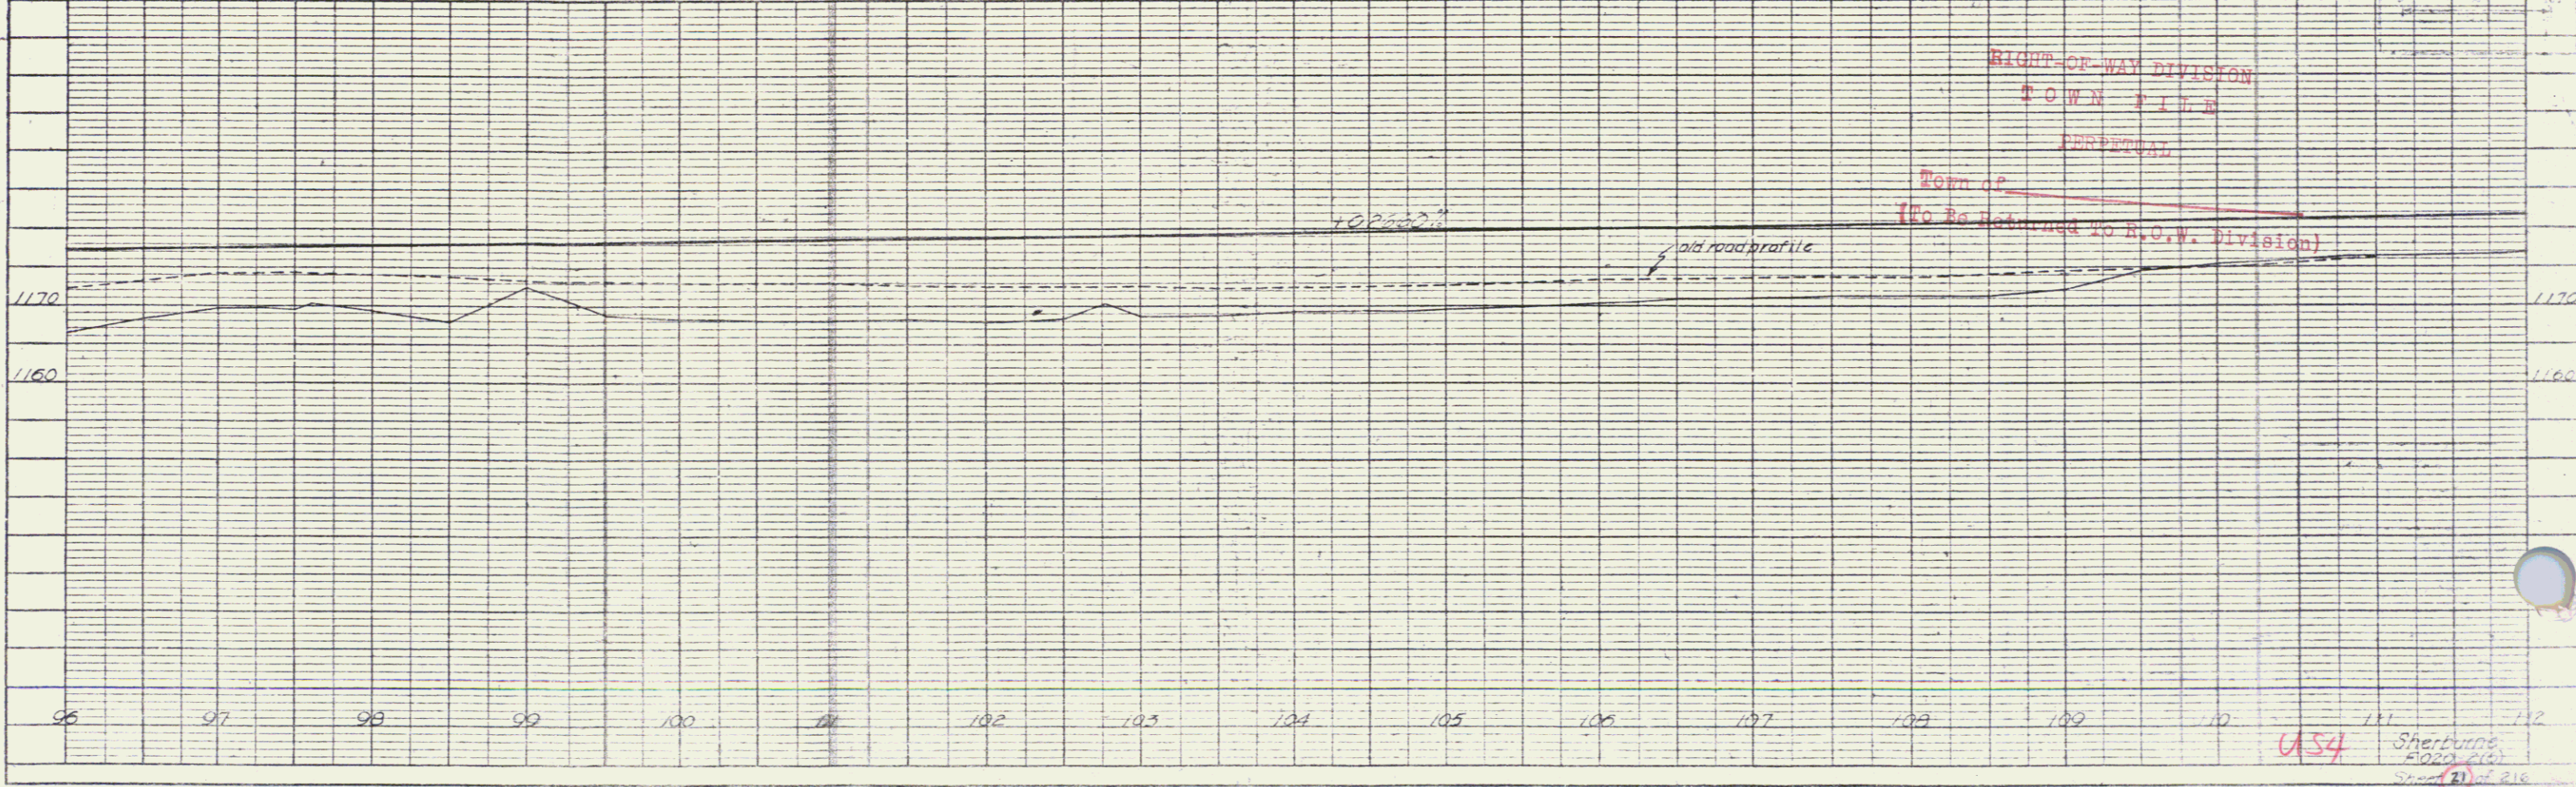


PLAN
 DRAWN BY: [Signature]
 CHECKED BY: [Signature]
 DATE: 11/13/64

PROFILE
 DRAWN BY: [Signature]
 CHECKED BY: [Signature]
 DATE: 11/13/64

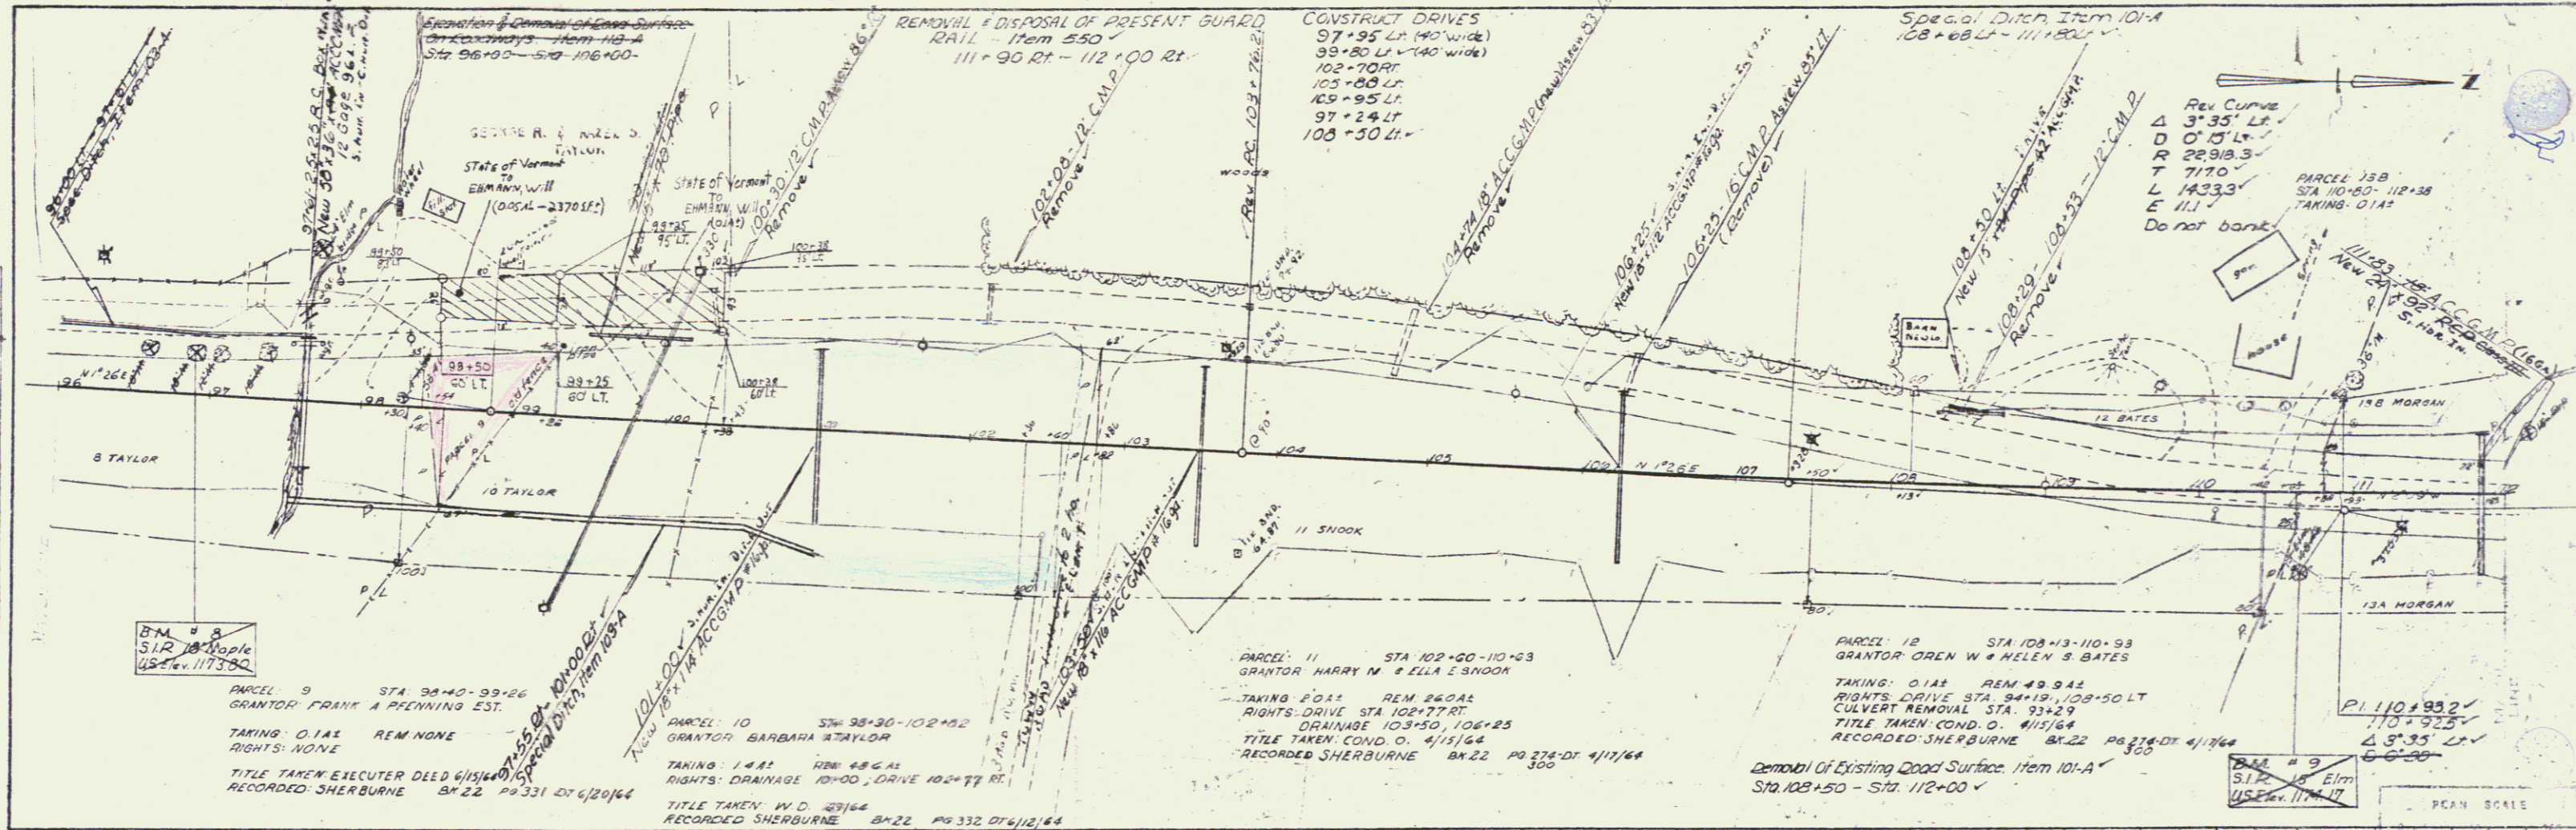

6154
 Sherburne
 11/13/64