
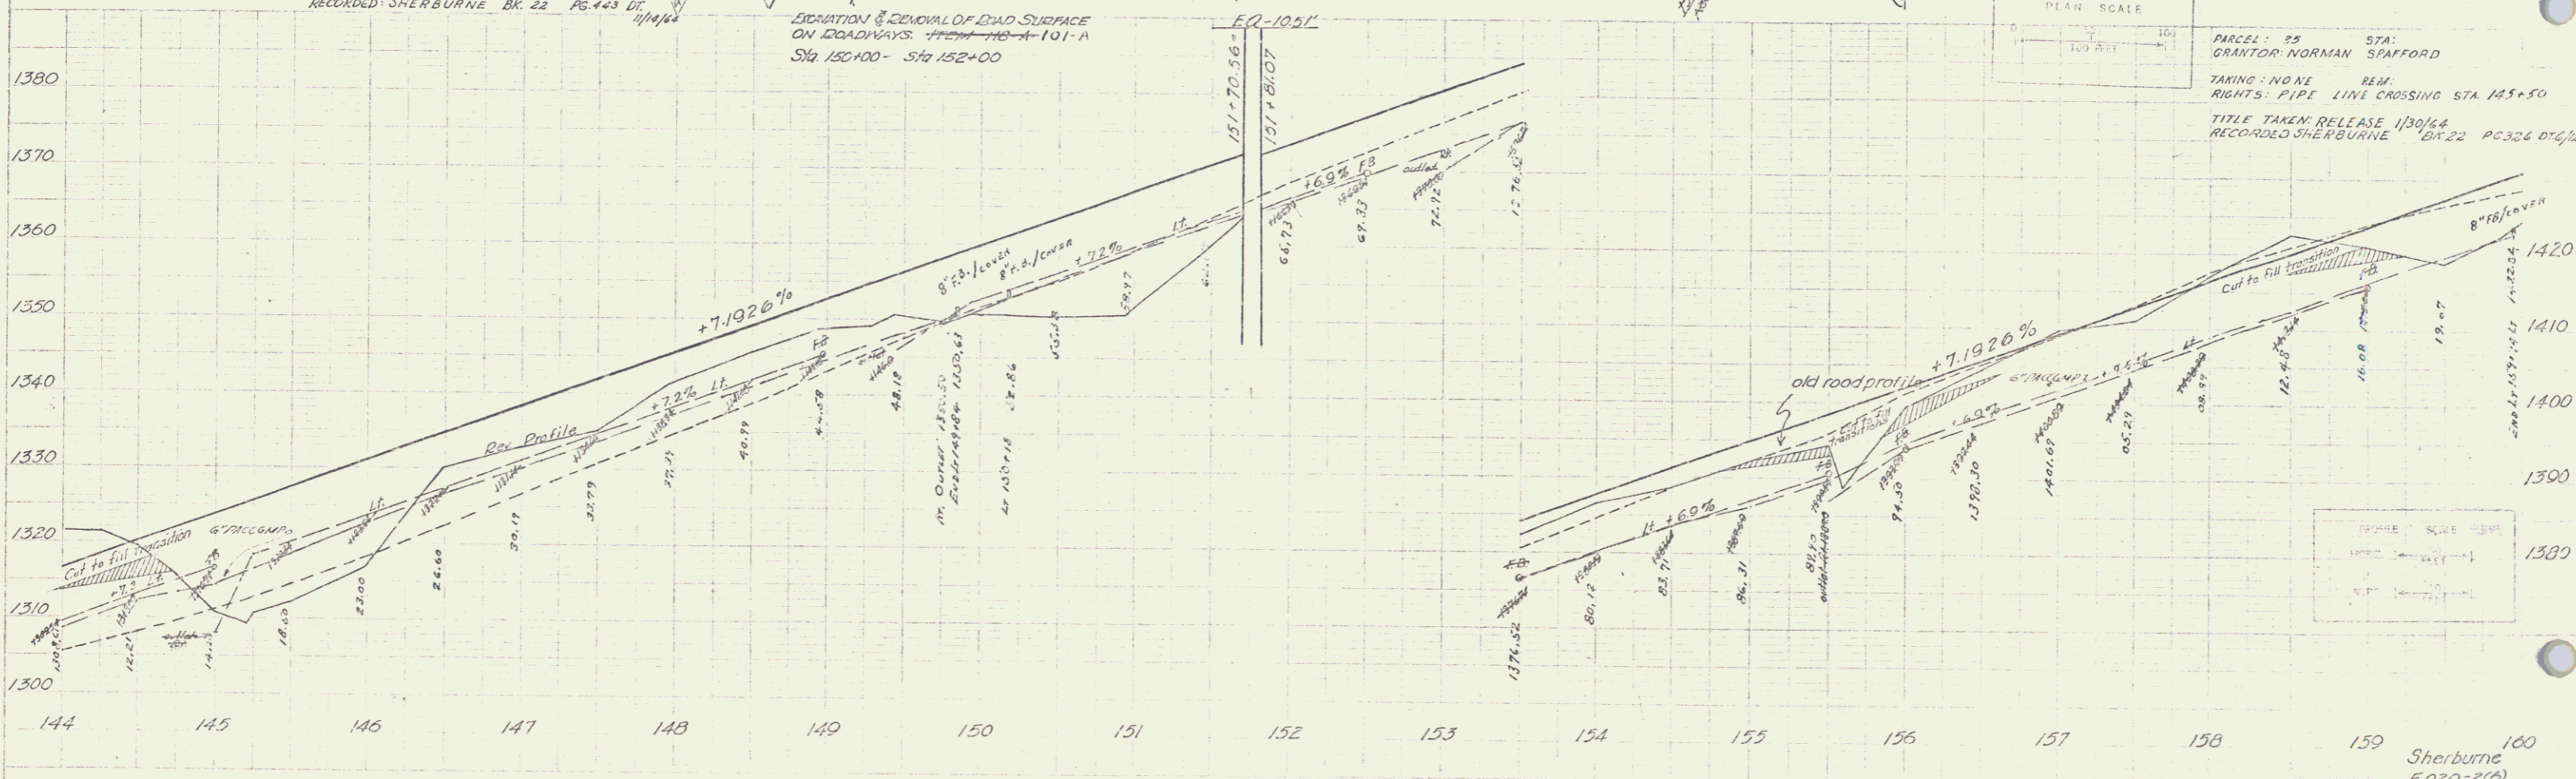


|               |              |
|---------------|--------------|
| DATE          | 9-26         |
| BY            | W. D. 7/1/64 |
| REVISION      | 2-59         |
| NO. OF SHEETS | 25           |
| TOTAL SHEETS  | 25           |
| SCALE         | AS SHOWN     |
| PROJECT       | THIRD        |

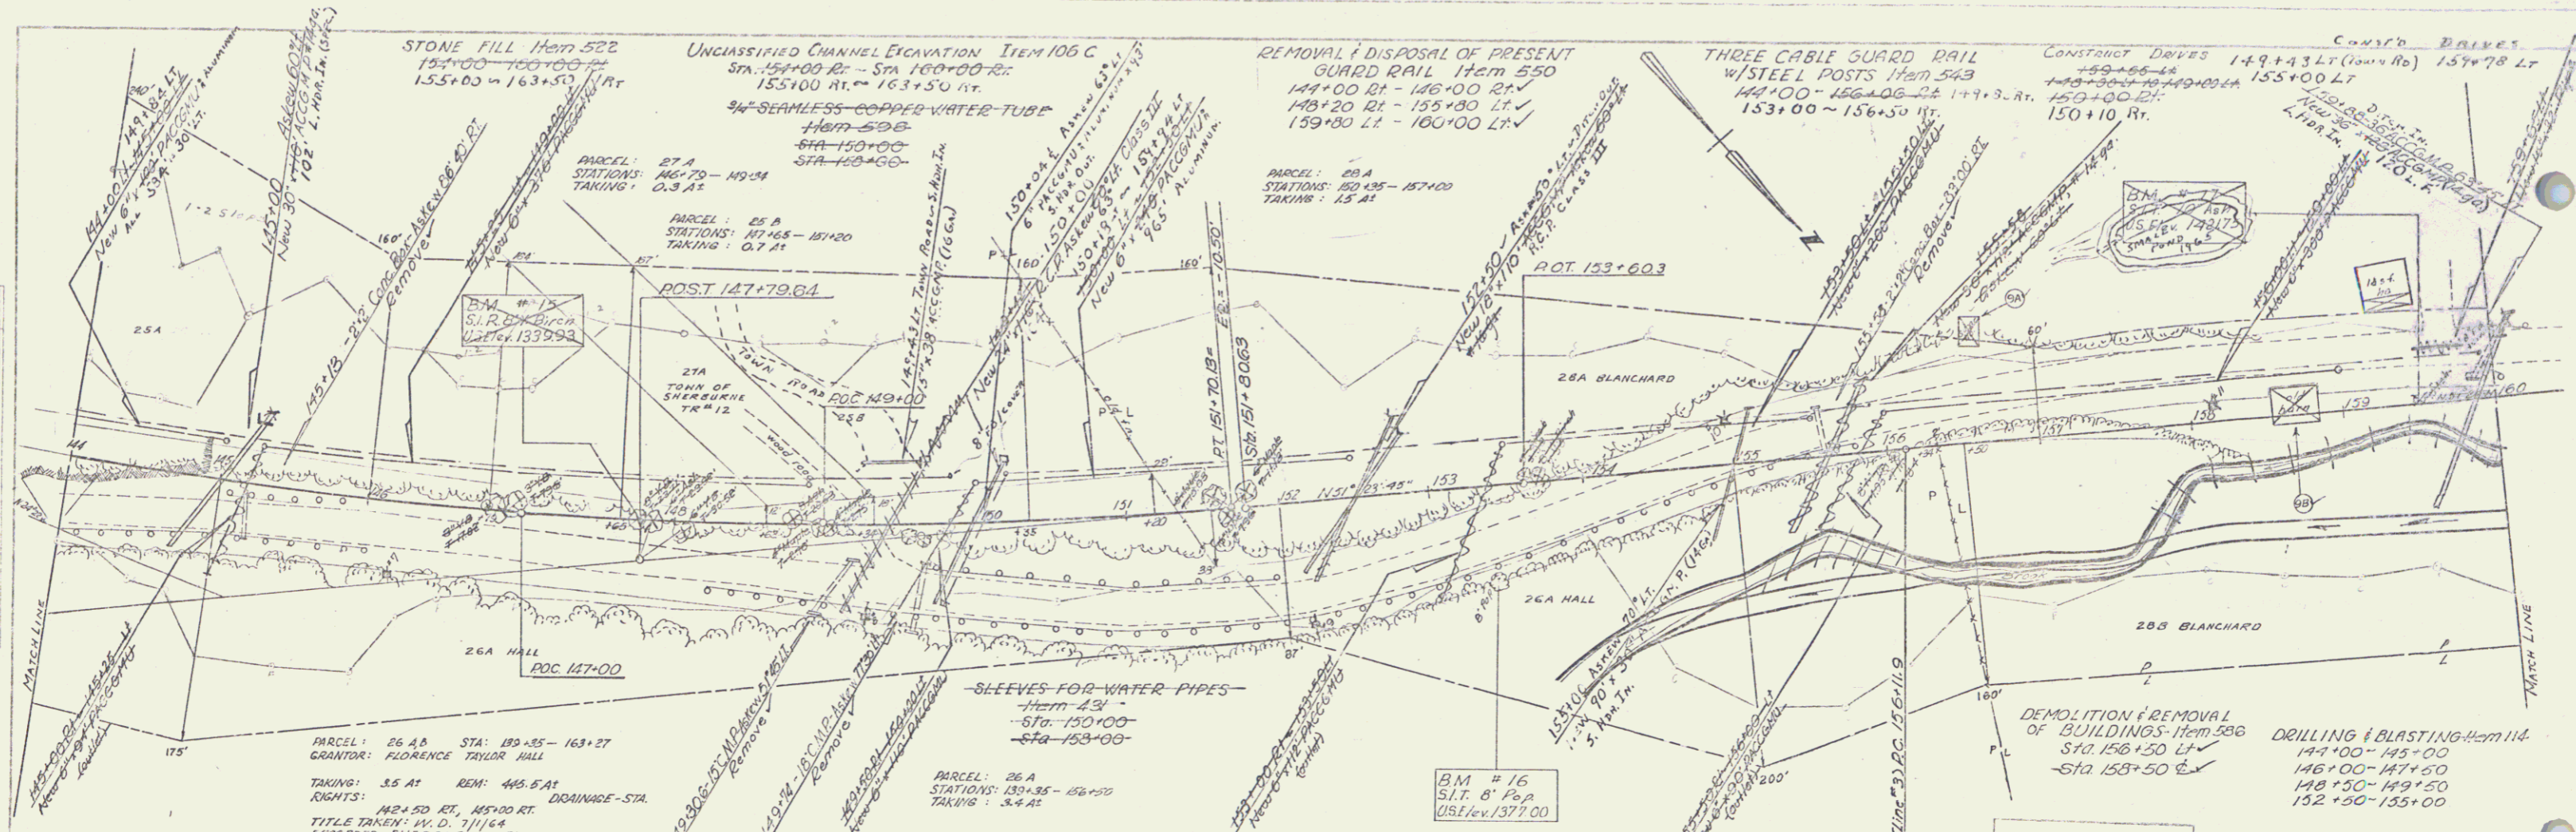

Sherburne  
FO20-2(6)  
Sheet 25 of 216