

SLEEVES FOR WATER PIPES
Item 231
Sta 168+30
168+30

1/4" SEAMLESS COPPER WATER TUBE
1 1/2" ID
Sta 168+30
168+30

PARCEL: 26 A, C STA: 150+35 - 171+93
GRANTOR: FRANK E. BLANCHARD
TAKING: 7.0 A1 REM: 73.0 A1
RIGHTS: TEMP EASEMENT TO REMOVE SUGAR AND
32" DIA 150' LT. AL. 8000' TITLE & INTEREST
IN (O.7A) STA 163+37 - 166+23 RT.
TITLE TAKEN COND. O. 4/15/64
RECORDED: SHERBURNE BK 22 PG 274 DT 4/17/64 300

PARCEL: 26 B
STATIONS: 156+34 - 166+13
TAKING: 3.4 A1

PARCEL: 27 A, B, C STA: 147+60 - 212+10
GRANTOR: TOWN OF SHERBURNE
TAKING: 0.6 A1 REM: ---
RIGHTS: ALL RIGHT, TITLE & INTEREST TO
SCHOOL HOUSE STA 211+50 LT. AND TR. 10, 11 & 12
TITLE TAKEN COND. O. 4/15/64
RECORDED: SHERBURNE BK 22 PG 274 DT 4/17/64 300

CONSTRUCT DRIVE
161+90 LT
163+50 LT
164+50 LT
174+50 LT
161+50 LT
164+14 Lt.
164+56 Rt.
168+78 Rt.
169+88 Rt.
173+50 Lt.
174+45 Rt.
175+80 Rt.

CONSTRUCT APPROACH
172+62 LAY

STONE FILL ITEM 522
160+00 - 163+50 RT
164+35 - 168+25 LT
164+25 - 168+00 LT

REMOVAL & DISPOSAL OF PRESENT
GUARD RAIL Item 550
160+00 LT - 160+20 LT
163+90 LT - 164+60 LT

DRILLING & BLASTING Item 114
168+00 - 173+30

PARCEL: 32 STA: 171+60 - 172+29
GRANTOR: HOWARD E. & FLORENCE S. TOWNE
TAKING: 0.1 A1 REM: 0.3 A1
RIGHTS: ALL RIGHT, TITLE & INTEREST IN TR #11
LOCATED WITHIN TAKING LINES
TITLE TAKEN COND. O. 4/15/64
RECORDED: SHERBURNE BK 22 PG 274 DT 4/17/64 300

PARCEL: 31 D
STATIONS: 172+23 - 174+06
TAKING: 0.3 A1



PARCEL: 27 B
STATIONS: 172+23 - 172+87
TAKING: 0.1 A1

PARCEL: 40 STA: ---
GRANTOR: HORACE E. GLAZE
TAKING: NONE REM: ---
RIGHTS: ROW & EASEMENT FOR
ERECTION OF BILLBOARD
STA 163+87 - 166+73
TITLE TAKEN COND. O. 3/15/64
RECORDED: SHERBURNE BK 22 PG 270 DT 3/21/64 300

PARCEL: 26 C
STATIONS: 162+00 - 171+93
TAKING: 8.1 A1

PI 168+791 =
168+496

CURVE DATA
D 33° 10' RT
D 3° 15'
L 1763.2'
T 525.0'
L 1020.5'
E 76.5'
Bnk 1/16' ft.

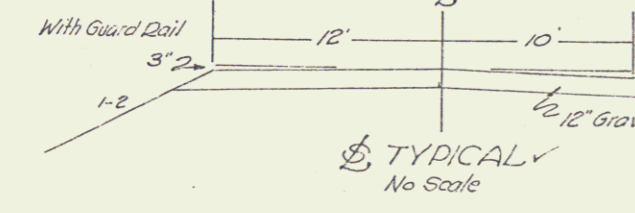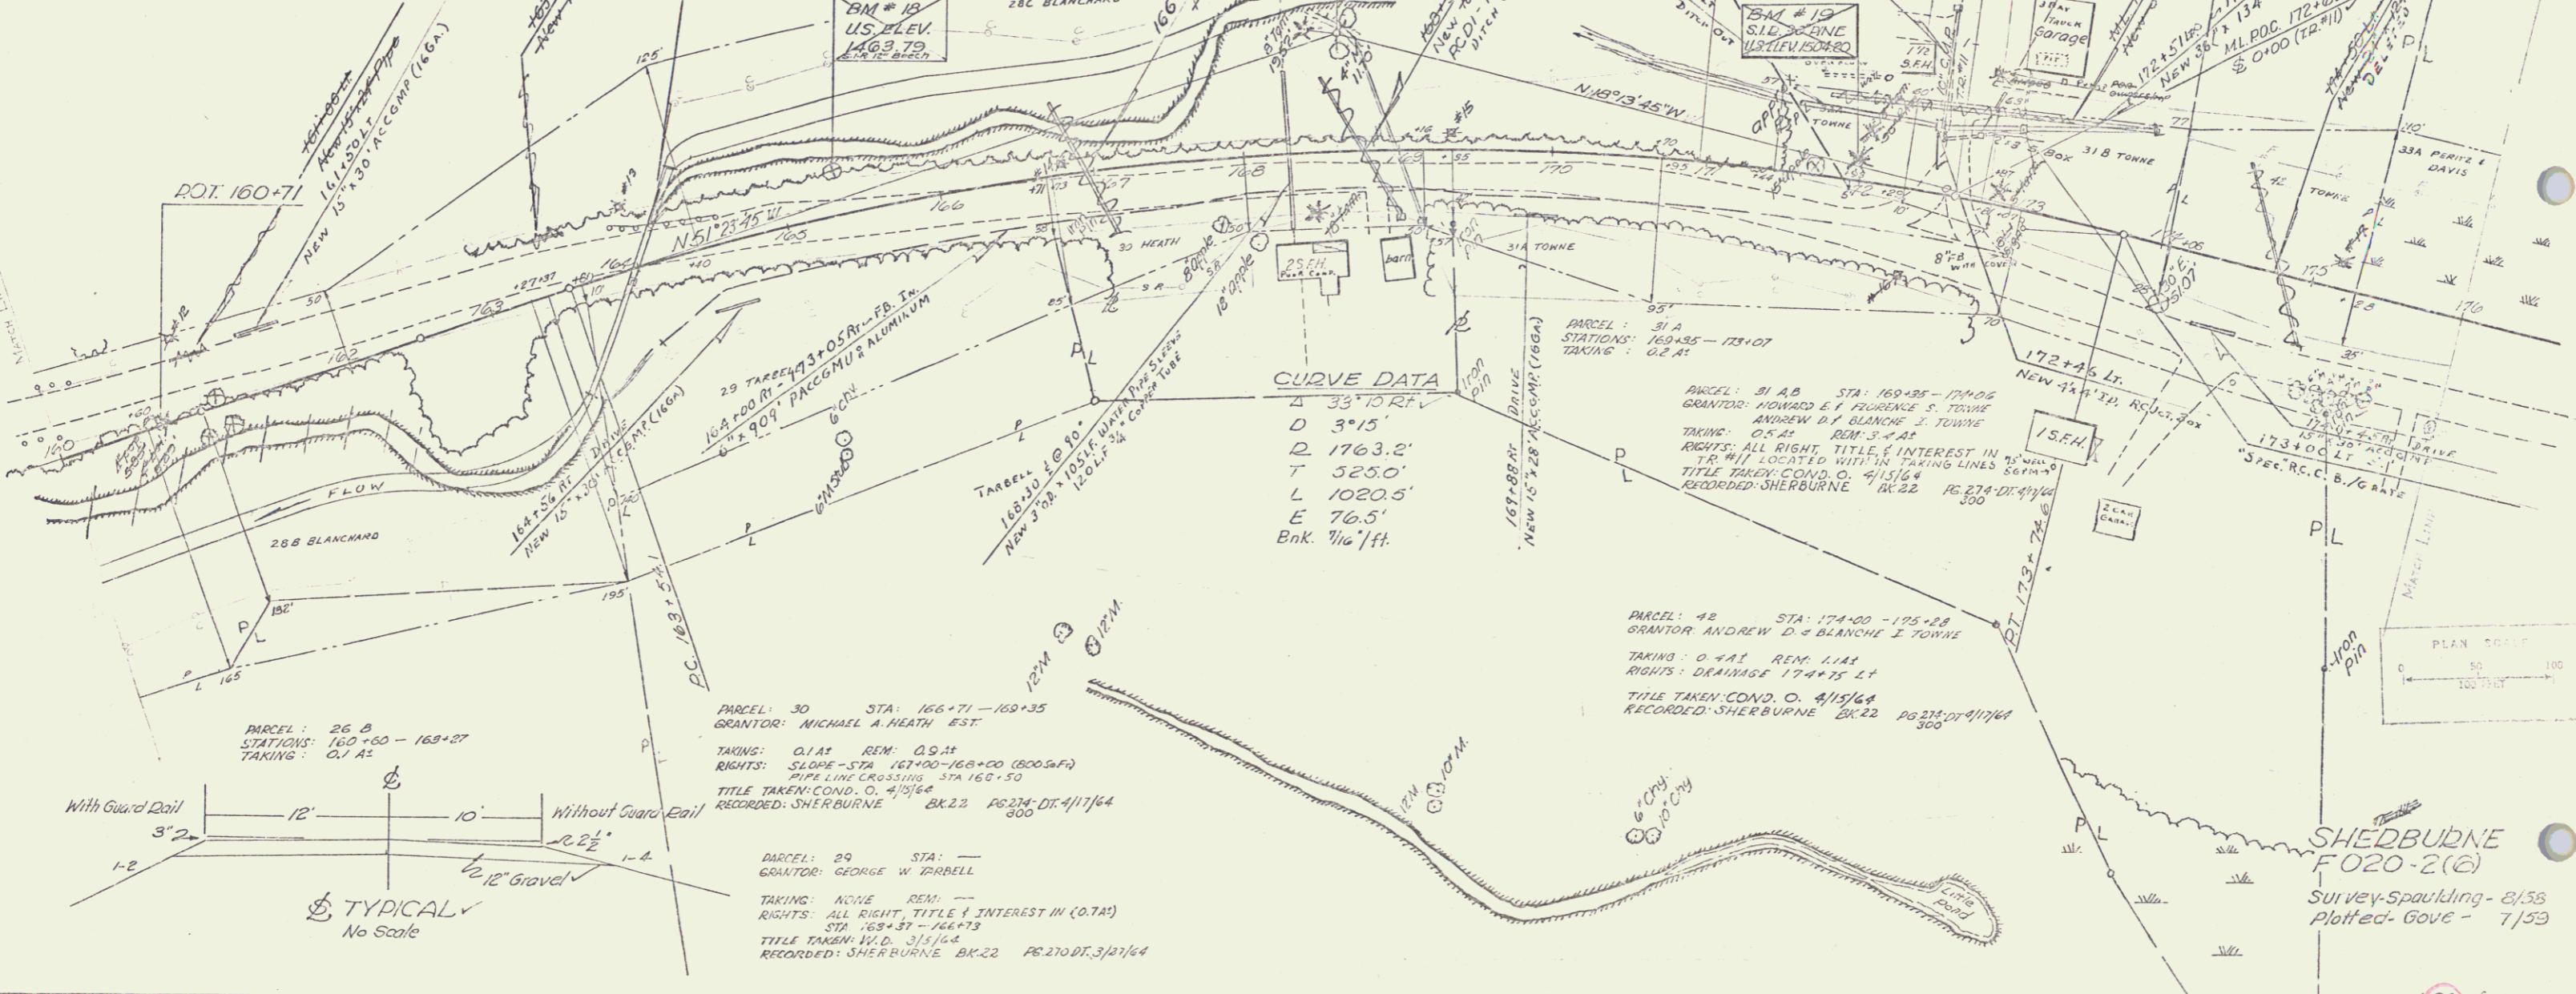

PARCEL: 30 STA: 166+71 - 169+35
GRANTOR: MICHAEL A. HEATH EST.
TAKING: 0.1 A1 REM: 0.3 A1
RIGHTS: SLOPE - STA 167+00 - 168+00 (800 SF)
PIPE LINE CROSSING STA 168+50
TITLE TAKEN COND. O. 4/15/64
RECORDED: SHERBURNE BK 22 PG 274 DT 4/17/64 300

PARCEL: 29 STA: ---
GRANTOR: GEORGE W. FARRELL
TAKING: NONE REM: ---
RIGHTS: ALL RIGHT, TITLE & INTEREST IN (O.7A)
STA 168+37 - 166+73
TITLE TAKEN V.D. 3/15/64
RECORDED: SHERBURNE BK 22 PG 270 DT 3/21/64 300

PARCEL: 48 STA: 174+00 - 175+28
GRANTOR: ANDREW D. & BLANCHE I. TOWNE
TAKING: 0.4 A1 REM: 1.1 A1
RIGHTS: DRAINAGE 17+25 LT
TITLE TAKEN COND. O. 4/15/64
RECORDED: SHERBURNE BK 22 PG 274 DT 4/17/64 300

SHERBURNE
F020-2(6)
Survey-Spaulding - 8/58
Plotted - Gove - 7/53