


|           |       |       |
|-----------|-------|-------|
| PLAN      | DATE  | BY    |
| NOTE BOOK | NO. 1 | DATE  |
| NO. 1     | NO. 1 | NO. 1 |



APPROACH @  
DOC. 172+620 LT ✓

|           |       |       |
|-----------|-------|-------|
| PROFILE   | DATE  | BY    |
| NOTE BOOK | NO. 1 | DATE  |
| NO. 1     | NO. 1 | NO. 1 |

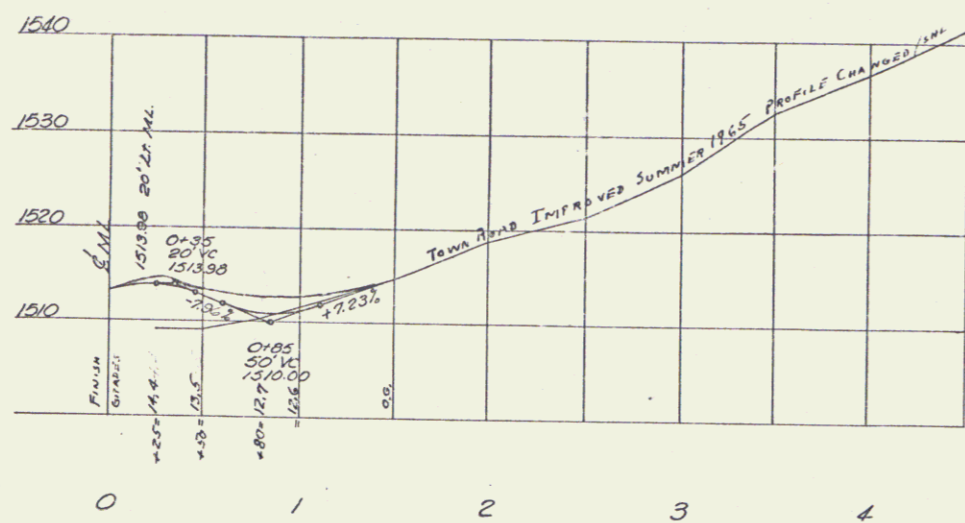

Sherburne  
FO20-2(5)  
Sheet 27 of 216