

Construct Drive 176+00 Rt. 176+70 Rt.
 181+00 Rt. 181+60 Rt.
 190+50 Lt. 18+50 Lt. Town
 184+75 Lt. (Approach) 185+97 Rt.
 186+00 Lt. 190+50 Lt.

REMOVAL & DISPOSAL OF PRESENT
 GUARD RAIL ITEM 550
 183+35 Lt. - 184+05 Lt.
 PARCEL: 33A, B STA: 175+20 - 186+70
 GRANTOR: RAYMOND PERITZ &
 WILLIAM M. DAVIS
 TAKING: 3.3A2 REM: 180.0A2
 RIGHTS: DRAINAGE STA: 186+00
 TITLE TAKEN: COND. O. 9/11/64
 RECORDED: SHERBURNE BK 22 PG. 214 DT 4/11/64

DRILLING & BLASTING ITEM 114
 190+00 - 192+00

MUCK EXCAVATION ITEM 116
 183+00 - 186+50

SLEEVES FOR WATER PIPES
 Item 431
 STA 176+50+/-

Removal of Existing Road Surface. Item 101-A
 Sta. 183+00 - 184+00

3/4" SEAMLESS COPPER WATER TUBE
 Item 598-A
 STA 176+50+/-
 EXCAVATION & REMOVAL OF ROAD SURFACE
 ON ROADWAYS. ITEM 118-A-10: A
 STA. 177+00 - STA. 180+50

PARCEL: 33A
 STATIONS: 175+20 - 184+04
 TAKING: 2.3A2


PL 6:000
 Δ 23°00' RT.

Δ 98°21' LT
 D 5'30"
 R 1041.7
 T 12023' / 2079'
 L 1790.0
 E 553.4
 Bk. 1' / 1st

CONTROL OF SECTION OF OLD HIGHWAY BETWEEN STATION 186+90 LT.
 AND STATION 194+75 LT. RELINQUISHED TO THE TOWN OF SHERBURNE
 AND RECORDED IN LAND RECORDS BOOK 23 PAGE 474 DATE NOV 24, 65

PARCEL: 36 STA: 181+00 - 183+77
 GRANTOR: GEORGE F. & ETHELYN M. SENECA
 TAKING: 1500 S&P REM: 0.7A2
 RIGHTS: NONE
 TITLE TAKEN: W.D. 5/27/64
 RECORDED: SHERBURNE BK 22 PG. 321 DT 5/10/64

PARCEL: 41 STA: -
 GRANTOR: STEPHEN H. & JANE D. LANGILL
 TAKING: NONE REM: 6.2A2
 RIGHTS: PIPE LINE CROSSING
 APPROX. STA 177+00
 TITLE TAKEN: COND. O. 9/11/64
 RECORDED SHERBURNE BK 22 PG. 274 DT 4/11/64

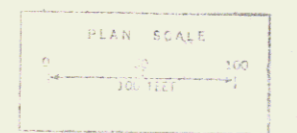

Sherburne-F020-2(6)
 Sun. Spaulding - 8-58
 Plot - S Gove 7-50
 Traced - S Gove 7-50