


PLAN
 DATE: 10/15/50
 SHEET NO. 31 OF 216

PROFILE
 DATE: 10/15/50
 SHEET NO. 31 OF 216

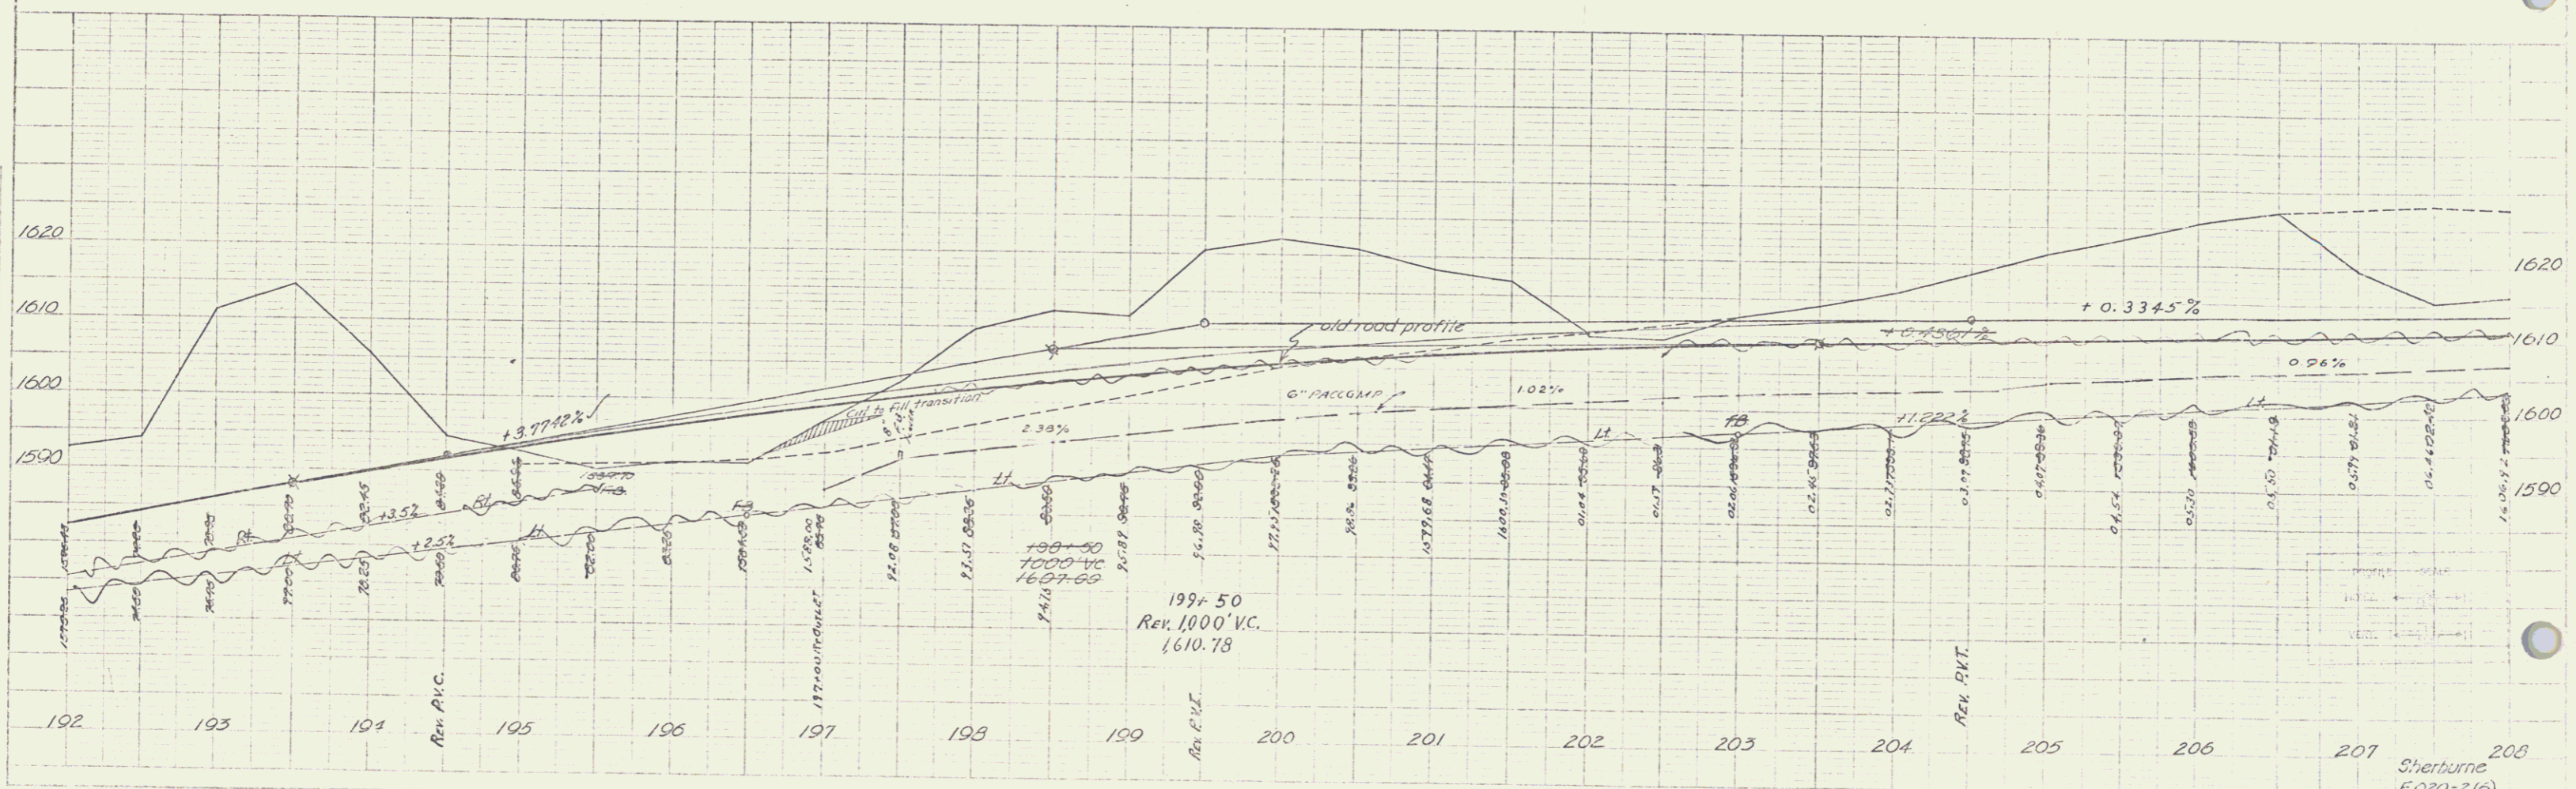

Sherburne
 F-020-2(16)
 Sheet 31 of 216