
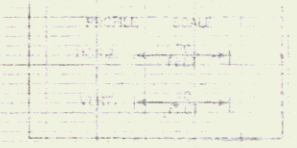
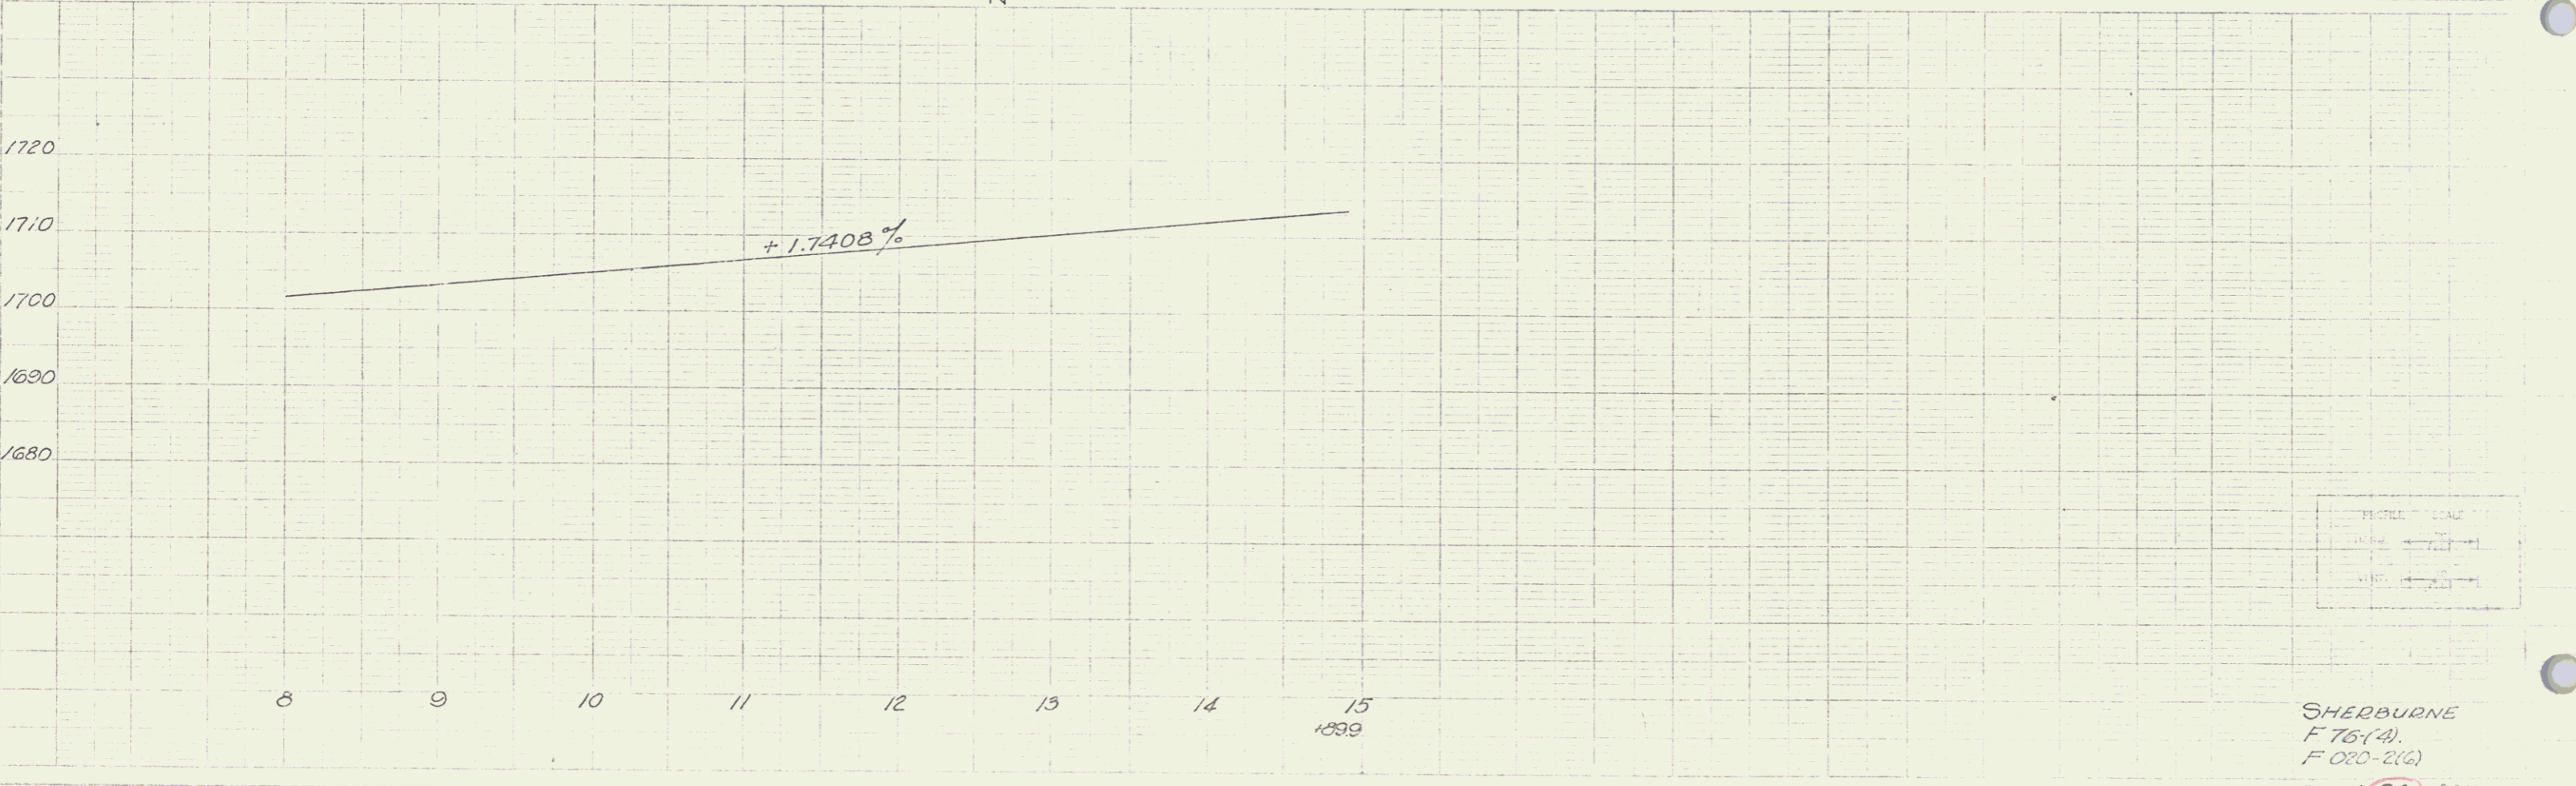
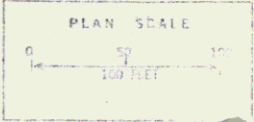


PLAN  
 3/5/55  
 SHERBURNE  
 F 76(4)  
 F 020-2(6)

PROFILE  
 3/5/55  
 SHERBURNE  
 F 76(4)  
 F 020-2(6)

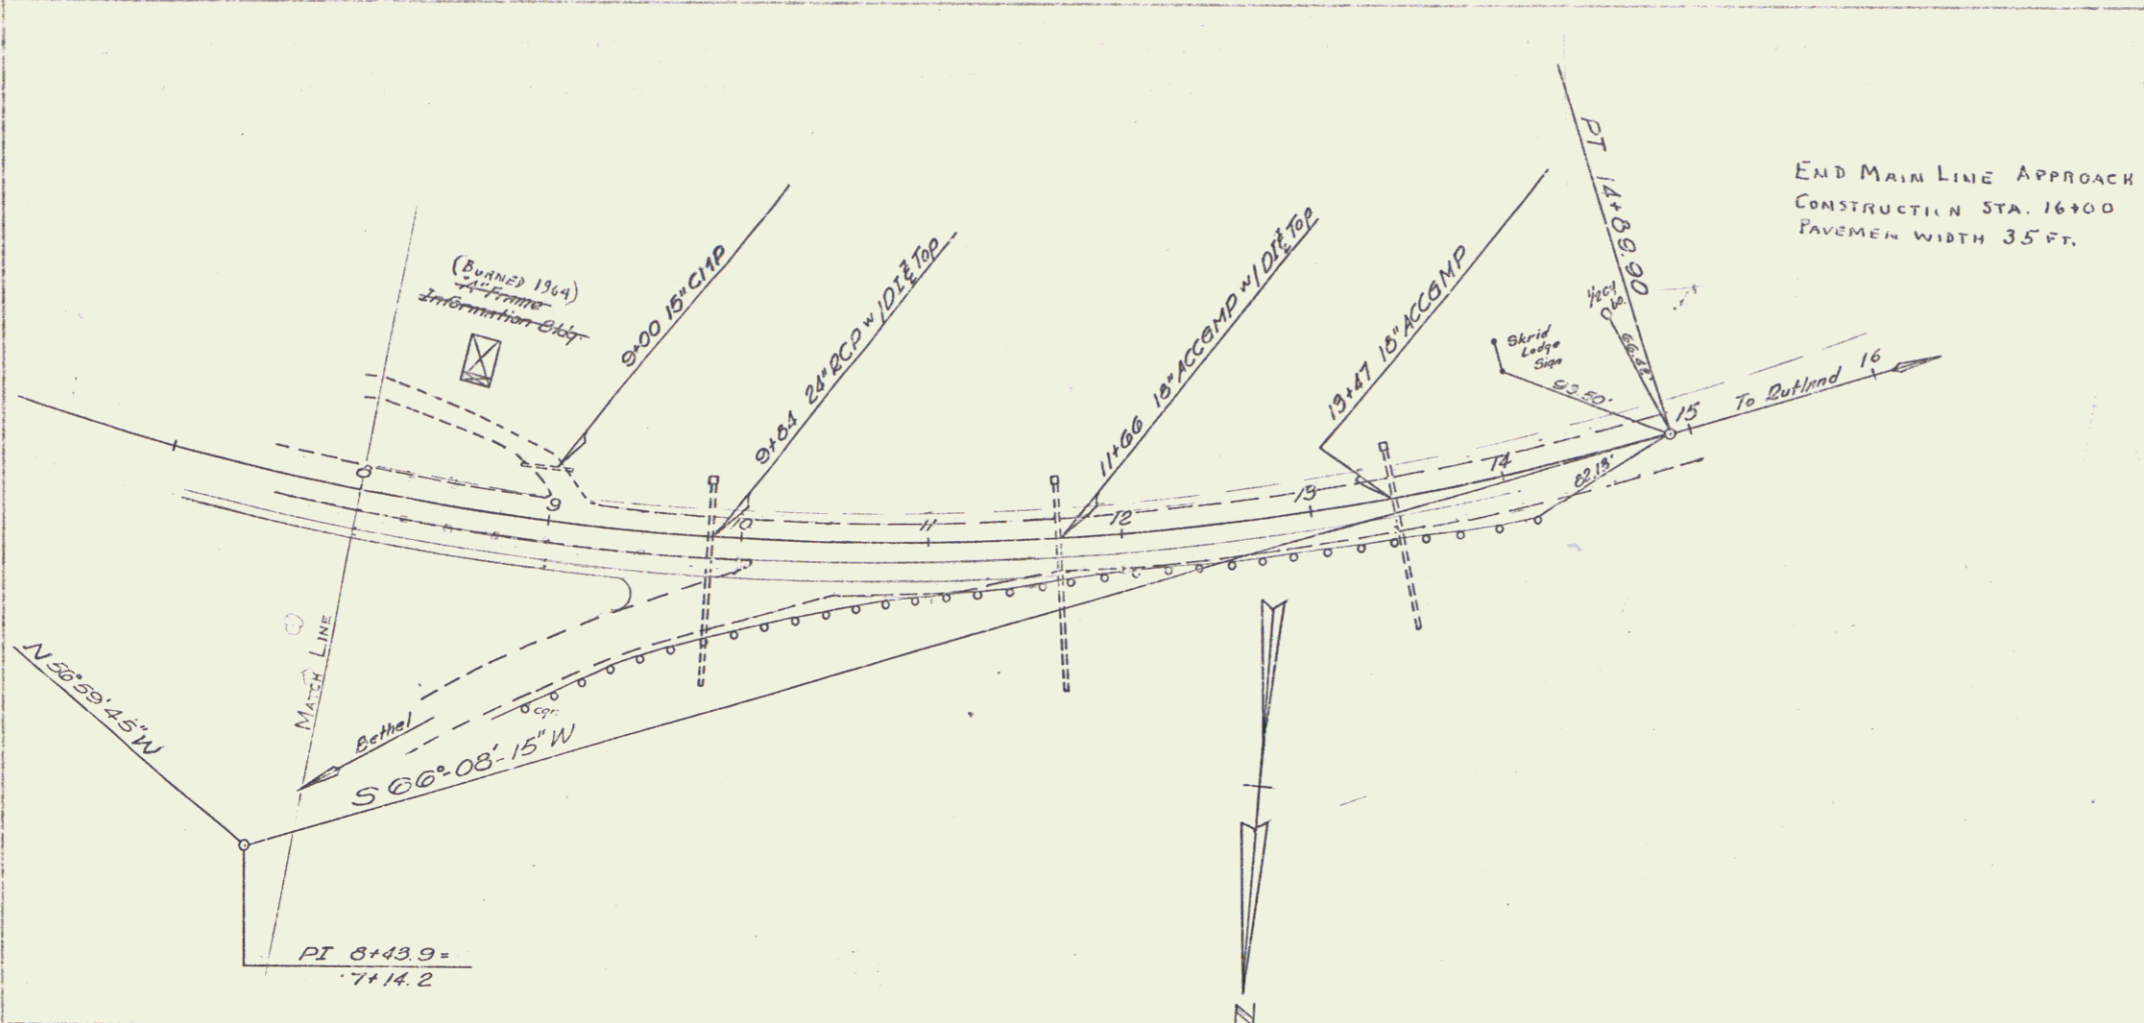

SHERBURNE  
 F 76(4)  
 F 020-2(6)  
 Sheet 34 of 216

24