



PLAN
 SHEET NO. 9
 PROJECT NAME
 SHEET NO. 9
 DATE
 DRAWN BY
 CHECKED BY
 APPROVED BY

PROFILE
 SHEET NO. 9
 PROJECT NAME
 SHEET NO. 9
 DATE
 DRAWN BY
 CHECKED BY
 APPROVED BY

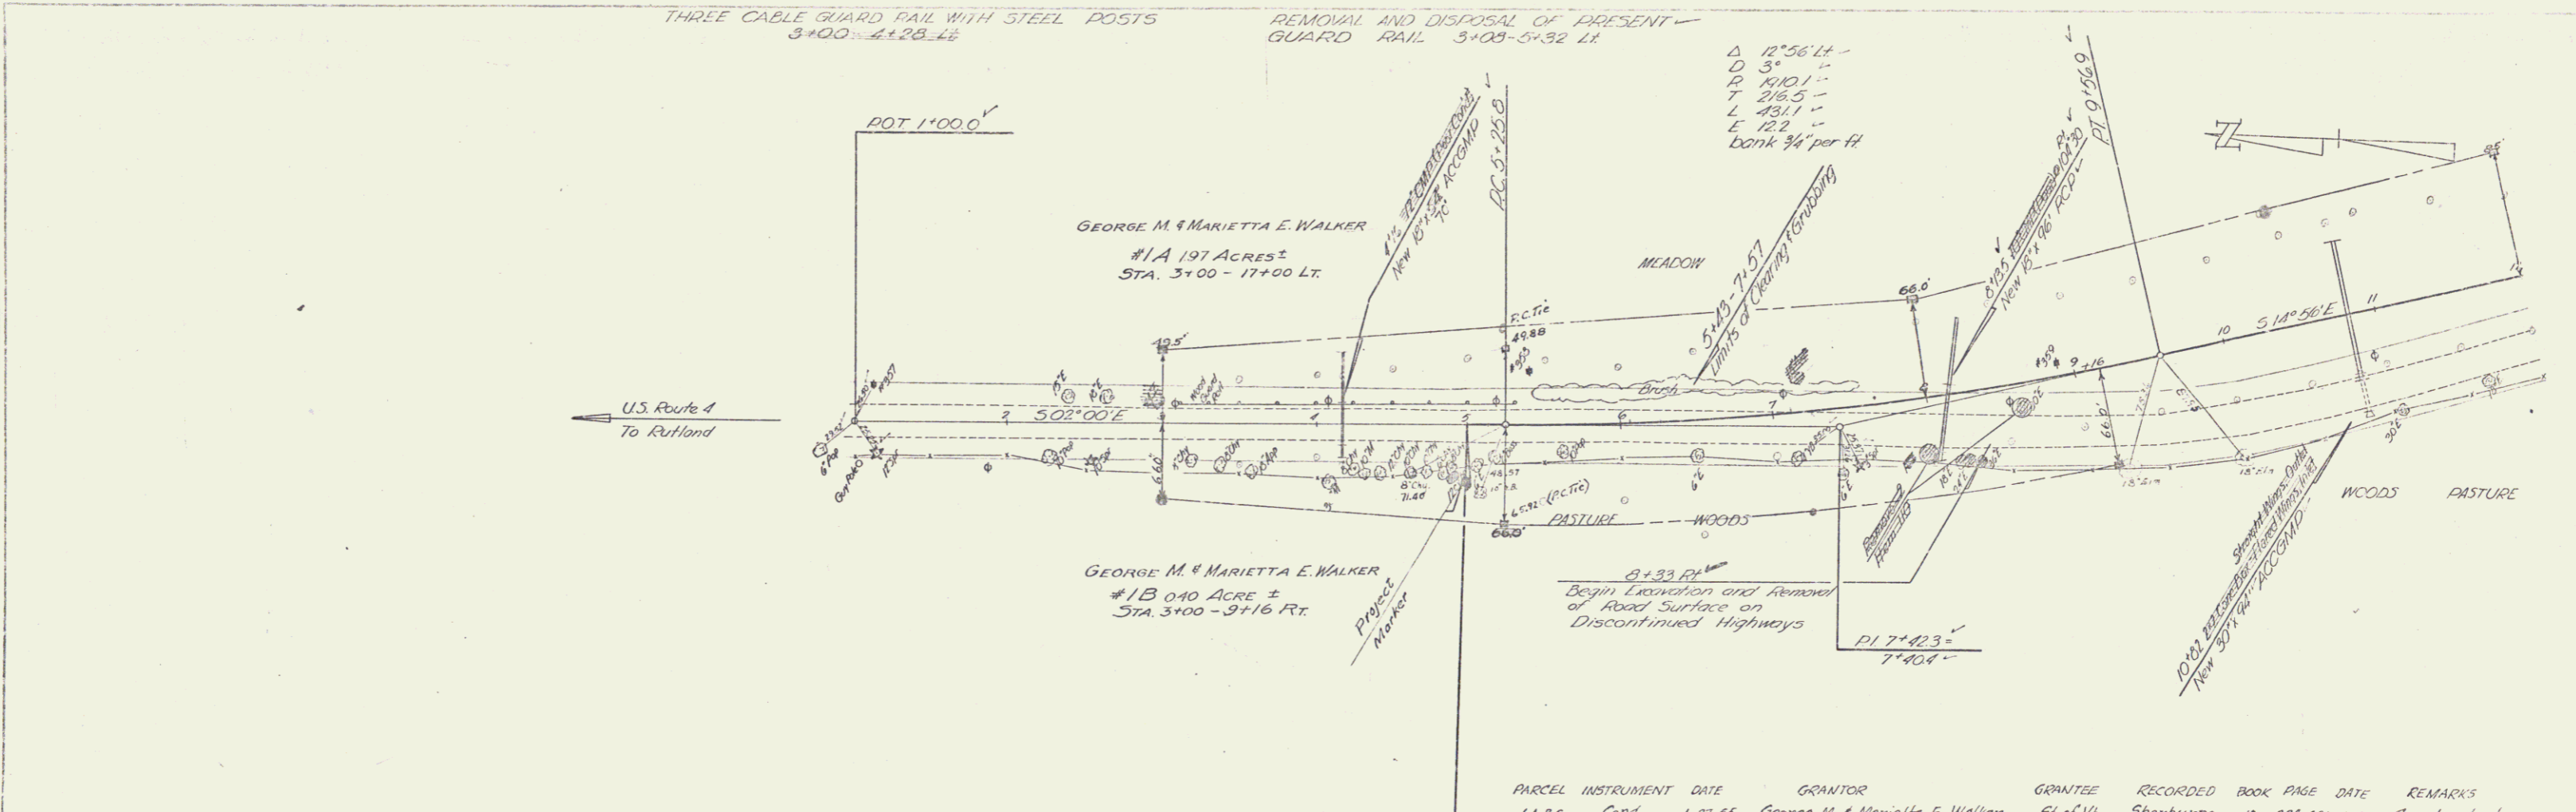

PARCEL	INSTRUMENT	DATE	GRANTOR	GRANTEE	RECORDED	BOOK	PAGE	DATE	REMARKS
1.A.B.C.	Cond.	1-27-85	George M. & Marietta E. Walker	St. of Vt.	Sherburne	10	324-328	1-29-85	See also sheet 10

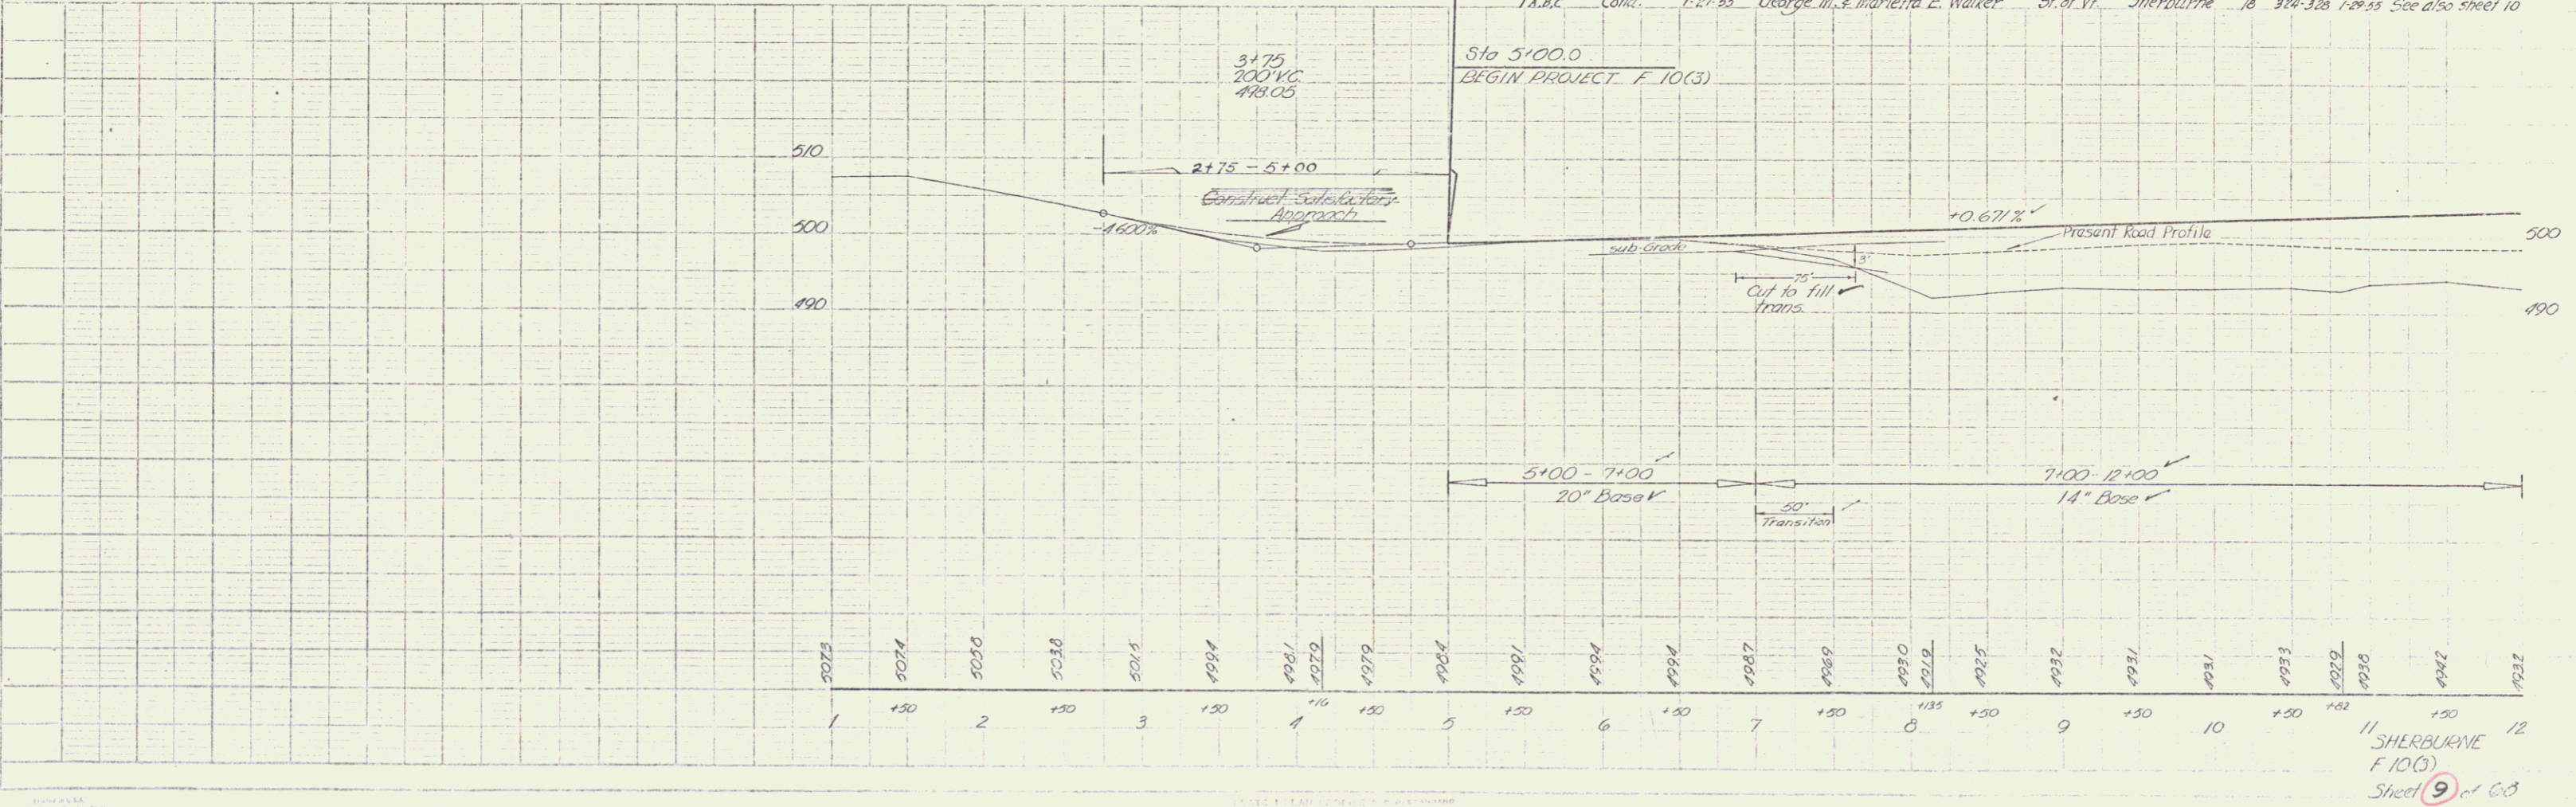

11 SHERBURNE
 F 10(3)
 Sheet 9 of 60