
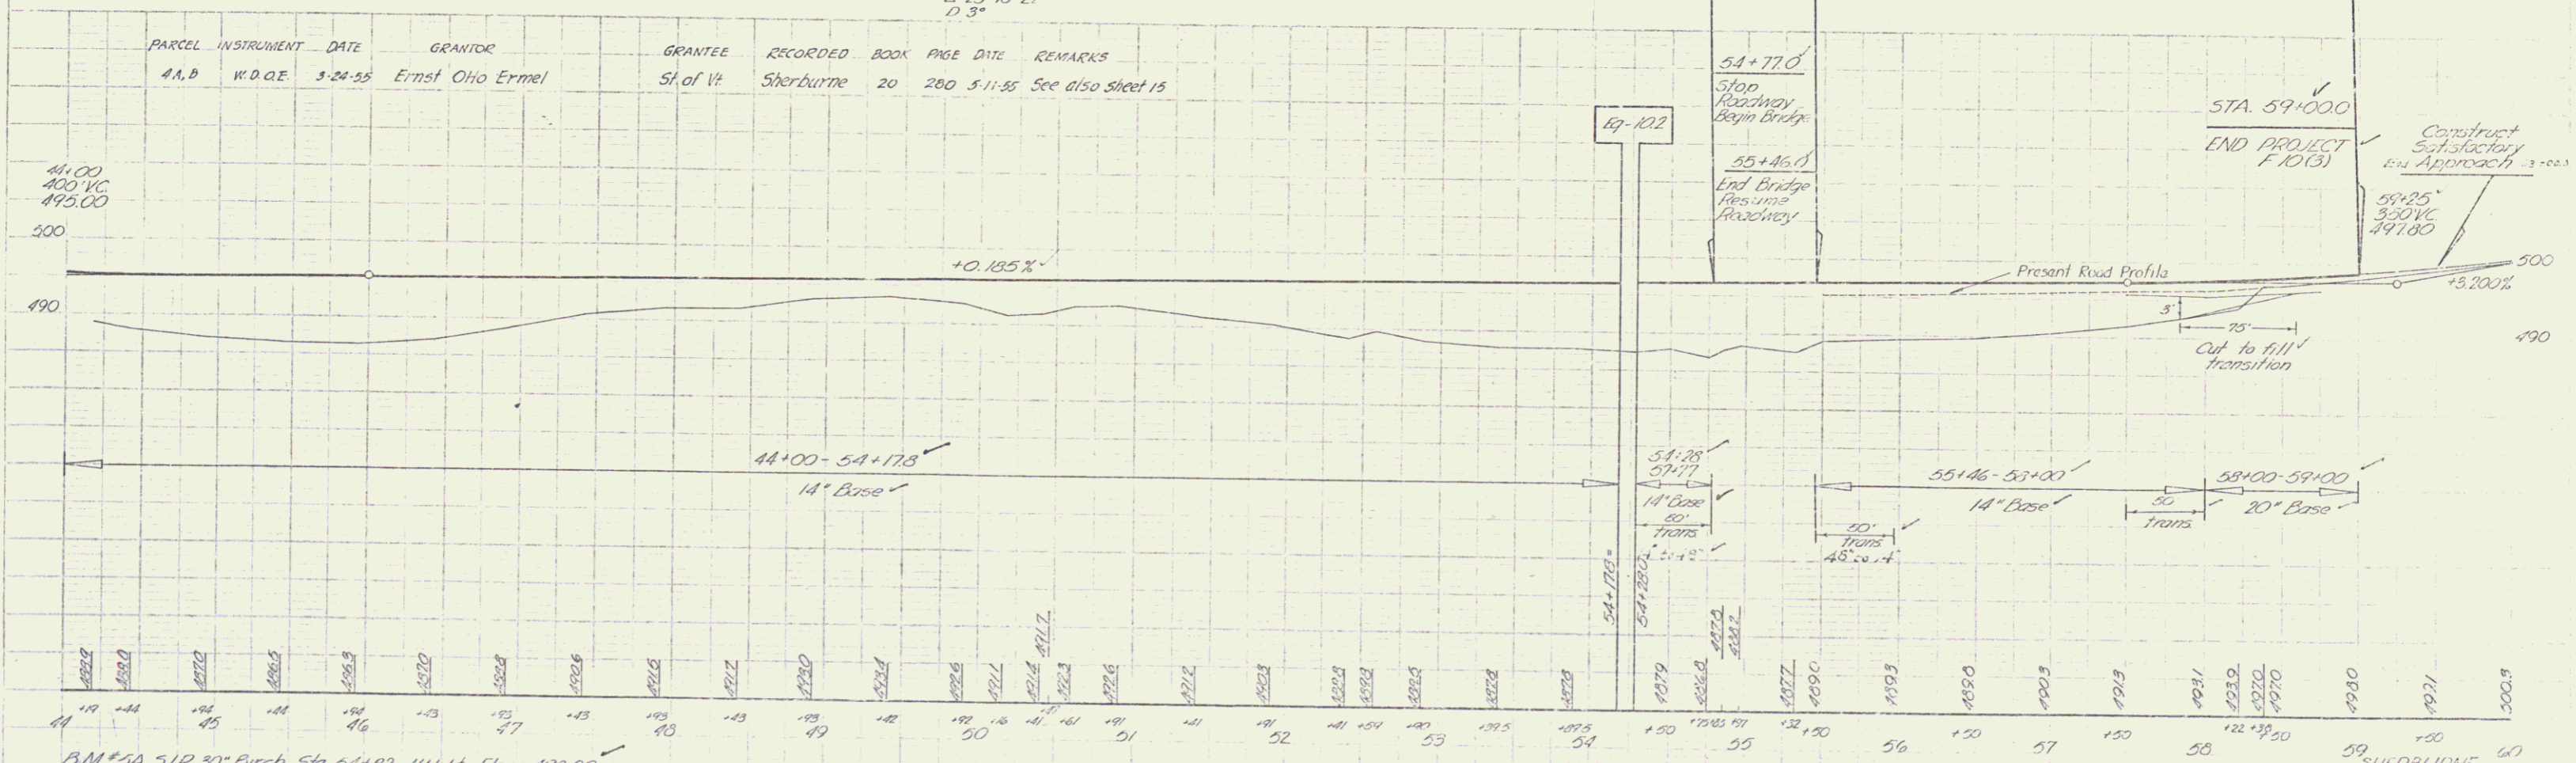


PLAN  
 SHEET NO. 12  
 OF 15 SHEETS  
 SHEET NO. 12  
 OF 15 SHEETS

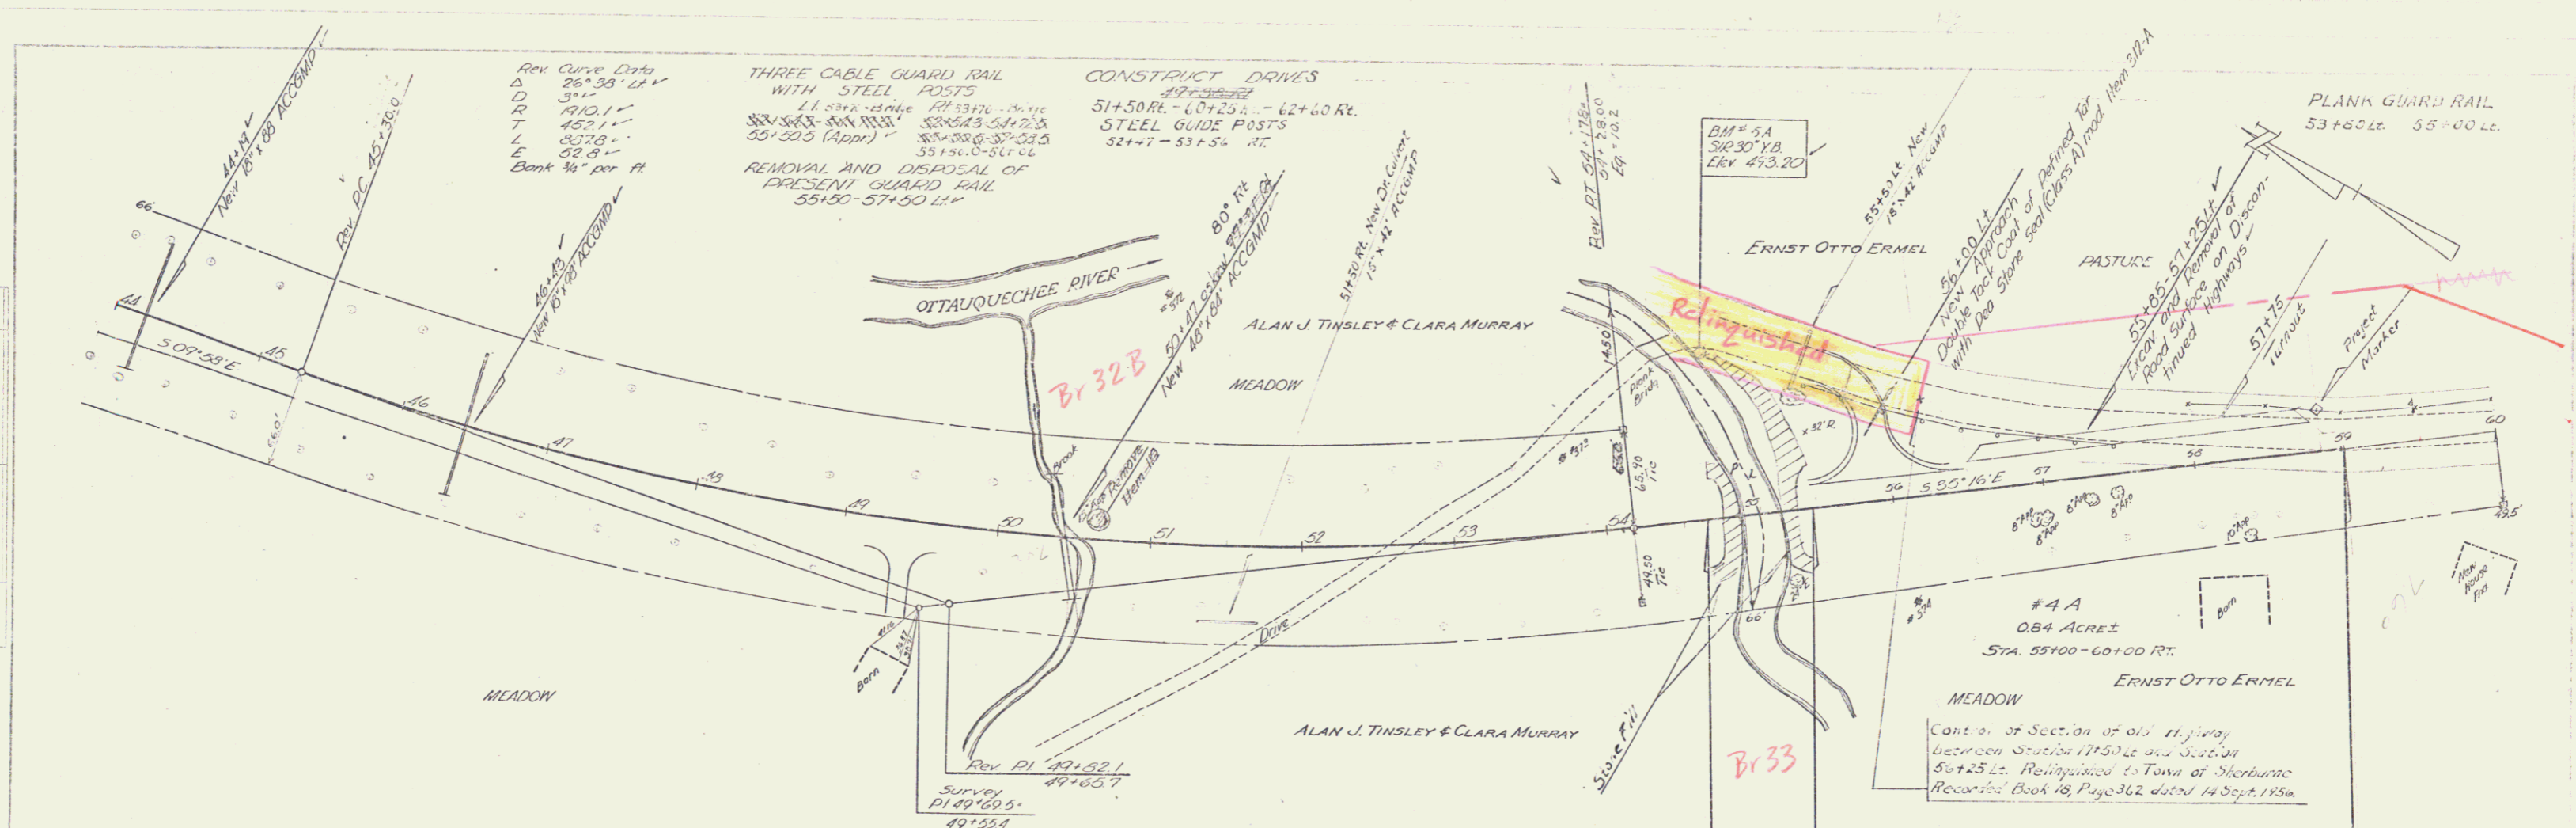

44+00 - 54+178  
 14" Base

54+178 - 55+46.1  
 14" Base

55+46.1 - 58+00  
 14" Base

58+00 - 59+00  
 20" Base

BM #5A S.I.R. 30" Birch Sta. 54+07.111' Lt. Elev. 493.20

SHERBURNE  
 F 10 (3)  
 Sheet 12 of 15