



PLAN  
 1/2" = 100'  
 1/4" = 200'  
 1/8" = 400'

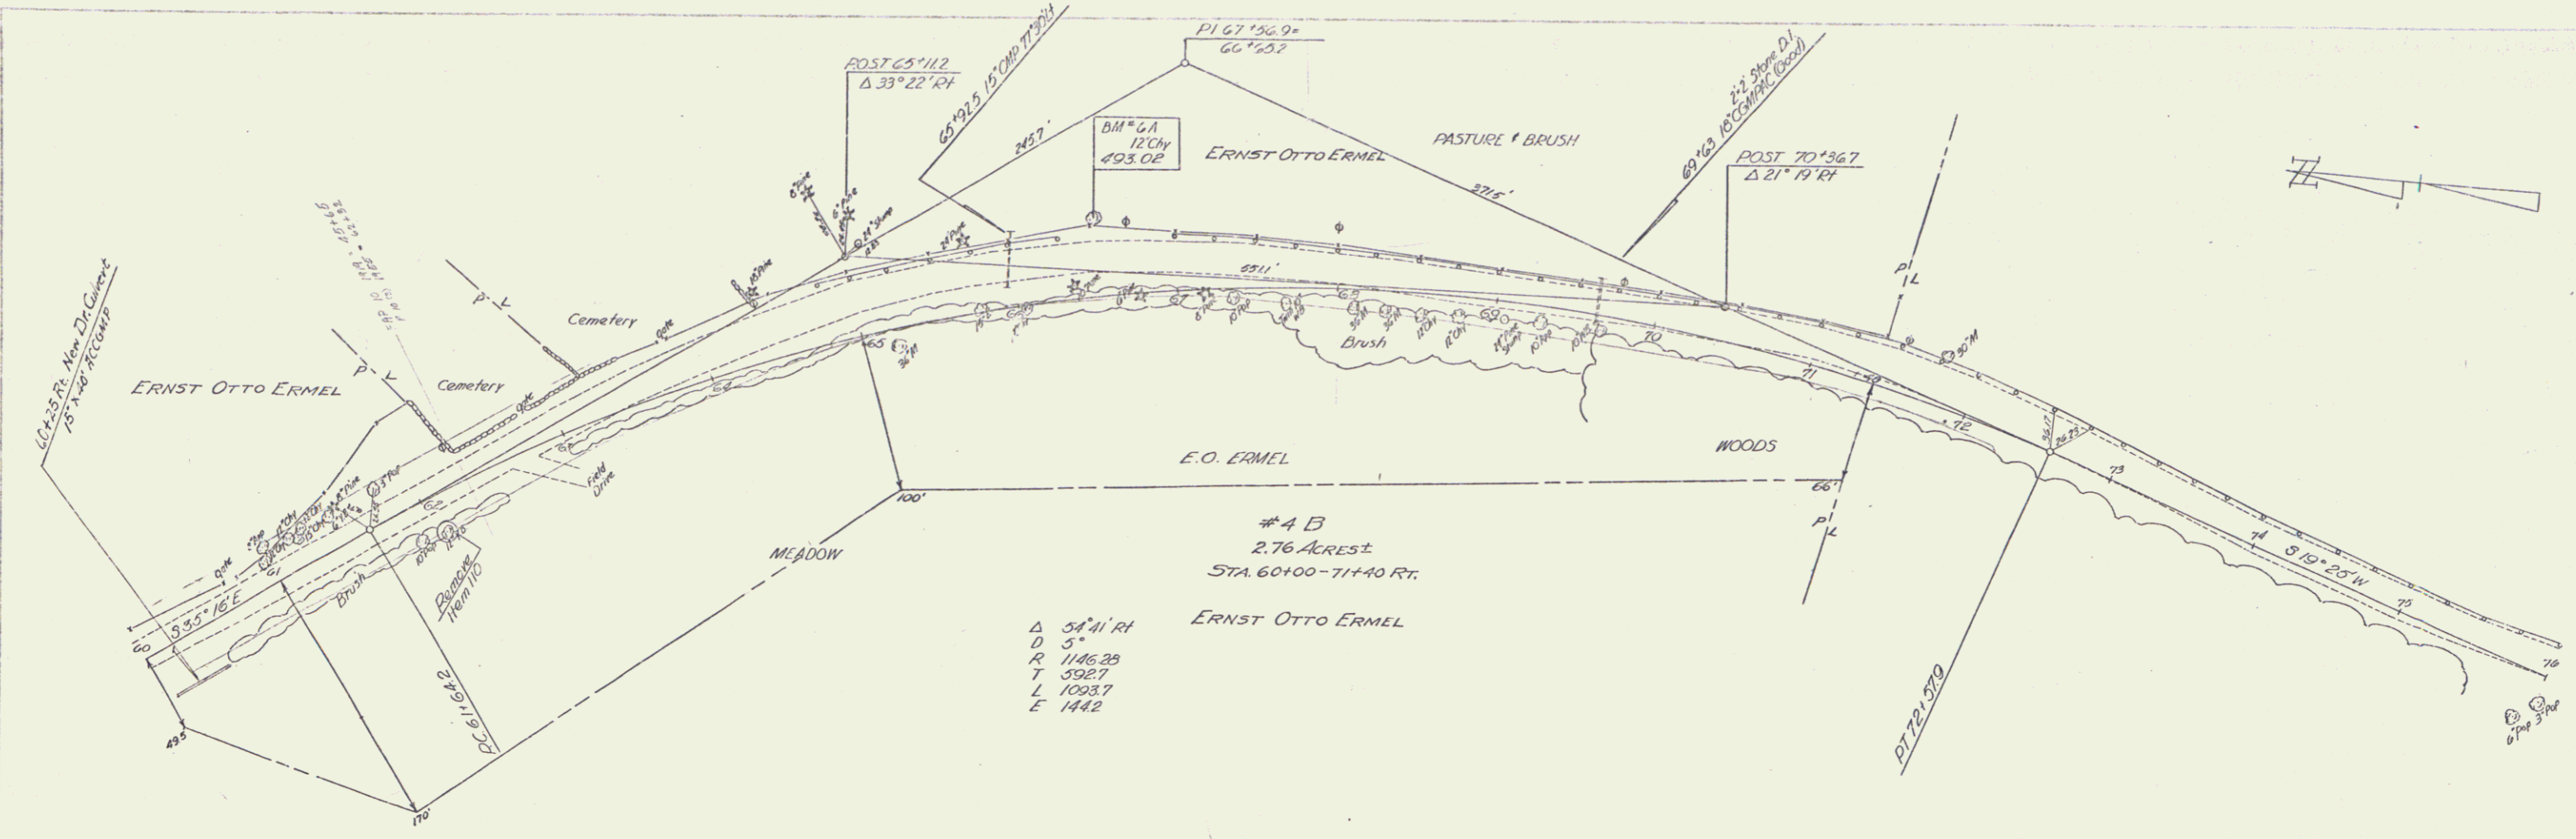

PROFILE  
 1" = 10'  
 1/4" = 20'

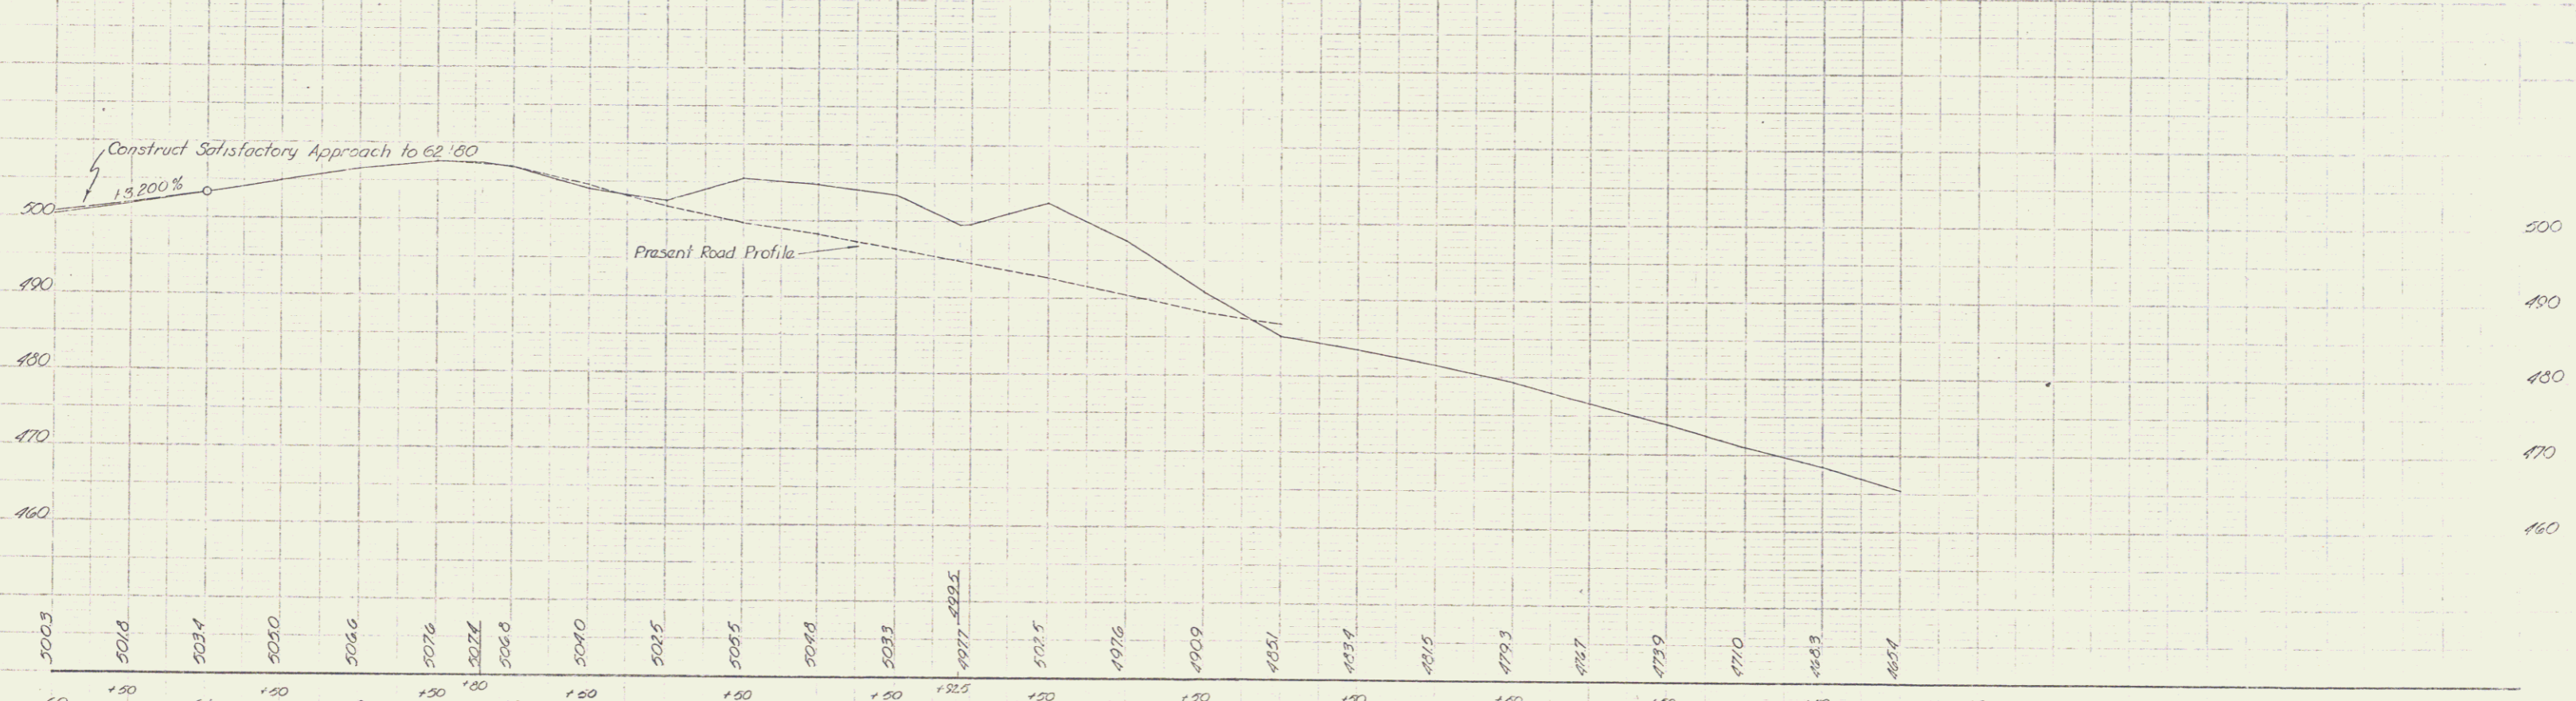

BM 6A S 1/4 12" Cherry 50' LI Sta 66+53 Elev 493.00

SHERBURNE  
 F. 10(3)  
 Sheet 15 of 68