



9/57
12/57
KALLIO
IRONS
TRACED

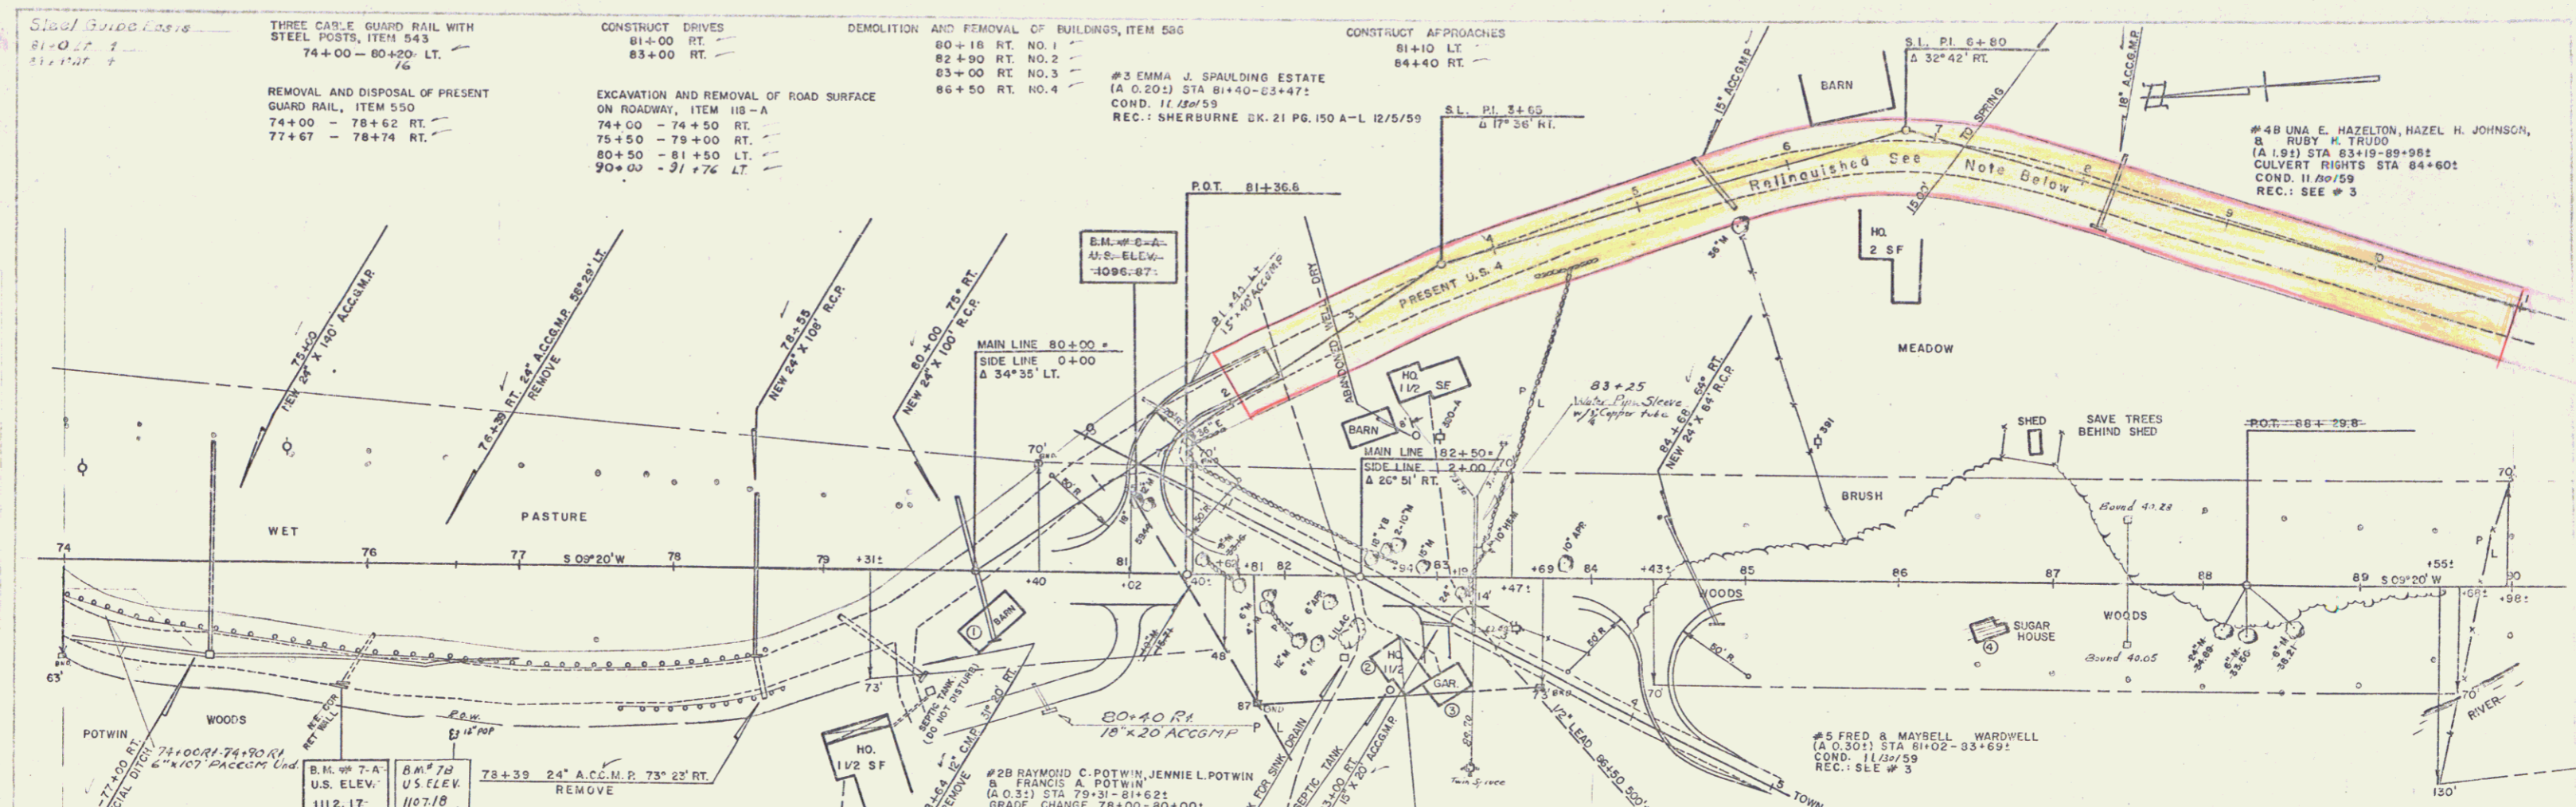

11/57
12/57
DRURY
BITTNER

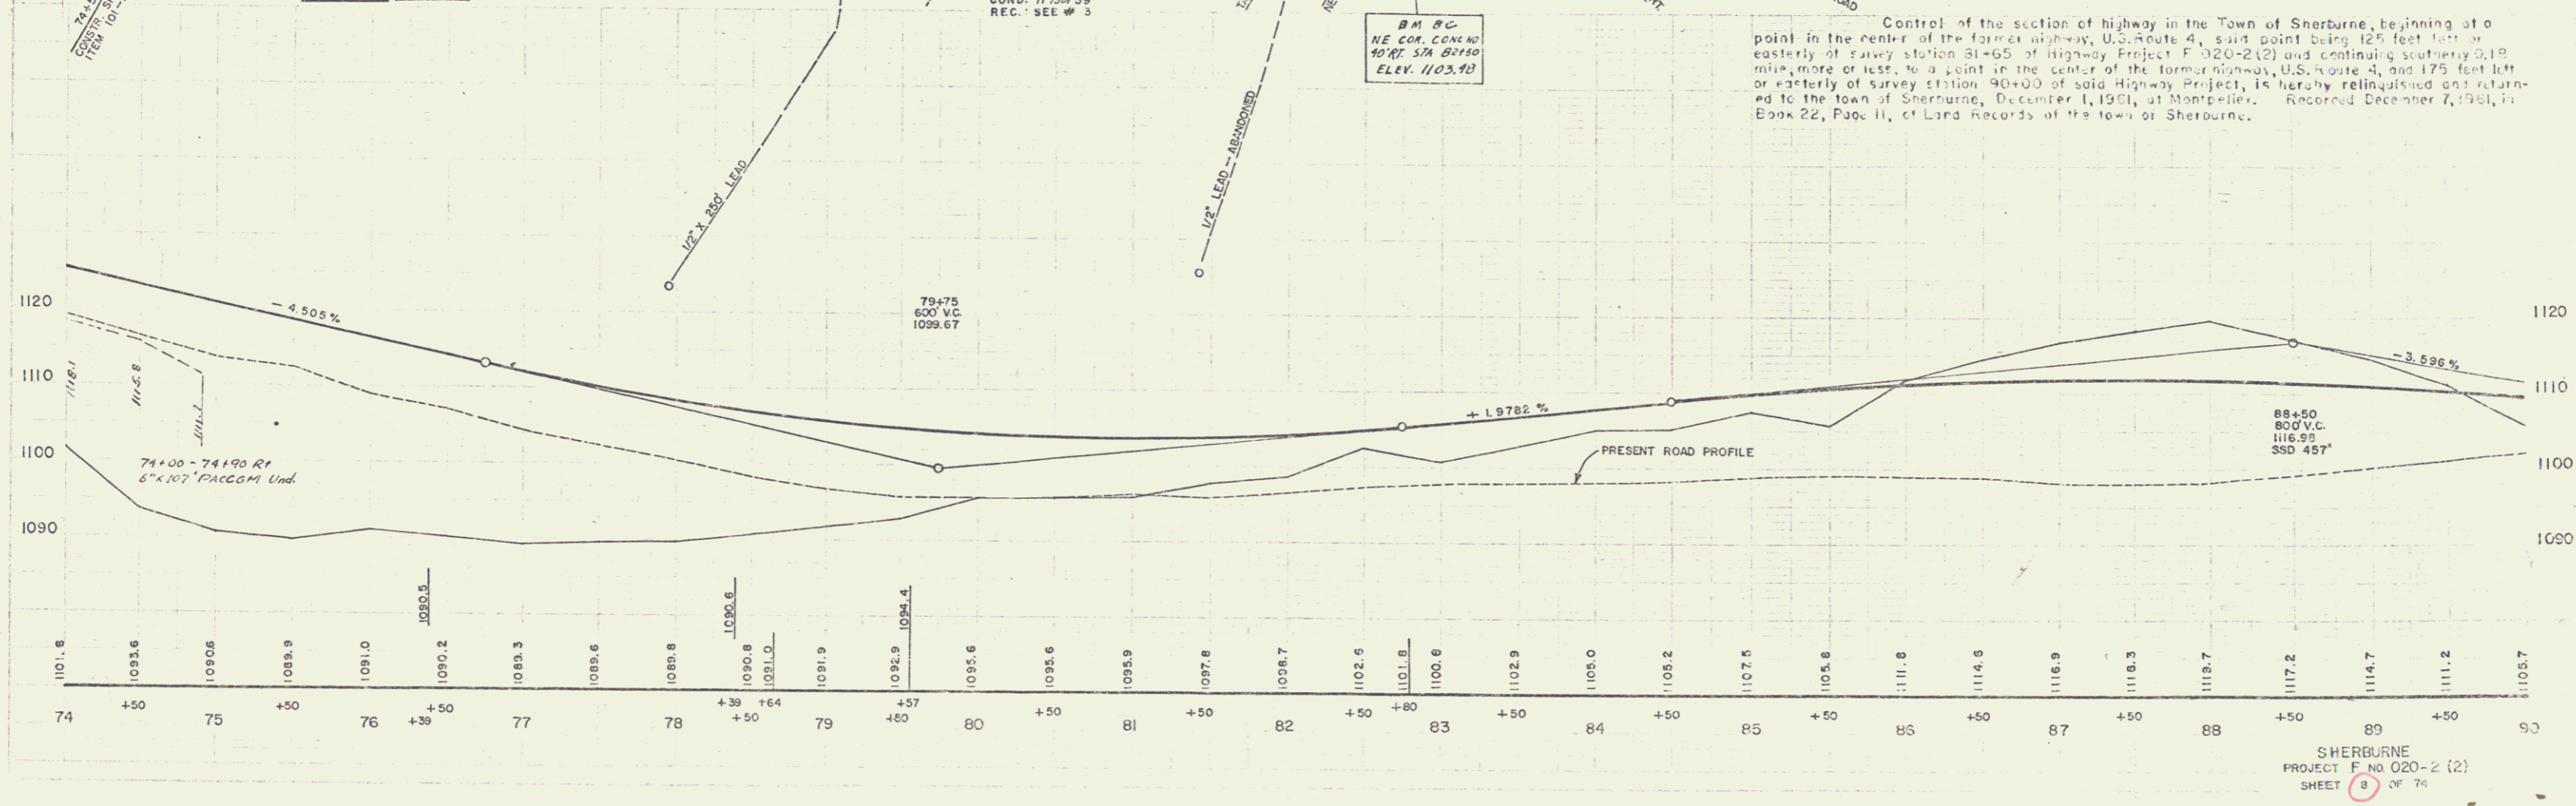

SHERBURNE
PROJECT F NO 020-2 (2)
SHEET 8 OF 76

3