
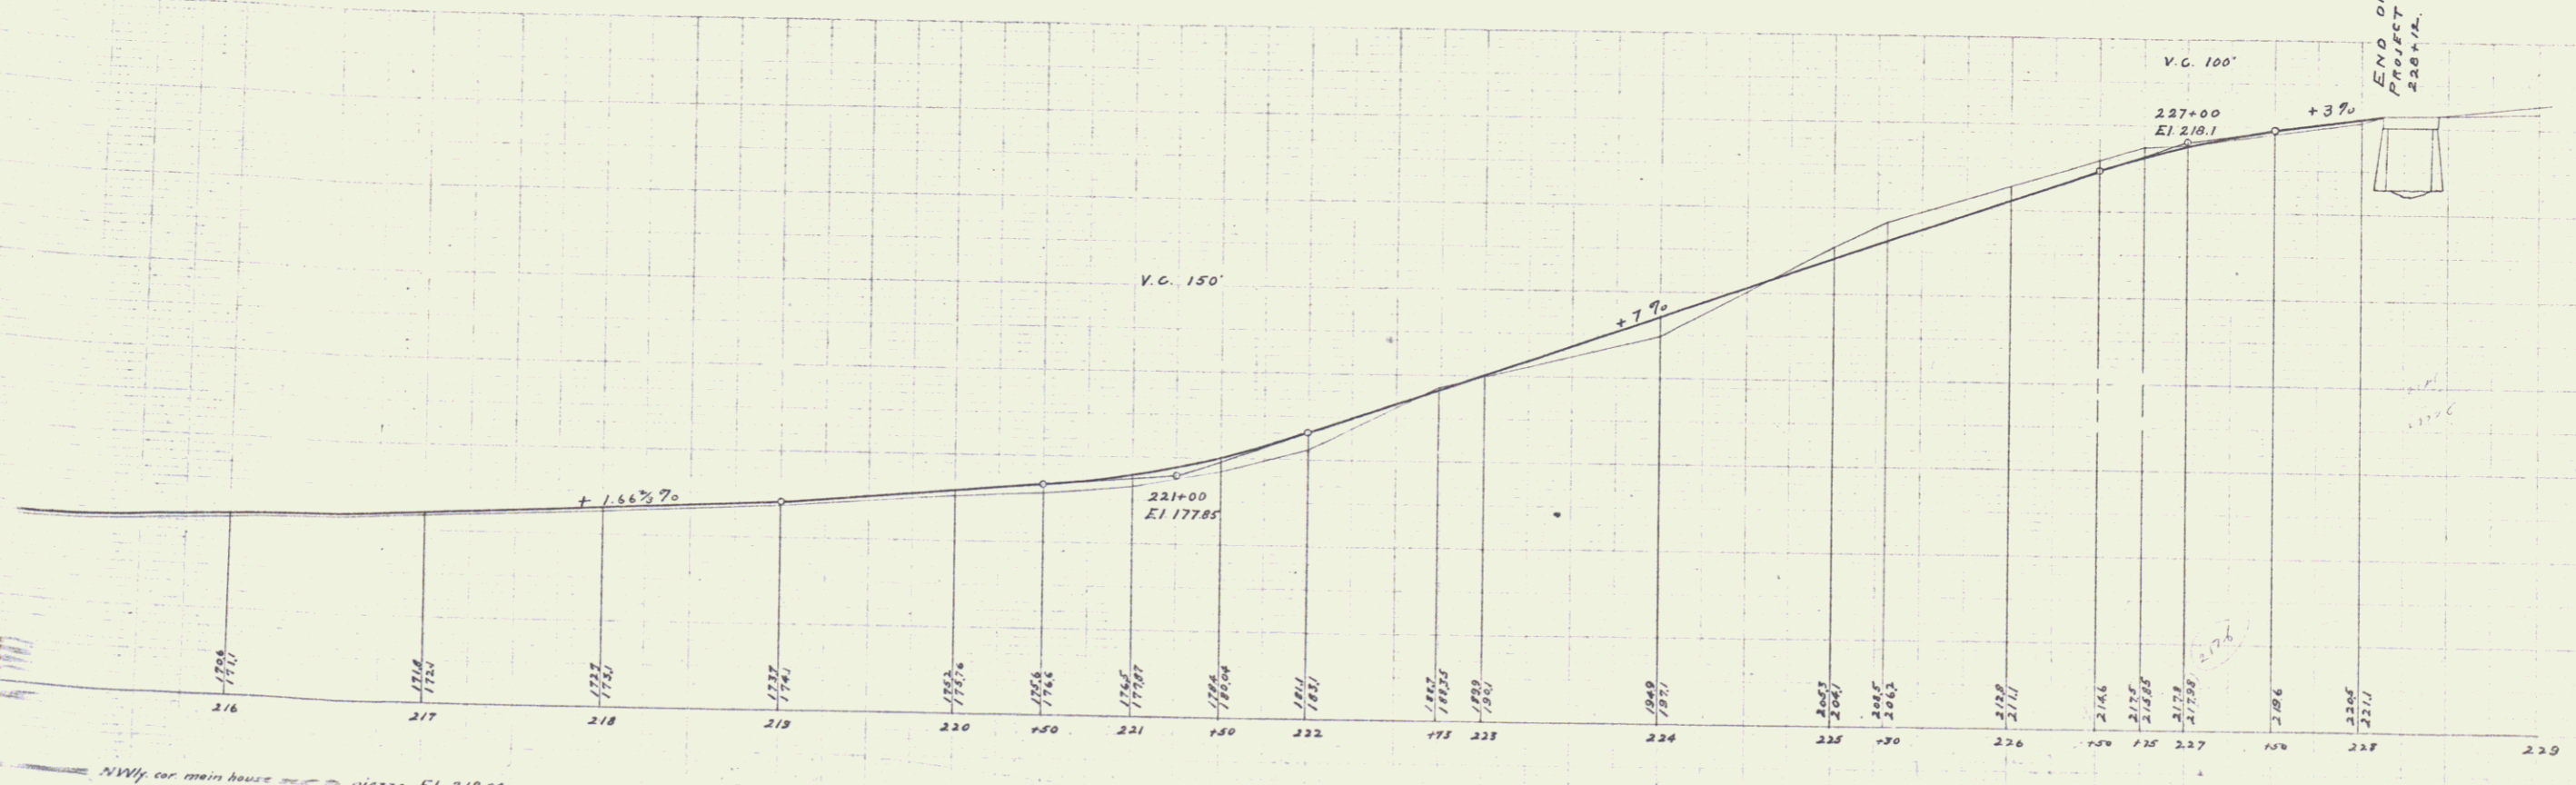


NO.	DATE	DESCRIPTION	BY	CHECKED	TOTAL
1	10	PLAN	1	1	2
2	10	FIELD	1	1	2
3	10	OFFICE	1	1	2

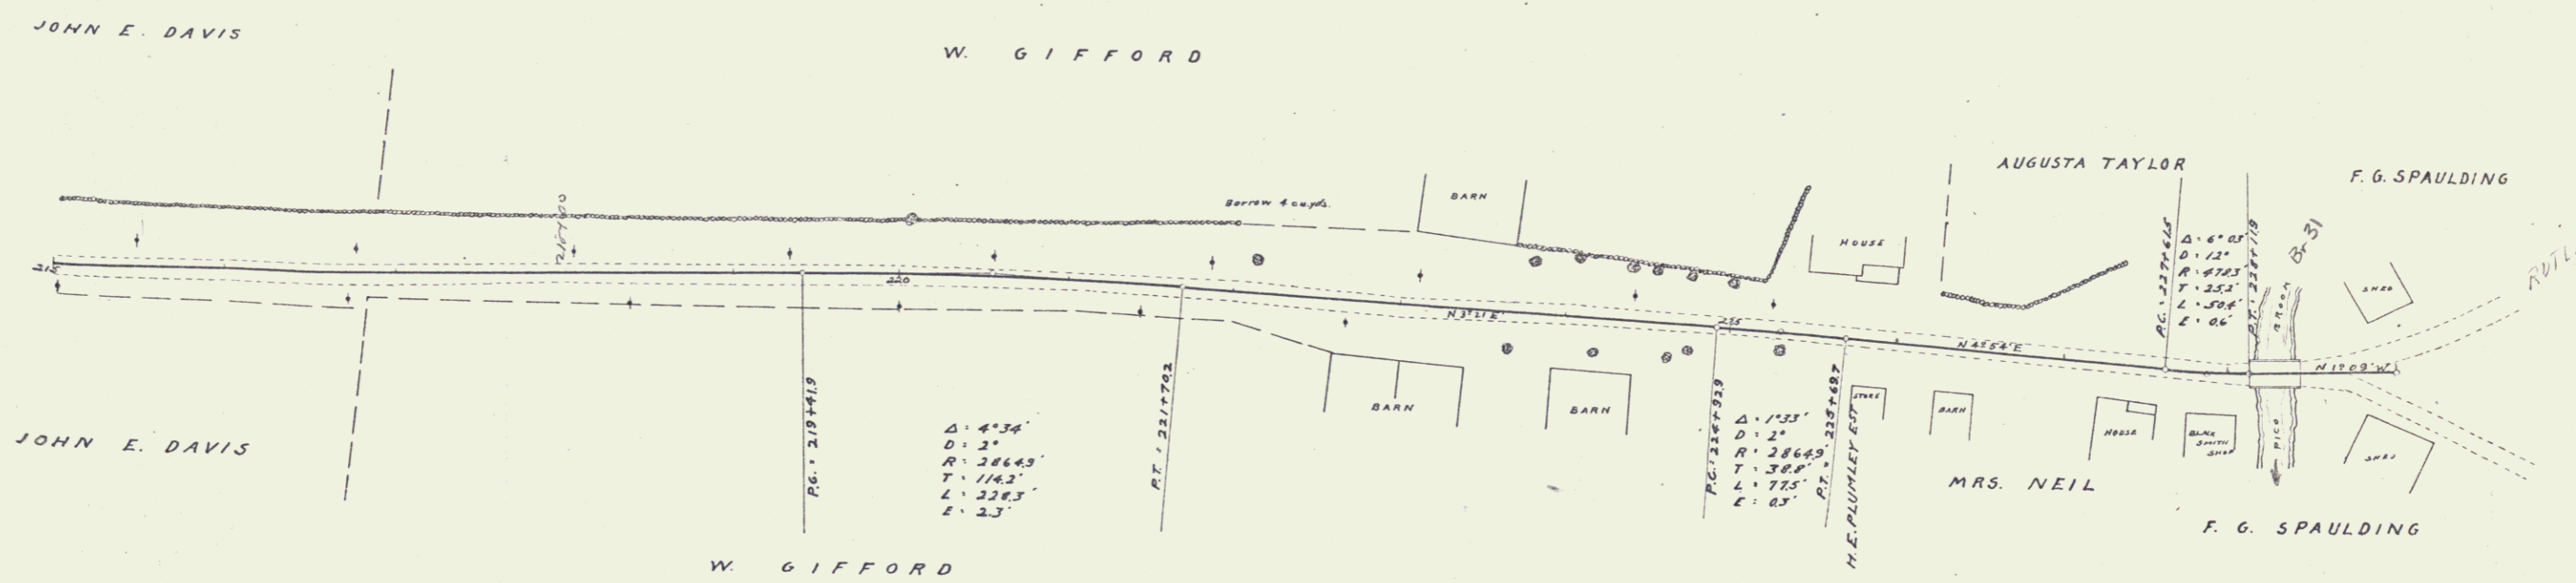

Scale 1" = 100'

16