


PROPERTY LINE FENCE WITH STEEL POSTS ITEM 563-II MOD.

STATION	STATION	POS
RAMP A 175.51	177.05 B	A
RAMP B 181.39	183.81 A	C
RAMP C 187.41	189.83 B	D

CONSTRUCT RAMP

STATION	STATION	RAMP
177.05 B	177.05 B	A
181.39	183.81 A	B
187.41	189.83 B	C
190.88	193.30 D	D

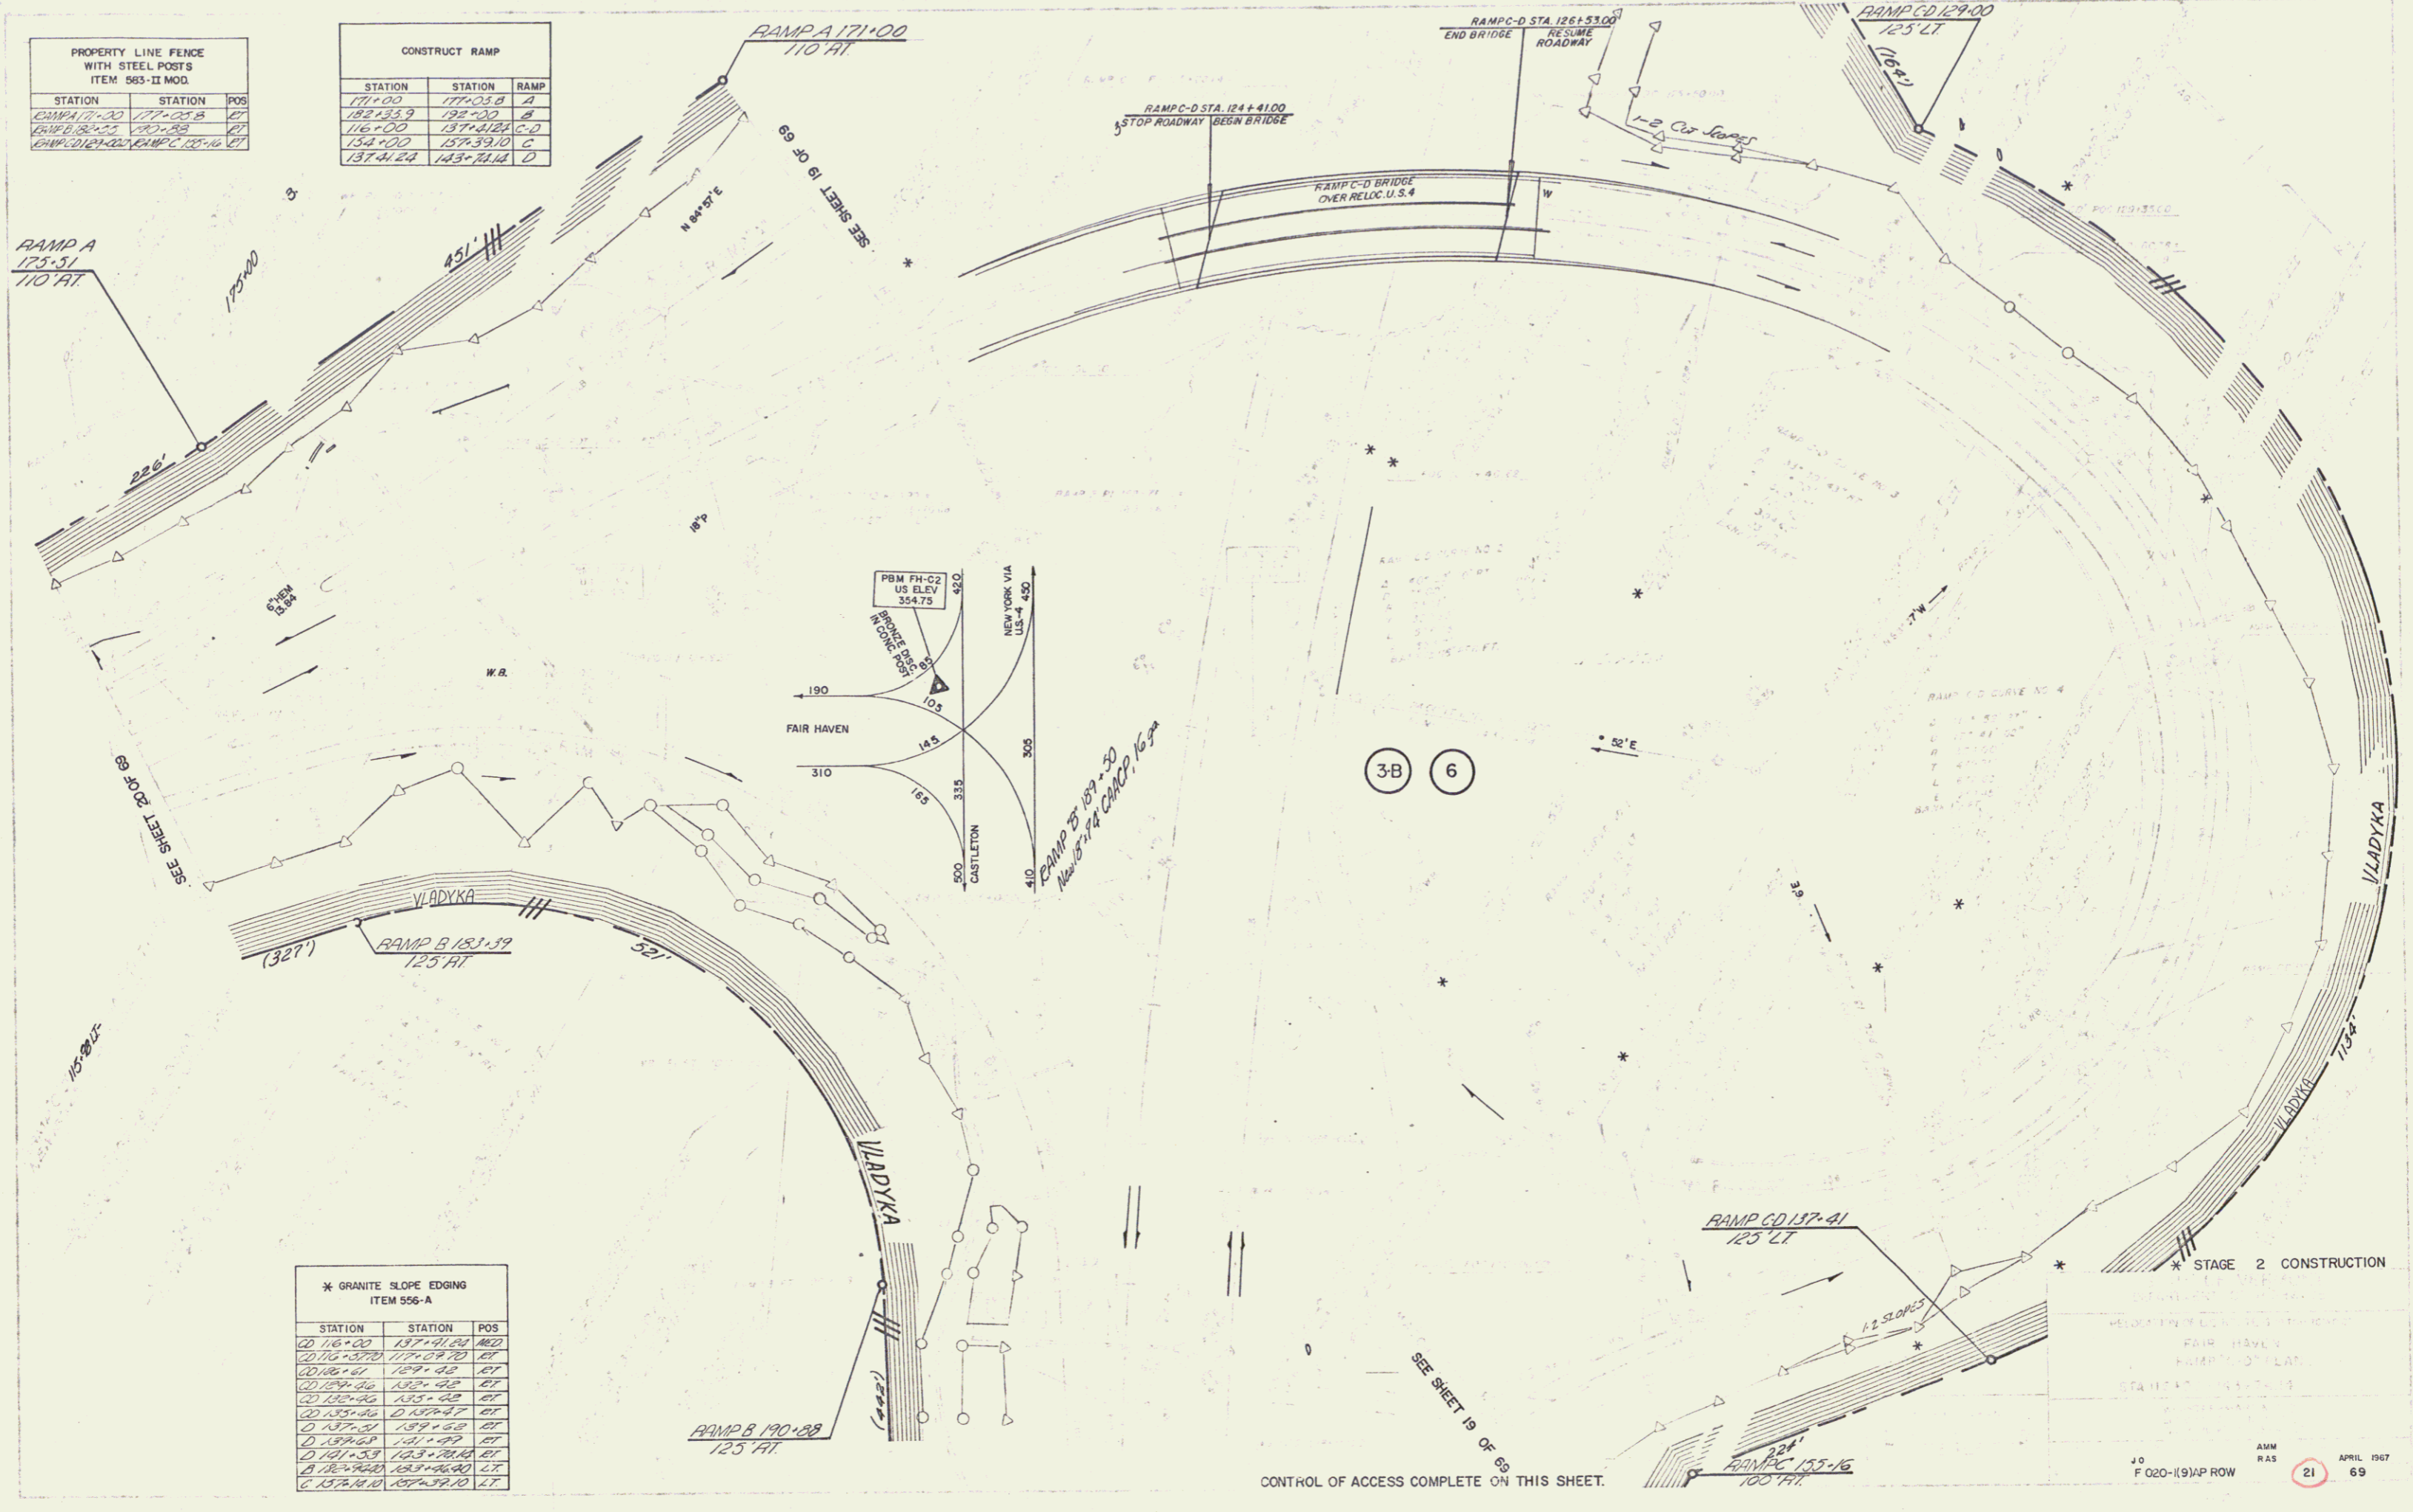

\* GRANITE SLOPE EDGING ITEM 556-A

STATION	STATION	POS
CD 116.00	117.41 A	A
CD 116.37	117.78 B	B
CD 116.74	118.15 C	C
CD 117.11	118.52 D	D
CD 117.48	118.89 E	E
CD 117.85	119.26 F	F
CD 118.22	119.63 G	G
CD 118.59	120.00 H	H
CD 118.96	120.37 I	I
CD 119.33	120.74 J	J
CD 119.70	121.11 K	K
CD 120.07	121.48 L	L
CD 120.44	121.85 M	M
CD 120.81	122.22 N	N
CD 121.18	122.59 O	O
CD 121.55	122.96 P	P
CD 121.92	123.33 Q	Q
CD 122.29	123.70 R	R
CD 122.66	124.07 S	S
CD 123.03	124.44 T	T
CD 123.40	124.81 U	U
CD 123.77	125.18 V	V
CD 124.14	125.55 W	W
CD 124.51	125.92 X	X
CD 124.88	126.29 Y	Y
CD 125.25	126.66 Z	Z

AMM RAS APRIL 1967  
F 020-(19)AP ROW 21 69