


* GRANITE SLOPE EDGING ITEM 556-A		
STATION	STATION	POS
WB 1020+00	1020+50	LT
WB 1021+00	1021+50	LT

CONSTRUCT SPEED CHANGE LANE (INCL. TAPER)		
STATION	STATION	POS
WB 1022+00	1023+50	LT
WB 1023+00	1023+50	LT

CONSTRUCT RAMP		
STATION	STATION	RAMP
WB 1024+00	1024+00	C
WB 1025+00	1025+00	B

PROPERTY LINE FENCE WITH STEEL POSTS ITEM 555-II MOD			
STATION	POS	STATION	POS
WB 1024+00	WB 1024+00	WB 1024+00	WB 1024+00
WB 1025+00	WB 1025+00	WB 1025+00	WB 1025+00
WB 1026+00	WB 1026+00	WB 1026+00	WB 1026+00
WB 1027+00	WB 1027+00	WB 1027+00	WB 1027+00

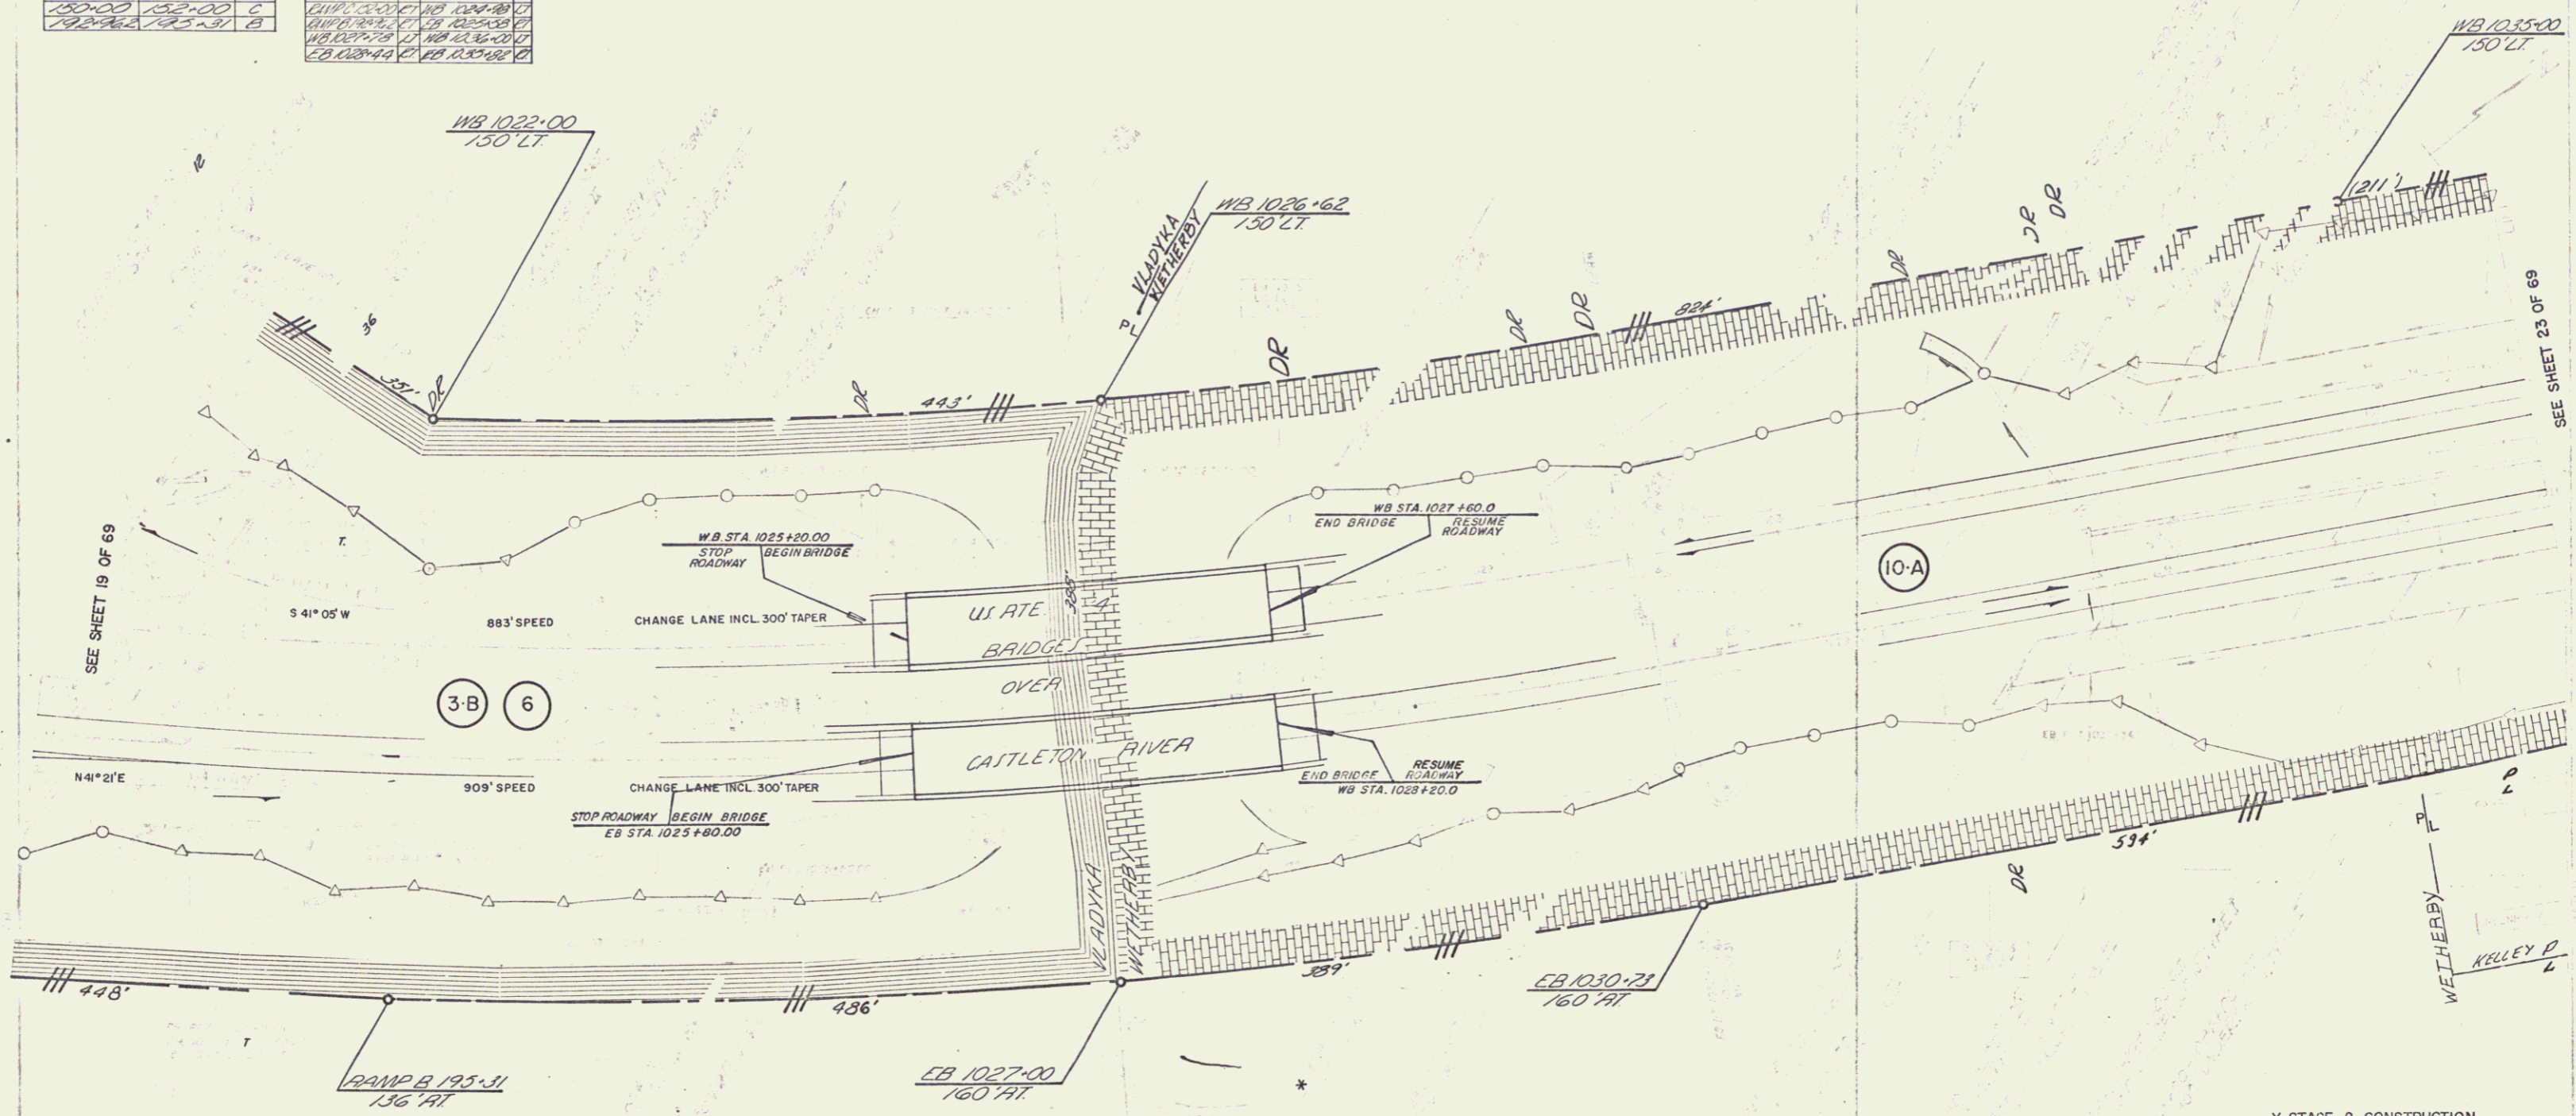

SEE SHEET 19 OF 69

SEE SHEET 23 OF 69

CONTROL OF ACCESS COMPLETE ON THIS SHEET.

* STAGE 2 CONSTRUCTION

STATE OF ILLINOIS
DEPARTMENT OF TRANSPORTATION
RELAXATION OF ACCESS RESTRICTIONS
FAIR HAZEL
PLAN
STA 1020+00.00 TO 1027+00.00

AMM
RAS
APRIL 1967
F 020-1(19)AP ROW 22 69

8