
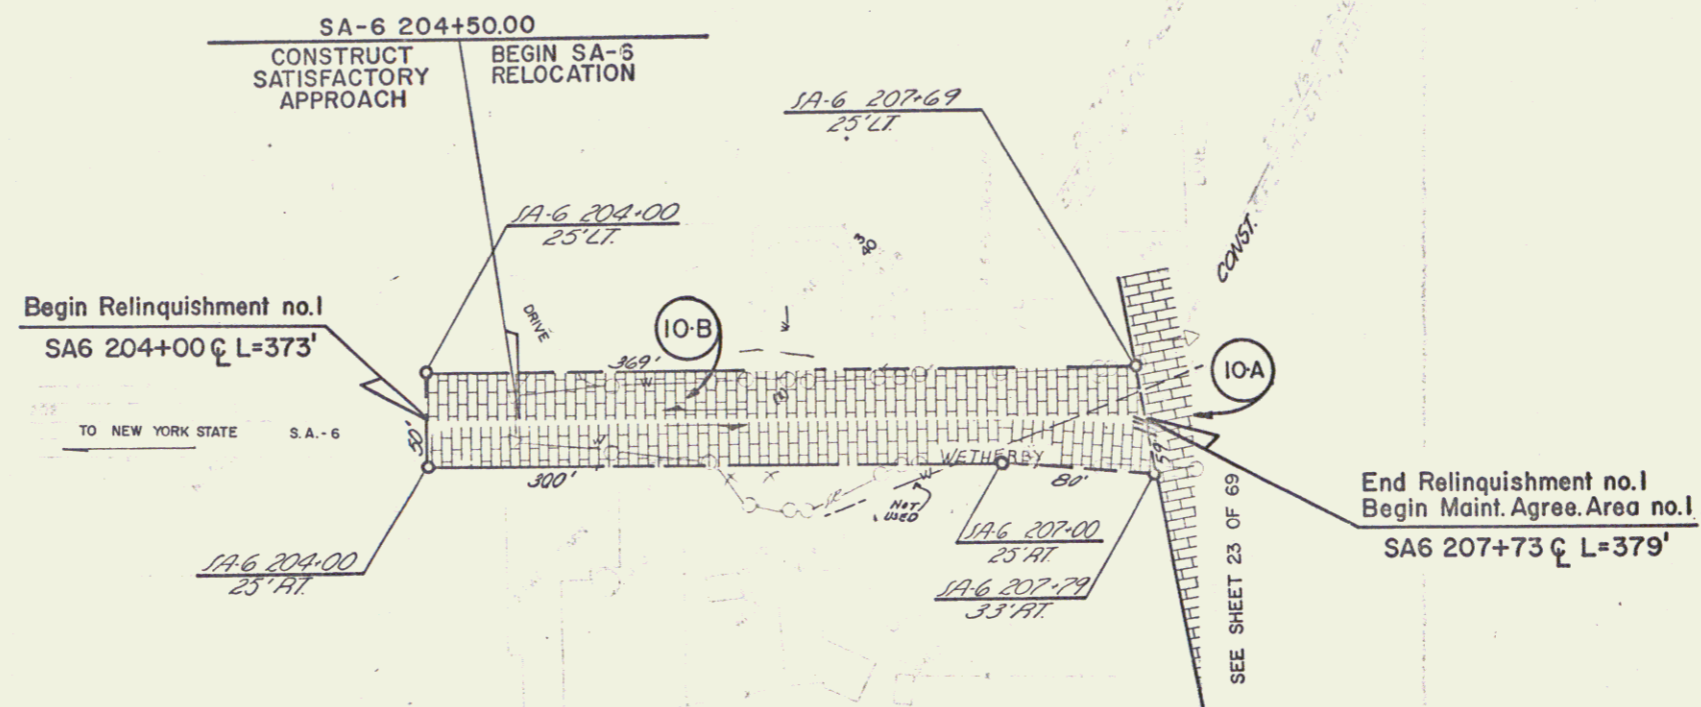



| CONSTRUCT DRIVE |     |
|-----------------|-----|
| STATION         | POS |
| 208+70          | LT  |
| 205+68          | RT  |
| 206+20          | LT  |

| DEMOLITION AND DISPOSAL OF BUILDING ITEM 566 |     |
|--|-----|
| STATION                                      | POS |
| 1A-6 207+77                                  | LT  |

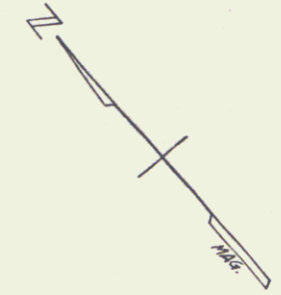

\* STAGE 2 CONSTRUCTION

RELOCATION OF US ROUTE 4 in the town of  
FAIR HAVEN  
SA-6  
PLAN  
STA. 202+00.00 - 208+00.00

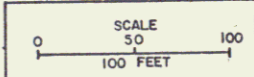

AMM RAS APRIL 1967  
F 020-1(9)AP ROW 24 69