


CONSTRUCT DRIVE	
STA	POS
426+10	LT

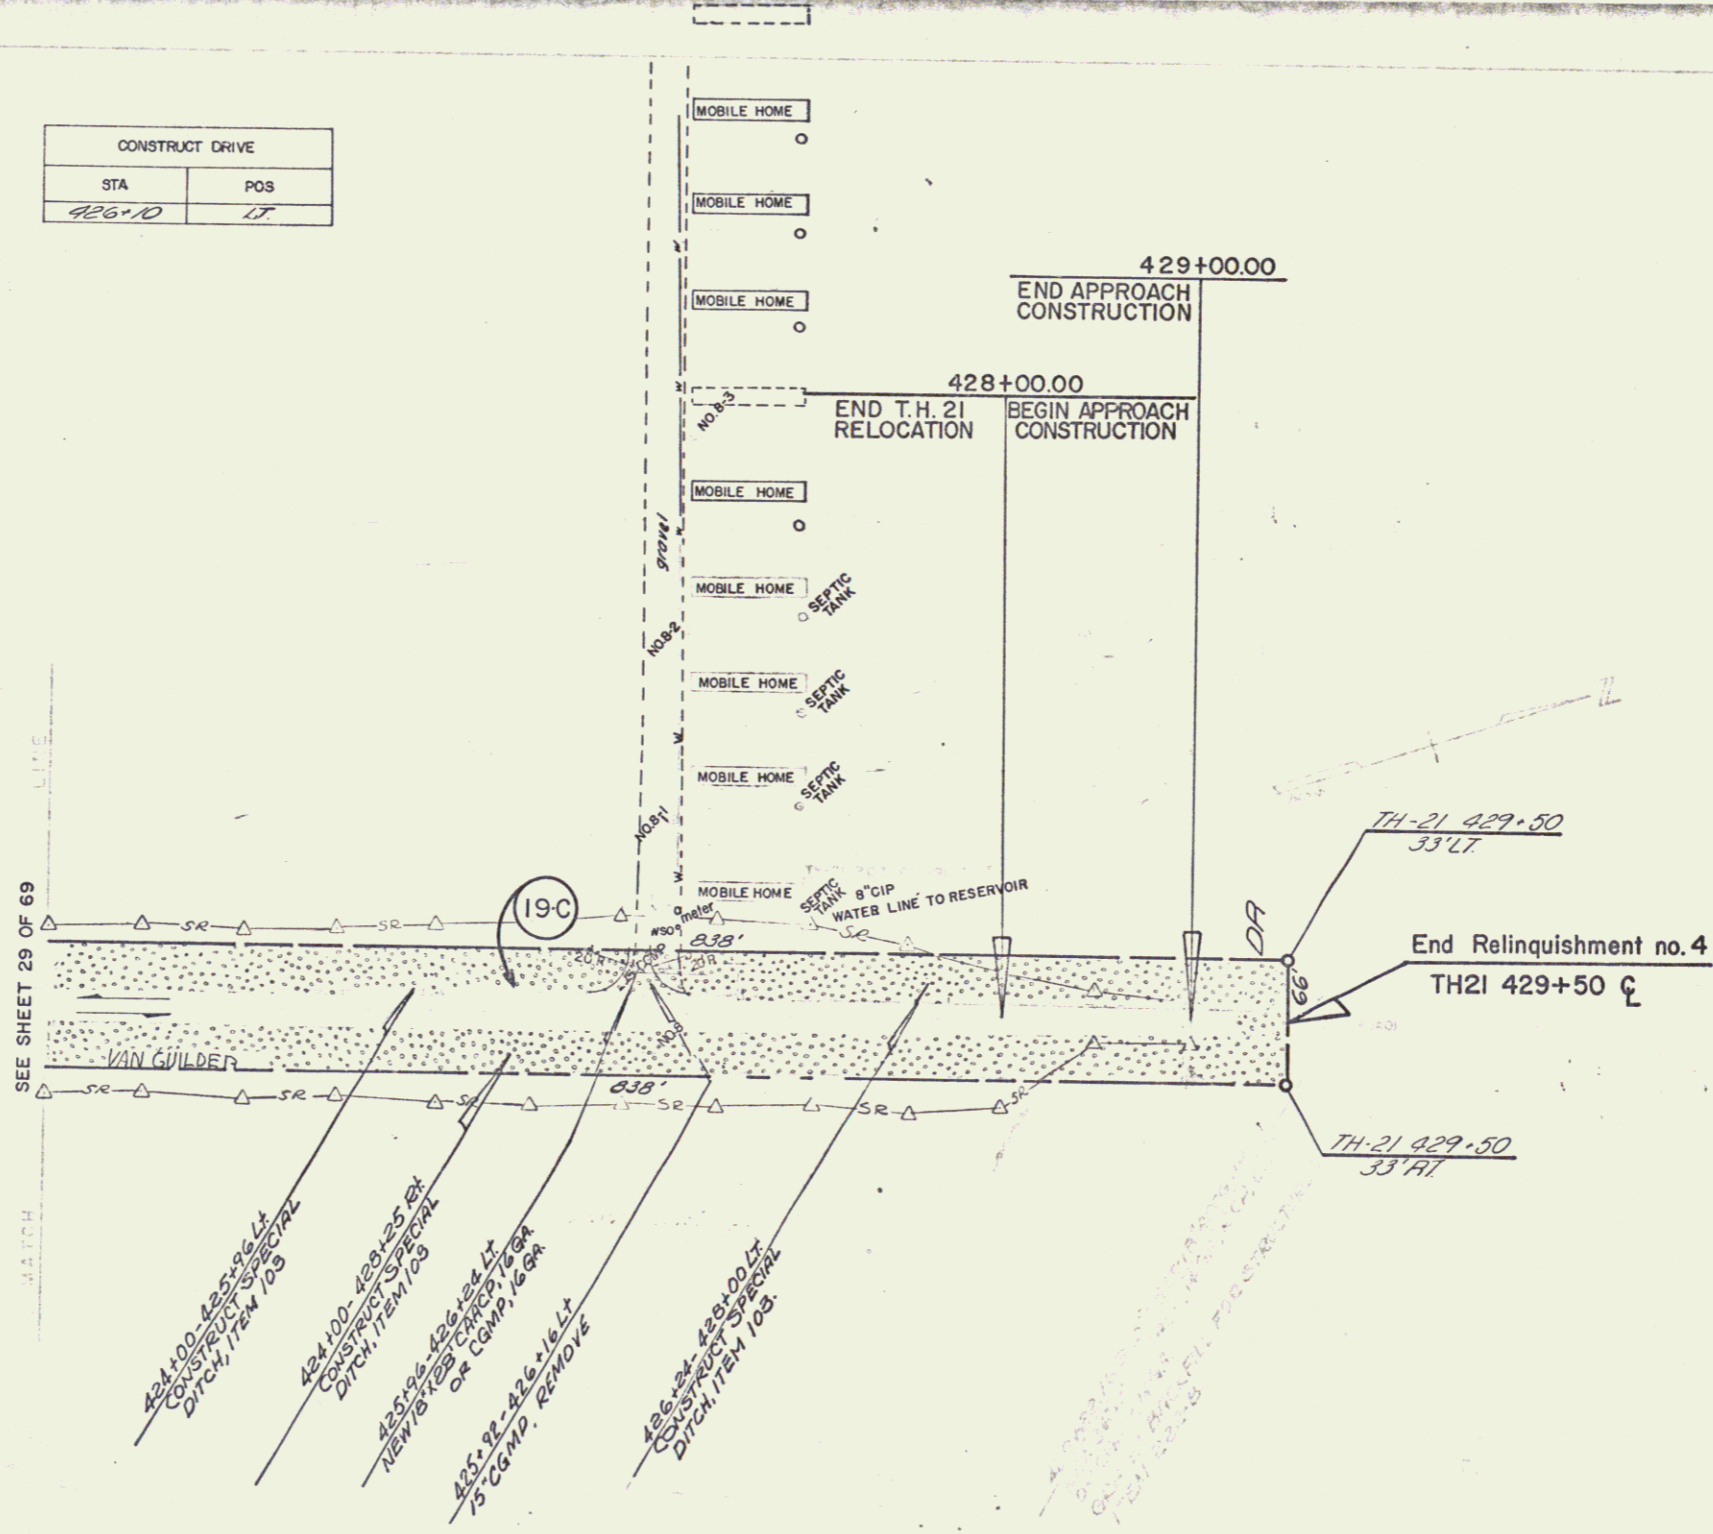

SEE SHEET 29 OF 69

424+00-425+06 LT  
CONSTRUCT SPECIAL  
DITCH, ITEM 103

424+00-425+25 RT  
CONSTRUCT SPECIAL  
DITCH, ITEM 103

425+25-426+54 LT  
NEW 15' X 15' CATCH BASIN  
OR COMP. 16' DIA.

425+91-426+16 LT  
5' CGRID, REMOVE

426+22-429+00 LT  
CONSTRUCT SPECIAL  
DITCH, ITEM 103

STATE OF VERMONT  
 RELOCATION OF U.S. ROUTE 4 in the town of  
 FAIR HAVEN  
 TH-21  
 PLAN  
 STA 423+0000 - 429+5000

PLAN SCALE  
 0 50 100  
 FEET

JO F 020-119)AP ROW  
 AMM R 43  
 APRIL 1967  
 31 69