


STEEL ROLL FENCE FRONT (OR REAR) TIRE ELEV.		ONE IN. LINK FENCE E. WISE		PROPERTY LINE FENCE WITH STEEL POSTS ITEM 583 CLAND	
STATION	FEET	STATION	FEET	STATION	FEET

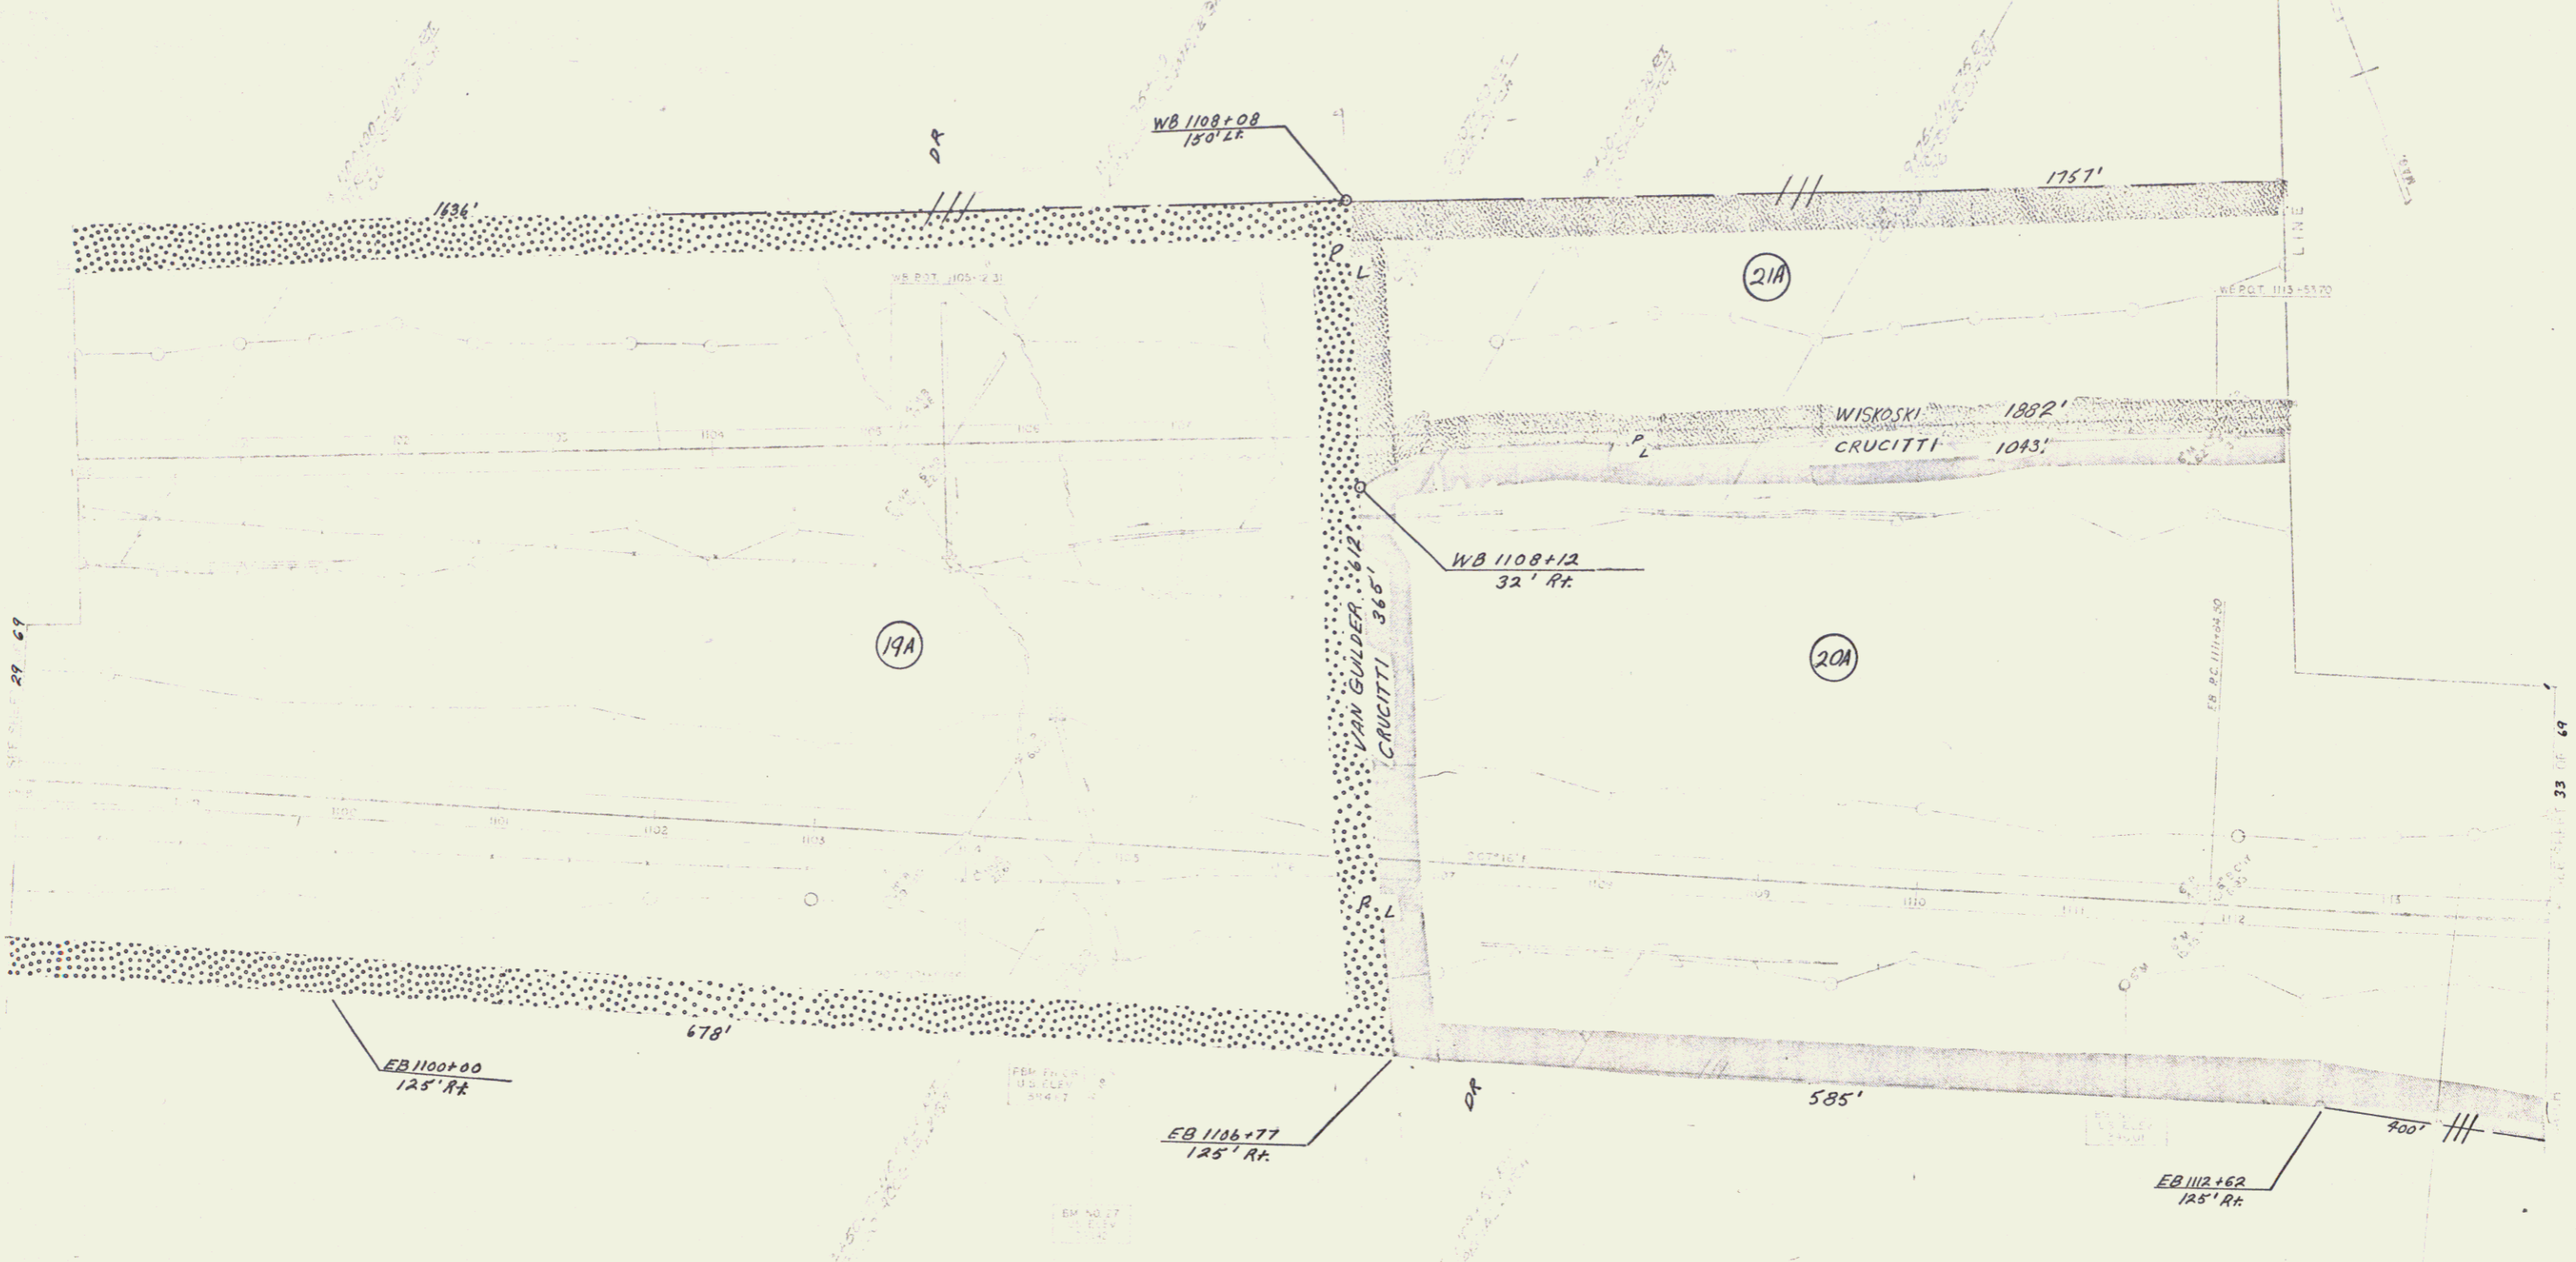

STAGE I CONSTRUCTION
STATE OF ALABAMA
DEPARTMENT OF TRANSPORTATION
DIVISION OF HIGHWAYS
PROJECT NO. 1108-12
PLAN NO. 32A
DATE: 11/19/69

32A 69