


GEORGE ROW PROJECT
 FC 20-1(4) STATION 373+00

Handwritten: = 1380+84

DISPLACEMENT DISTANCE
 MARK STATIONING
 NO. 255-10-32-17

EM 2 74
 03 ALEX
 413 12

VERMONT DEPARTMENT OF HIGHWAYS
 RIGHT-OF-WAY PLANS
 PROJECT CASTLETON
 No F020-1(4)
 SHEET 7 OF 36

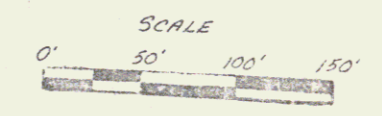

Handwritten: 7