
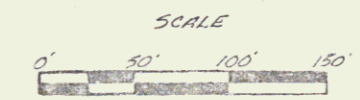


TRAIL OF A BURNING WAGON, ITEM 542  
 ST. JAMES, VT - ST. JAMES, VT  
 NB 34+10.00 - WB 40+10.00 Et.  
 NB 34+10.00 - WB 40+10.00 Et.

DRILLING & BLASTING OF SOLID  
 ROCK SUB-GRADE, ITEM 115  
 WB 45+75 - 47+75  
 WB 48+75 - 49+25  
 EB 49+00 - 49+75

DRILLING & BLASTING OF  
 SOLID ROCK, ITEM 126  
 EB 45+50.00 - 46+10.00

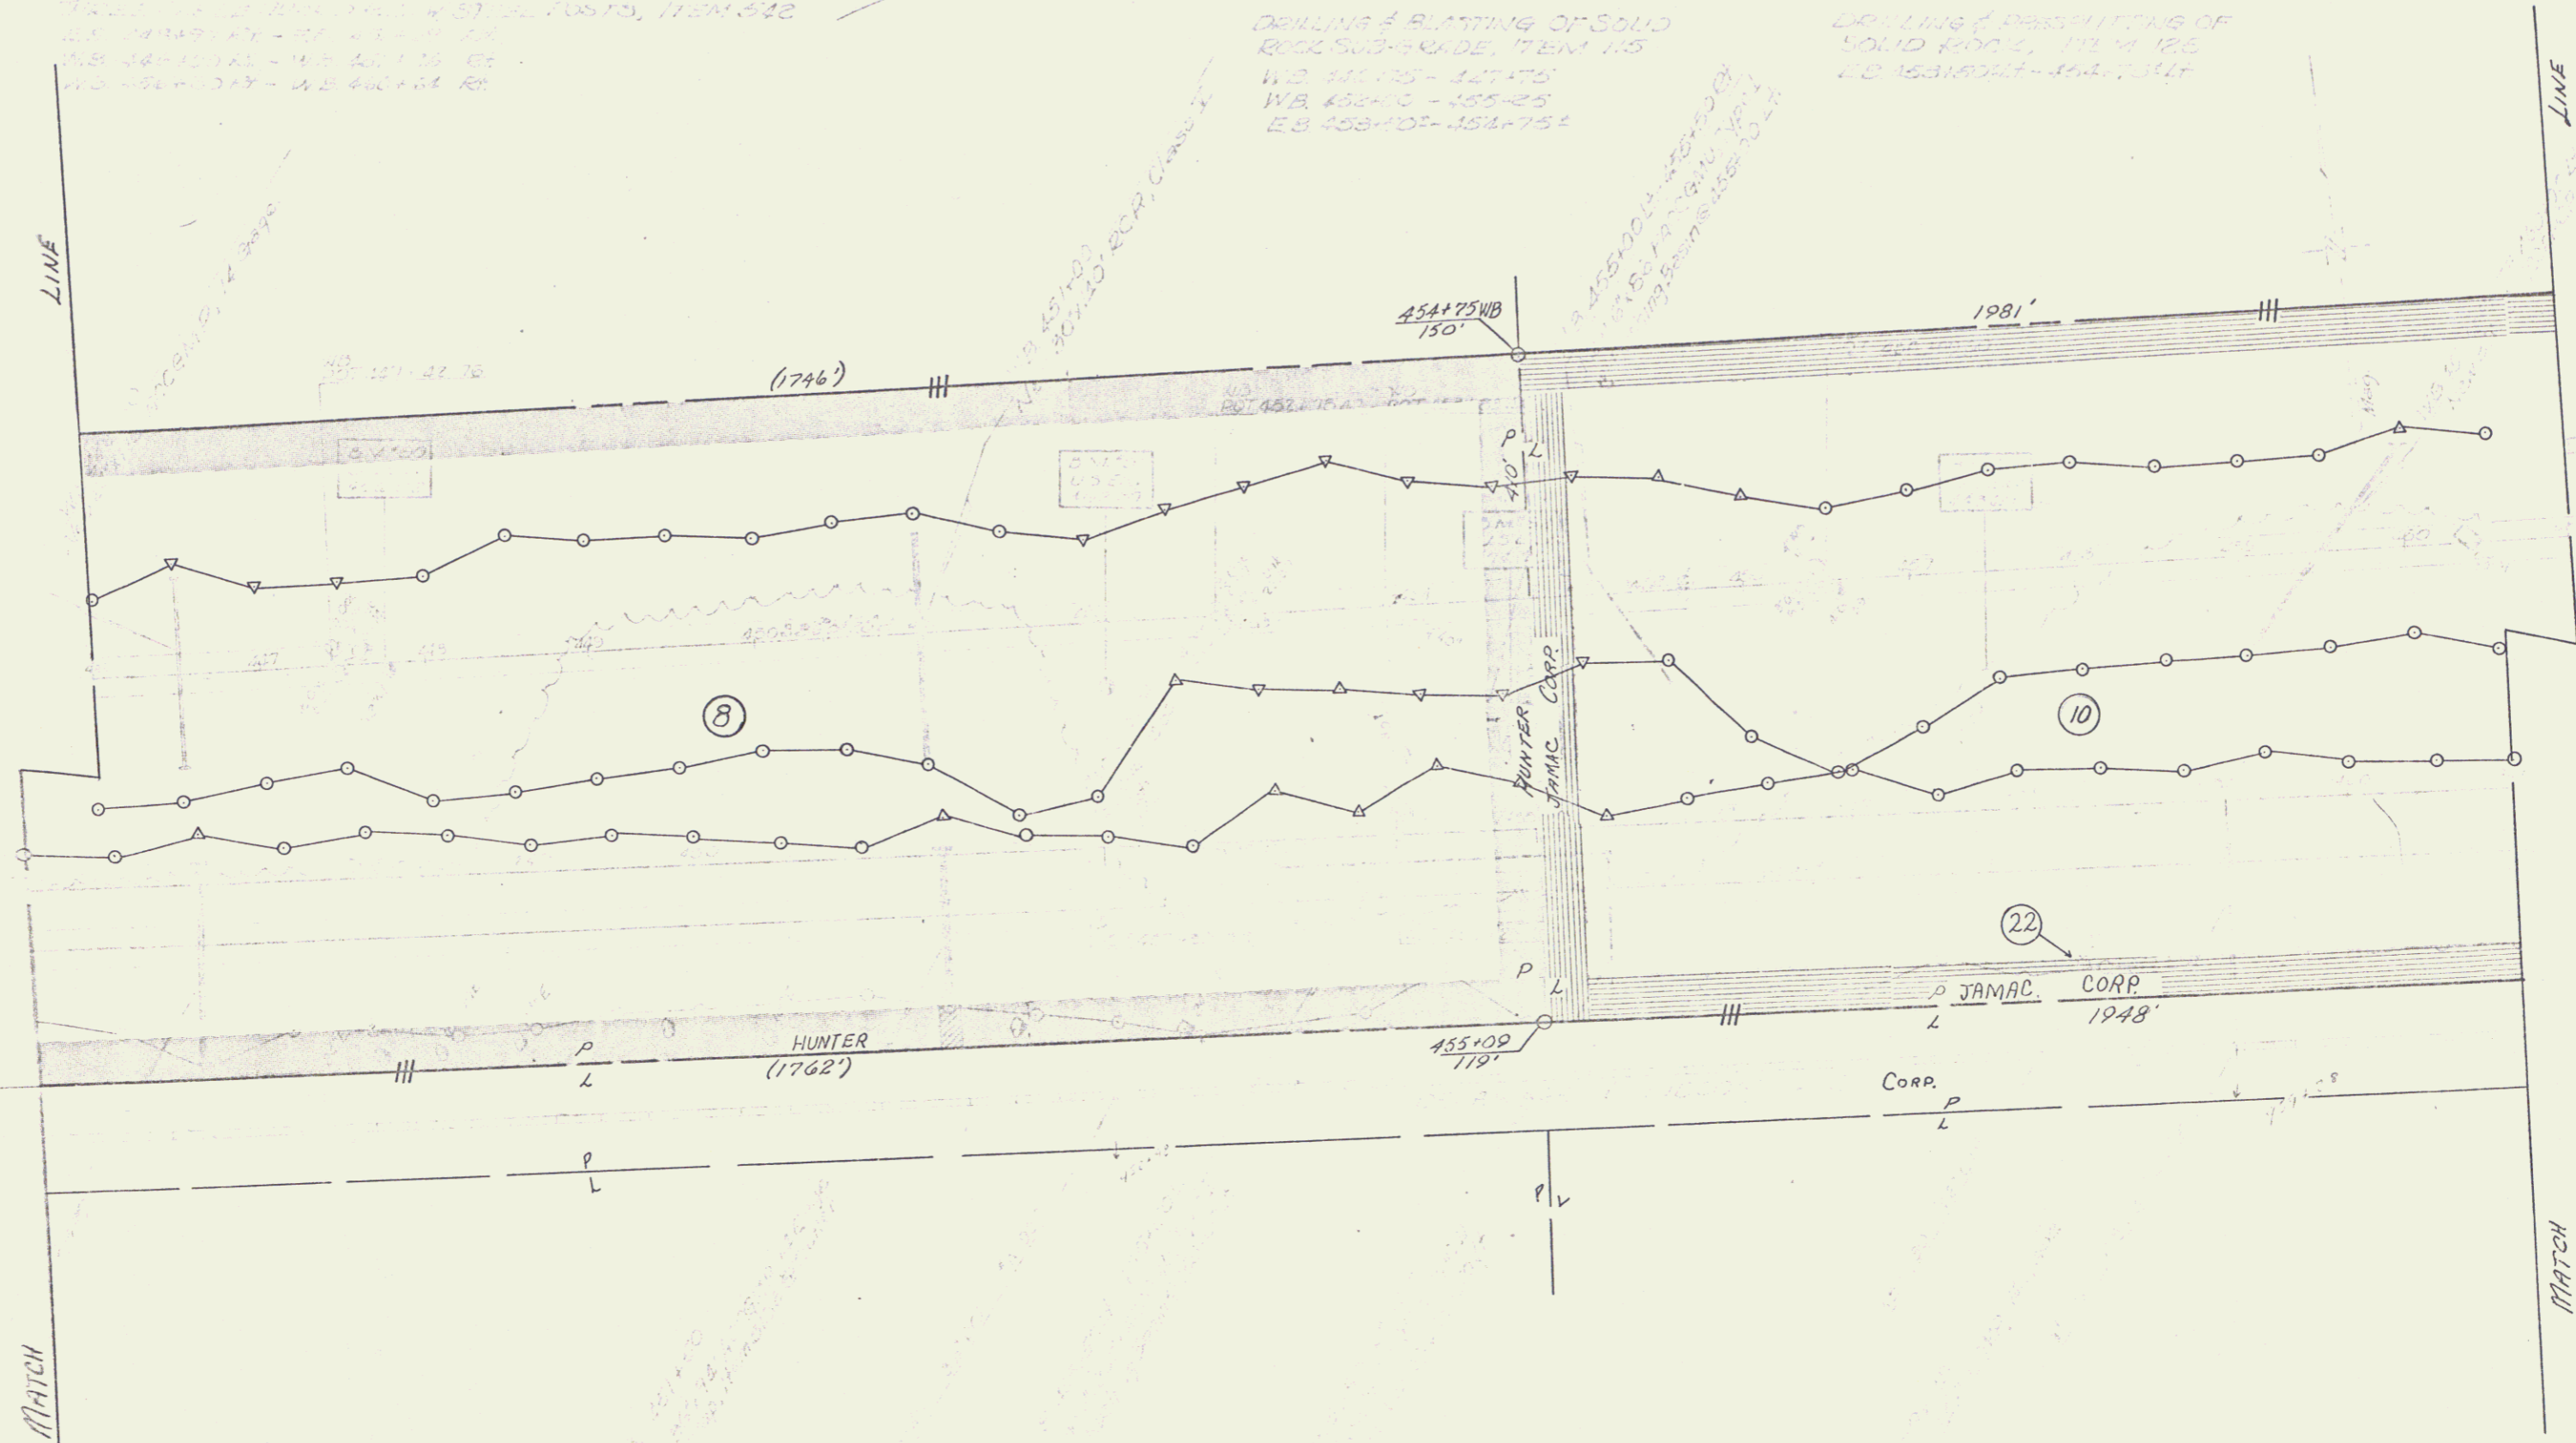

VERMONT DEPARTMENT OF HIGHWAYS  
 RIGHT-OF-WAY PLANS  
 PROJECT CASTLETON  
 NO. F020-1(4)  
 SHEET 14 OF 36