

[illegible]

**PROPOSED IMPROVEMENT**

---


**TOWNS OF CASTLETON-IRA**  
**COUNTY OF RUTLAND**  
**U.S. ROUTE 4**  
**FAIR HAVEN-RUTLAND ROAD**

BEGINNING AT A POINT 3.107 MILES WESTERLY OF THE CASTLETON-IRA TOWN LINE AND EXTENDING EASTERLY 3.183 MILES.

LENGTH OF ROADWAY 16,303.38 FEET = 3.183 MILES

LENGTH OF PROJECT 16,810.38 FEET = 3.183 MILES

|      |     |        |
|------|-----|--------|
| 1965 | ADT | 4300   |
| 1987 | ADT | 7680   |
| 1987 | DHV | 1030   |
| 1987 | D   | 60     |
| 1987 | T   | 7 %    |
|      | V   | 60 MPH |

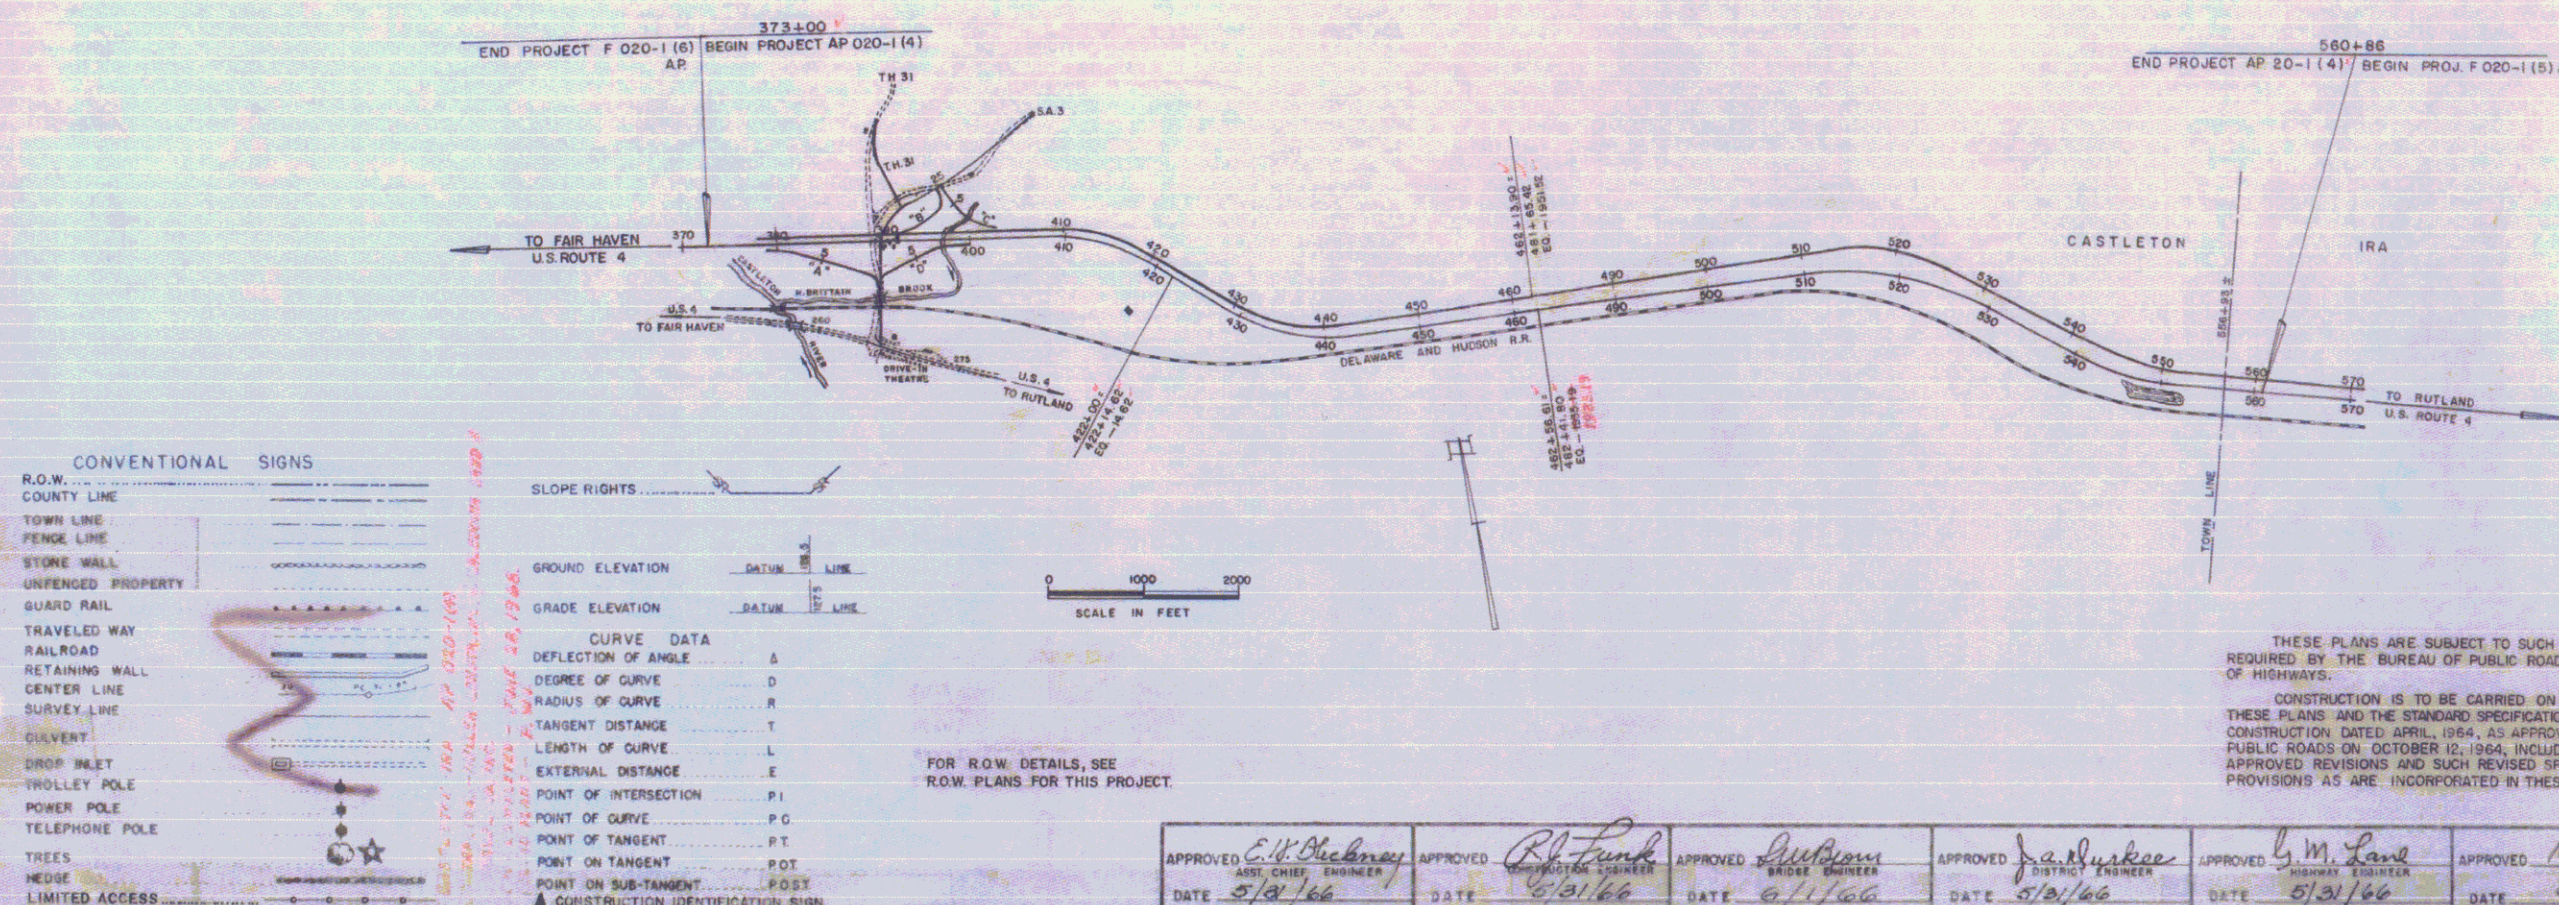

THESE PLANS ARE SUBJECT TO SUCH REVISIONS AS MAY BE REQUIRED BY THE BUREAU OF PUBLIC ROADS OR THE COMMISSIONER OF HIGHWAYS.

CONSTRUCTION IS TO BE CARRIED ON IN ACCORDANCE WITH THESE PLANS AND THE STANDARD SPECIFICATIONS FOR HIGHWAY AND BRIDGE CONSTRUCTION DATED APRIL, 1964, AS APPROVED BY THE BUREAU OF PUBLIC ROADS ON OCTOBER 12, 1964, INCLUDING ALL SUBSEQUENT APPROVED REVISIONS AND SUCH REVISED SPECIFICATIONS AND SPECIAL PROVISIONS AS ARE INCORPORATED IN THESE PLANS.

### STAGE I CONSTRUCTION

DEPARTMENT OF TRANSPORTATION

APPROVED

DIVISION ENGINEER DATE

AP NO 020-1 (4) (11)