


DRILLING & BLASTING OF SOLID ROCK
SUBGRADE, ITEM 115
ED 420+75' - 429+25'
426+25 430+13
WB 425+75 - 431+00

DRILLING & PRE-SPLITTING OF SOLID
ROCK, ITEM 125
ED 420+75' Lt. - 429+25' Lt.
PROPERTY LINE FENCE, ITEM 333-II
416+00 - 431+00 WBL 112 Rt.

* THREE CABLE GUARD RAIL w/
LIGHT STEEL POSTS, ITEM 338
ED 429+75' - 431+00 Lt.
WB 421+50' - 425+30 Lt. +31+00
WB 421+80' - 423+56 Lt.
WB 422+30' - 424+7+ Lt.

* STANDARD STEEL-BEAM GUARD-RAIL
w/STEEL-POSTS, ITEM 545-A
WB 417+46 Lt. - 419+00 Lt.
WB 427+46 Lt. - 429+00 Lt.

* Stage 2 Construction

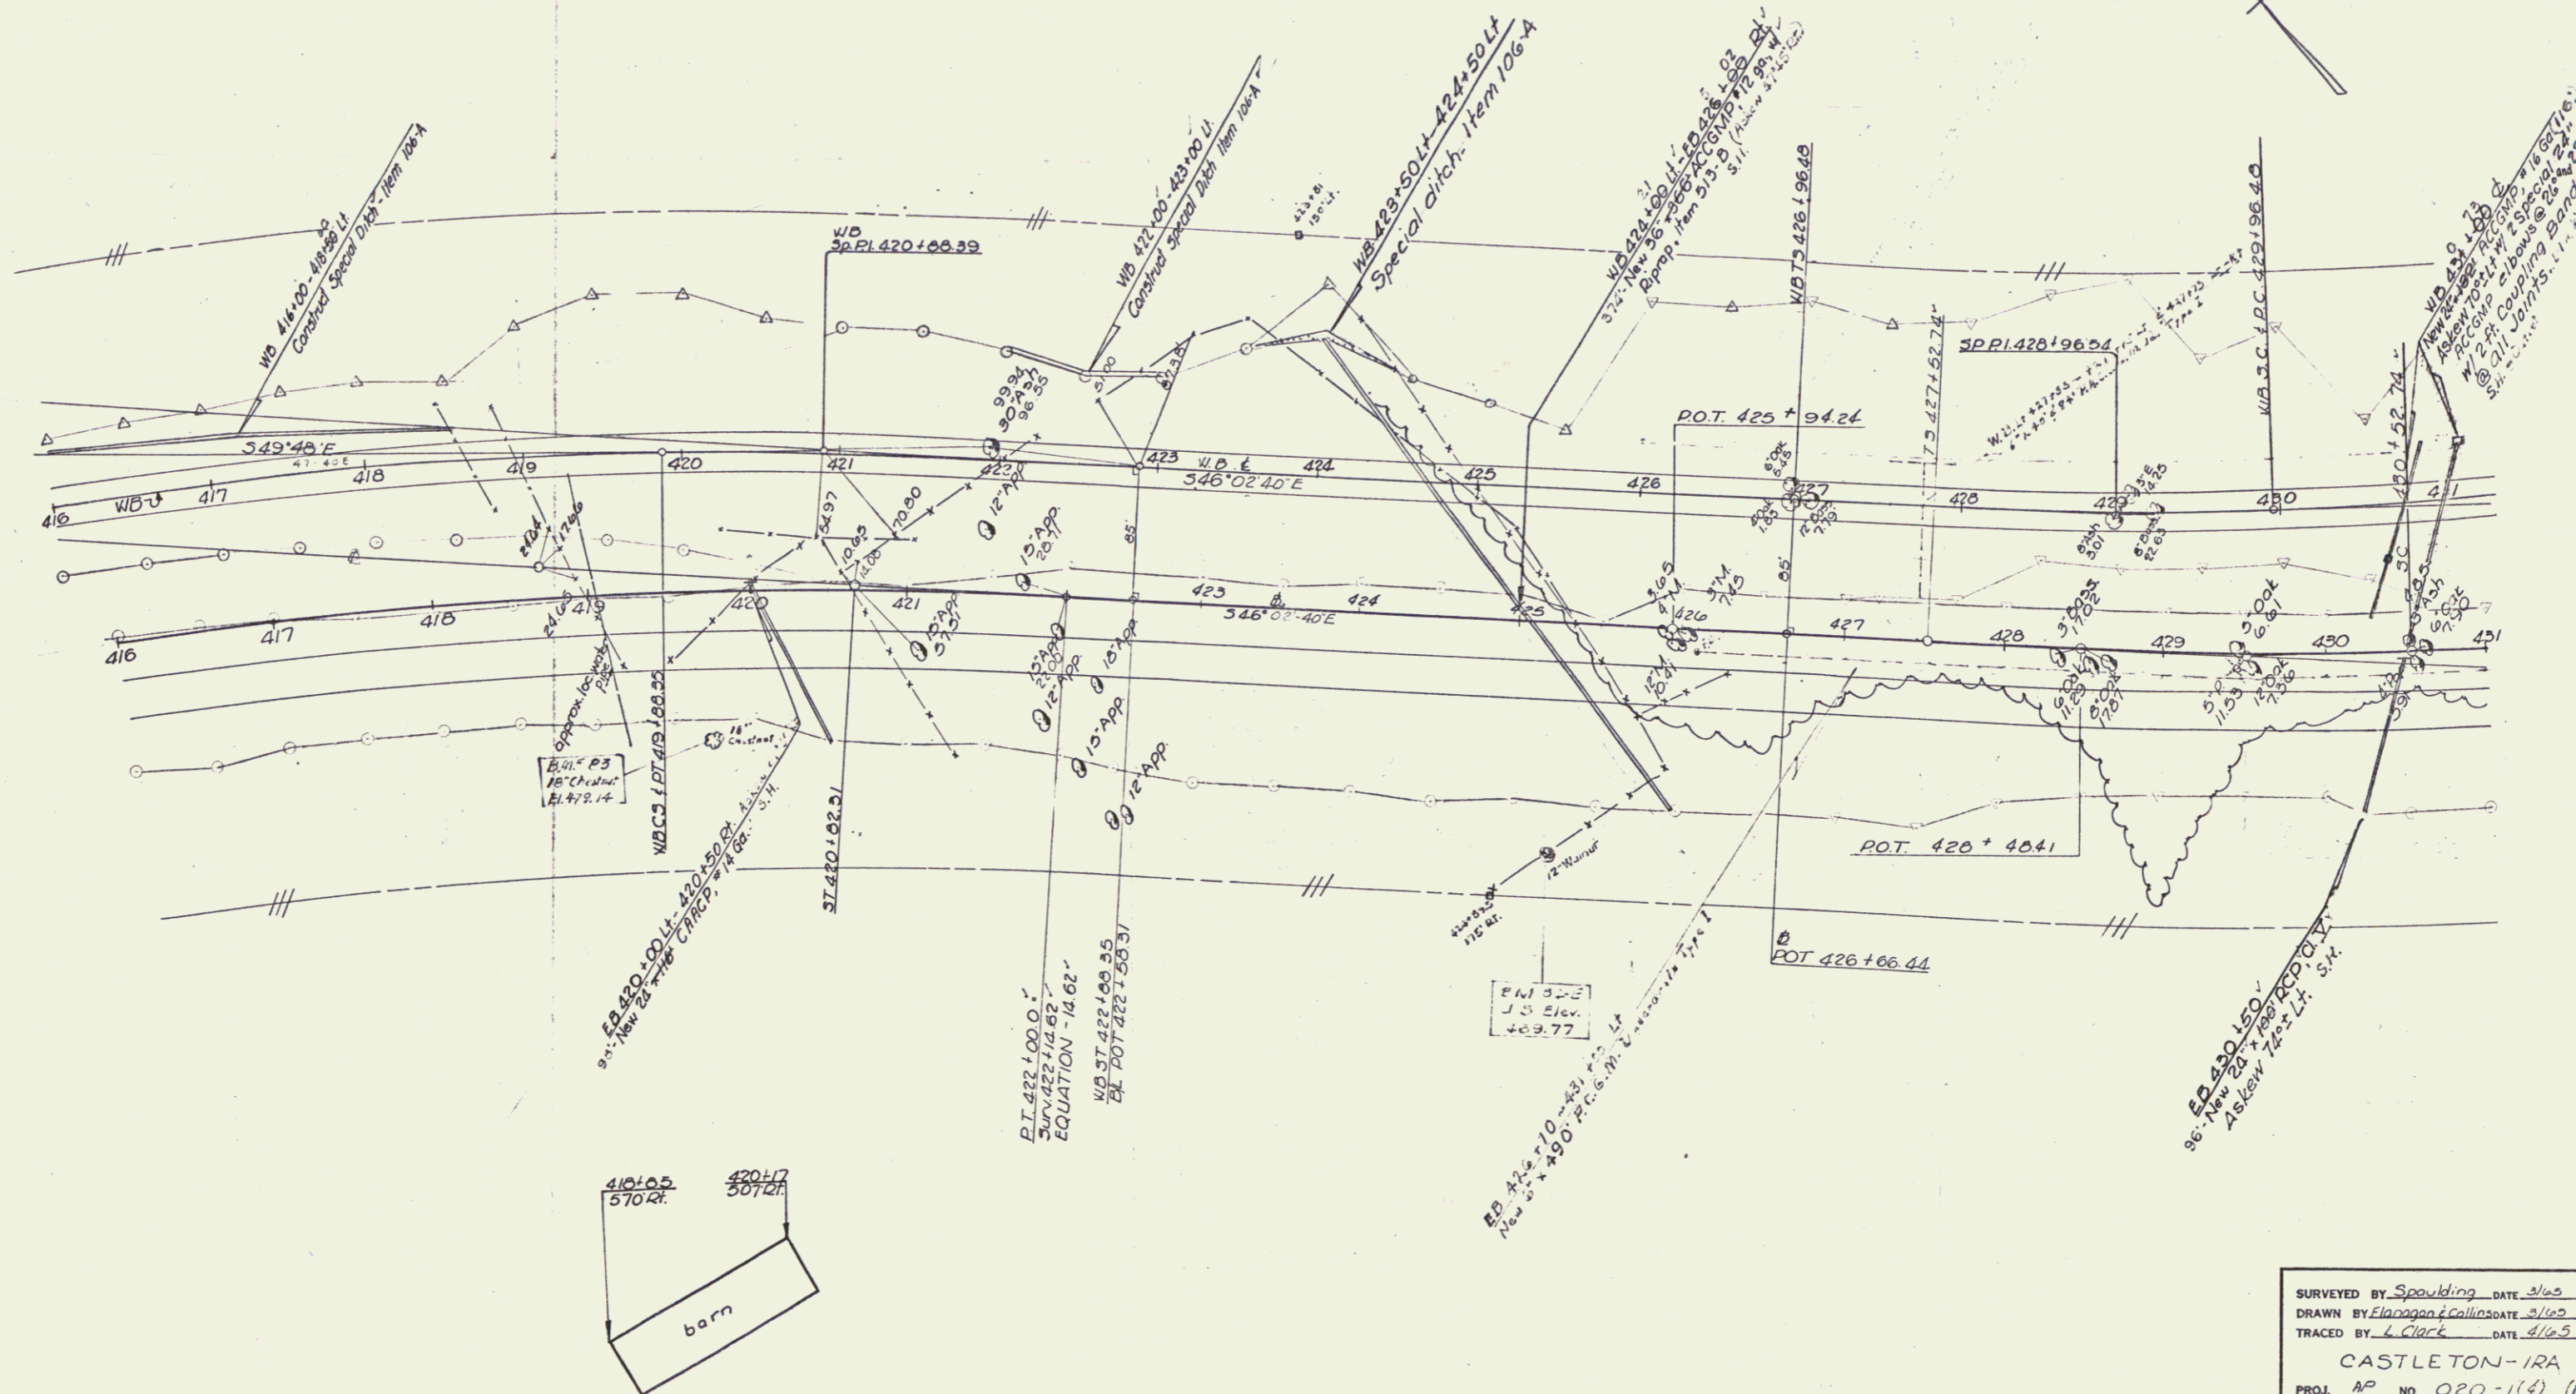

CONTROL OF ACCESS COMPLETE ON THIS SHEET

Stage 2 Construction

SURVEYED BY Spaulding DATE 3/15
DRAWN BY Flanagan & Collins DATE 3/15
TRACED BY L. Clark DATE 4/15
CASTLETON - IRA
PROJ. NO. 020-114 (11)
SHEET 36 OF 301
Sheet 57 of 170 Sheets

27