

DRILLING & BLASTING OF SOLID  
ROCK SUBGRADE, ITEM 115  
WB. 489+75-490+25

DEMOLITION & REMOVAL OF BUILDING  
ITEM 556  
WB 461+05 Lt.


DRILLING & PRESPLITTING OF  
SOLID ROCK, ITEM 125  
WB. 489+75 Rt. - 490+25 Rt.

PROPERTY LINE FENCE, ITEM 563-II  
WB 461+00' - 494+00' Lt.  
461+00' - 494+00' Rt.

\* Standard Steel Beam Guard Rail w/Lt.  
w/ Steel Posts, Item 545-A

EB 461+00 Rt. - 461+54 Lt.  
EB 461+00 Lt. - 462+04 Rt.  
WB 460+20 Rt. - 462+04 Rt.  
WB 461+48 Lt. - 462+15 Lt.

\* Stage 2 Construction

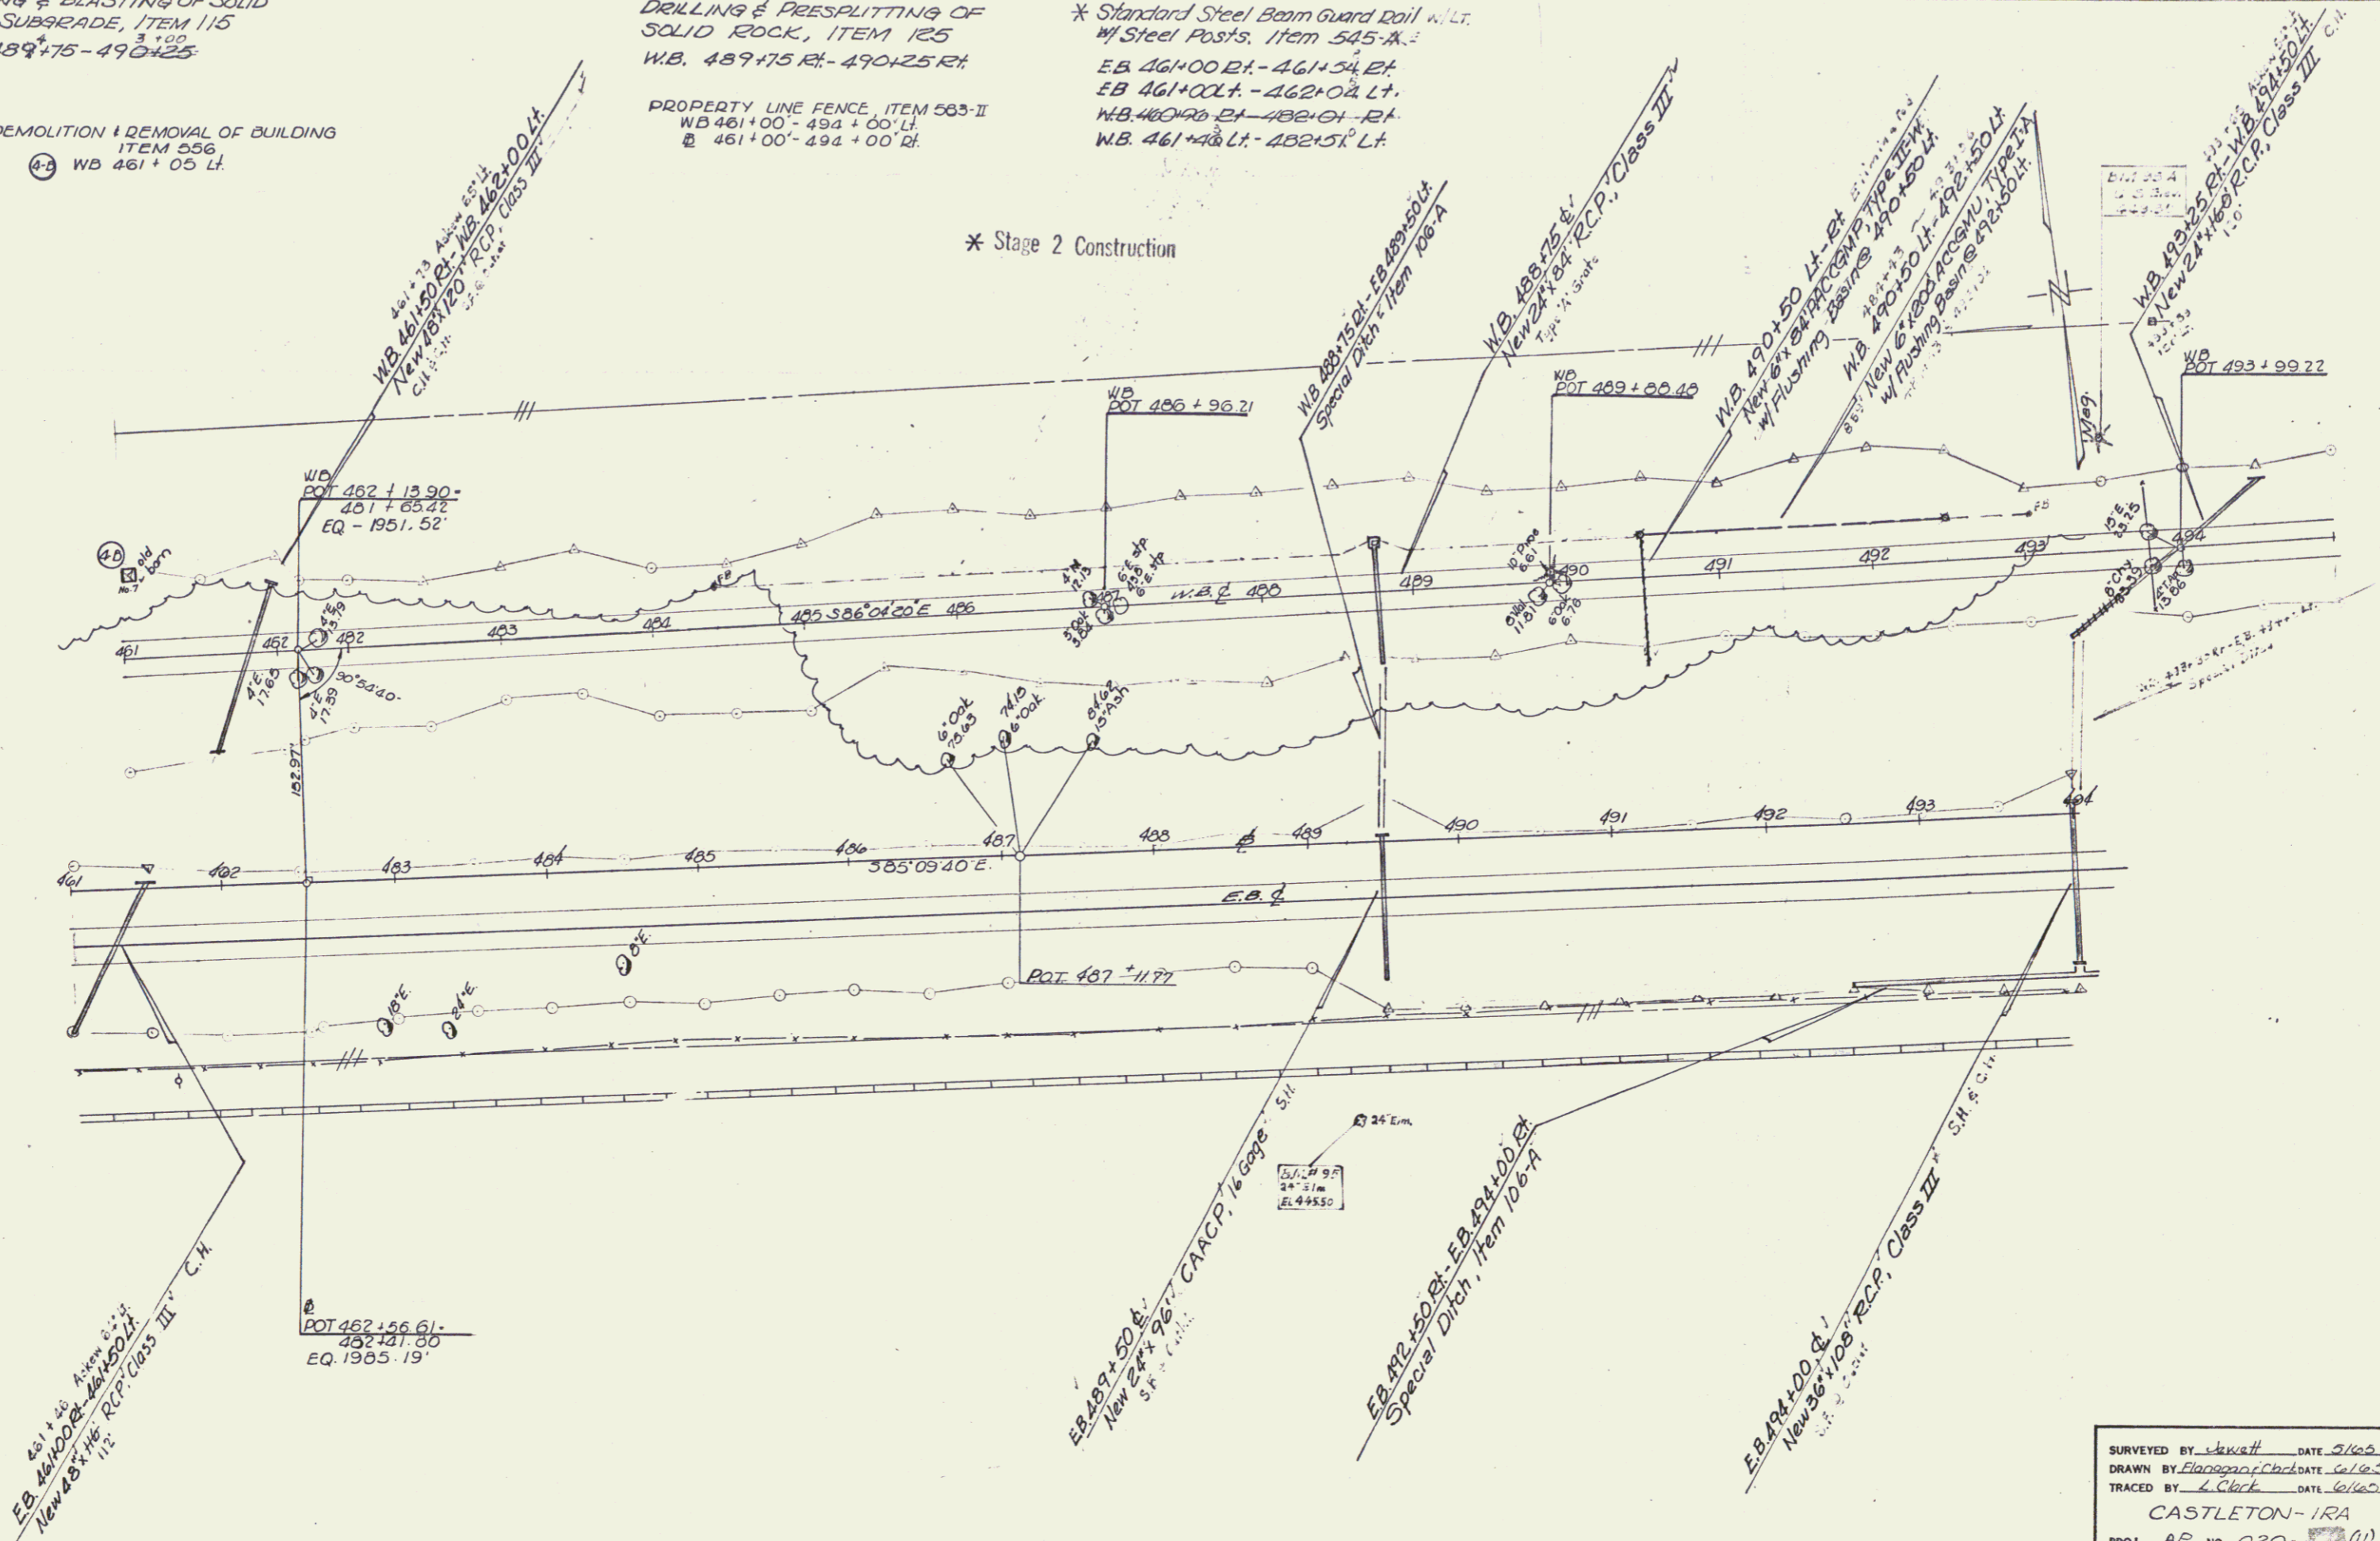

EB 461+20  
New 24\"/>

POT 462+56.61  
462+41.00  
EQ 1965.19'

EB 489+50 Lt.  
New 24\"/>

EB 492+50 Rt. - EB 494+00 Lt.  
Special Ditch, Item 106-A

EB 494+00 Lt.  
New 24\"/>

SURVEYED BY Jawatt DATE 5/10/62  
DRAWN BY Flanagan/Clark DATE 6/16/62  
TRACED BY J. Clark DATE 6/16/62  
CASTLETON - 11A  
PROJ. AP NO. 020 - (11)  
SHEET 42 OF 301

CONTROL OF ACCESS COMPLETE ON THIS SHEET

Stage 2 Construction Sheet 63 of 170 sheets