


* Standard Steel Beam Guard Rail w. Lt.
 * Steel Posts, Item 545-A-E

WB 518+00 - 520+42 Lt.
 EB 520+00 Rt - 522+00 Rt
 EB 521+00 Lt - 523+00 Lt
 EB 515+24 Rt - 516+70 Rt
 EB 515+70 Lt - 517+24 Lt
 WB 508+48 Lt - 510+90 Lt
 WB 510+36 Lt - 512+80 Lt
 WB 510+00 Lt - 517+00 Lt
 WE 518+90 - 520+42 Rt.
 WB 519+00 - 520+52 Lt.

* Stage 2 Construction

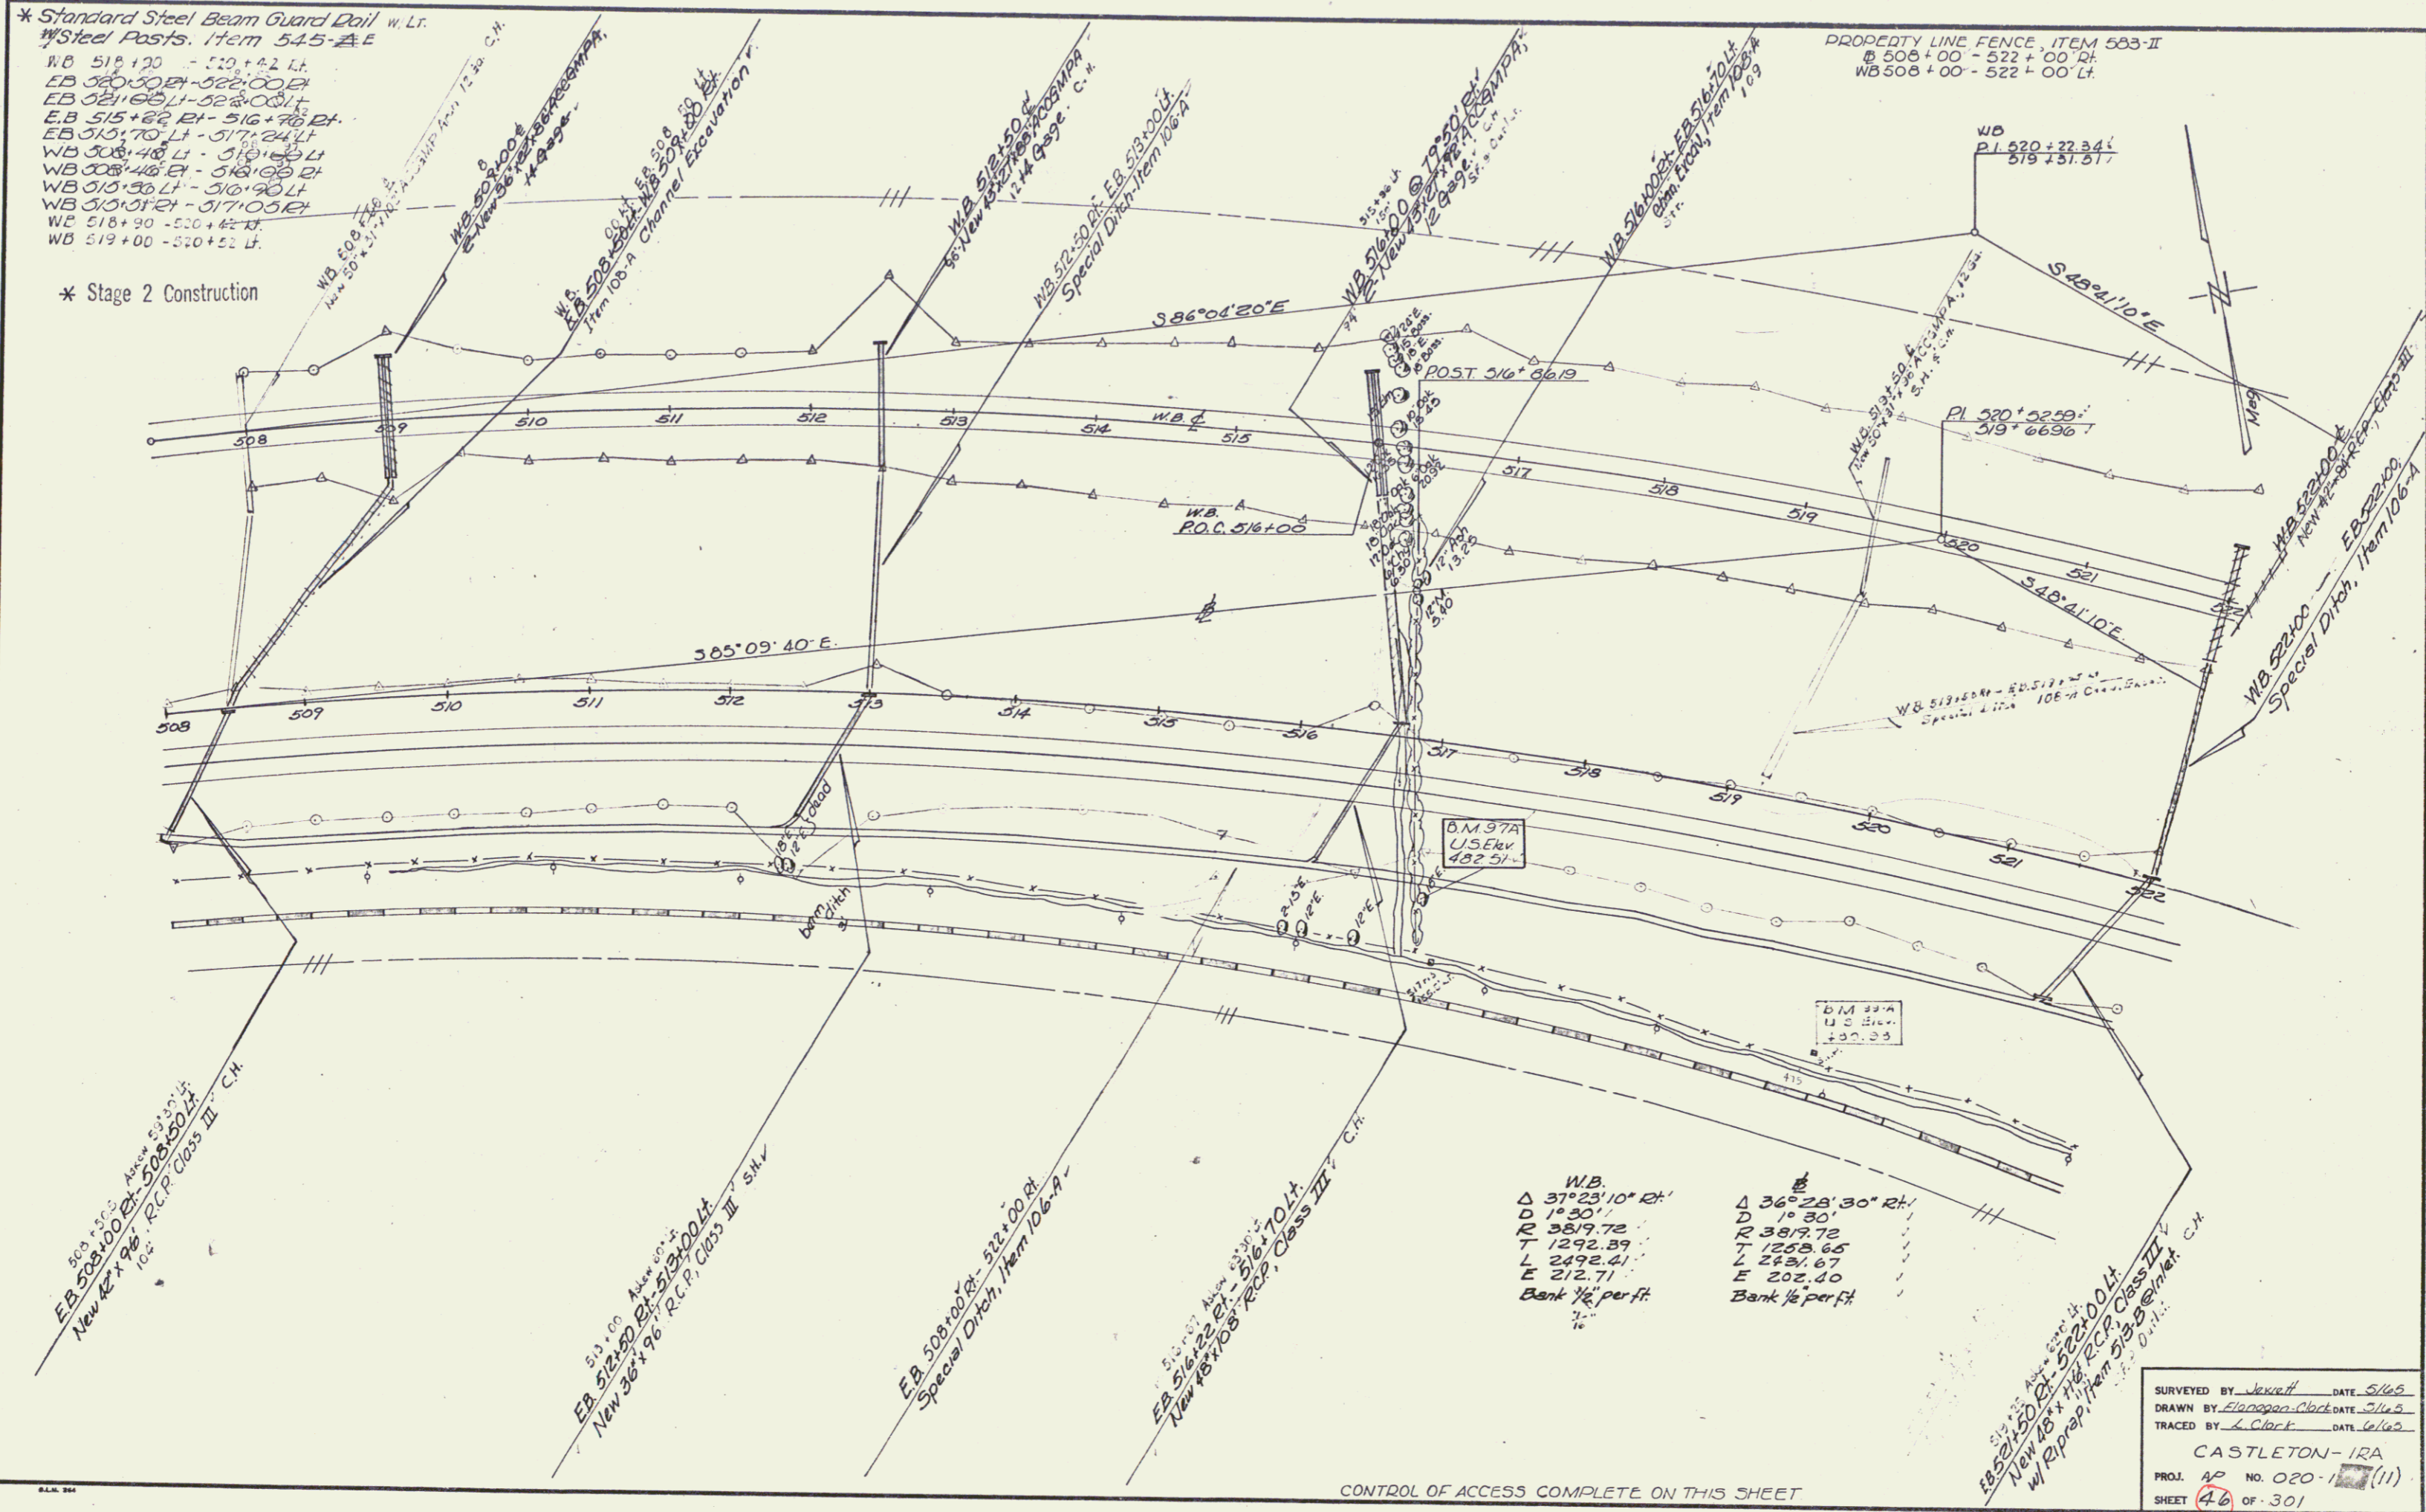

W.B.	E
Δ 37°28'10" Rt.	Δ 36°28'30" Rt.
D 1°30'	D 1°30'
R 3819.72	R 3819.72
T 1292.89	T 1258.65
L 2492.41	L 2421.67
E 212.71	E 202.40
Bank 1/2 per ft.	Bank 1/2 per ft.

PROPERTY LINE FENCE, ITEM 583-II
 @ 508+00 - 522+00 Rt.
 WB 508+00 - 522+00 Lt.

CONTROL OF ACCESS COMPLETE ON THIS SHEET

SURVEYED BY J. Clark DATE 5/1/65
 DRAWN BY E. J. Clark DATE 5/1/65
 TRACED BY J. Clark DATE 6/1/65
 CASTLETON - IRA
 PROJ. NO. 020-1(11)
 SHEET 46 OF 301

Stage 2 Construction Sheet 67 of 170 Sheets