


\* Standard Steel Beam Guard Rail  
 w/ Steel Posts, Item 545-A  
 EB 522+00 Lt. - 522+04 Lt.  
 EB 522+00 Rt. - 522+04 Rt.

PROPERTY LINE FENCE, ITEM 503-II  
 WB 522+00 - 536+00 Lt.  
 @ 522+00' - 536+00' Rt.

\* THREE CABLE GUARD RAIL w/ LIGHT  
 STEEL POSTS ITEM 538  
 WB 529+96 Lt. - WB 532+04 Lt.  
 WB 529+96 Rt. - WB 532+04 Rt.

\* Stage 2 Construction

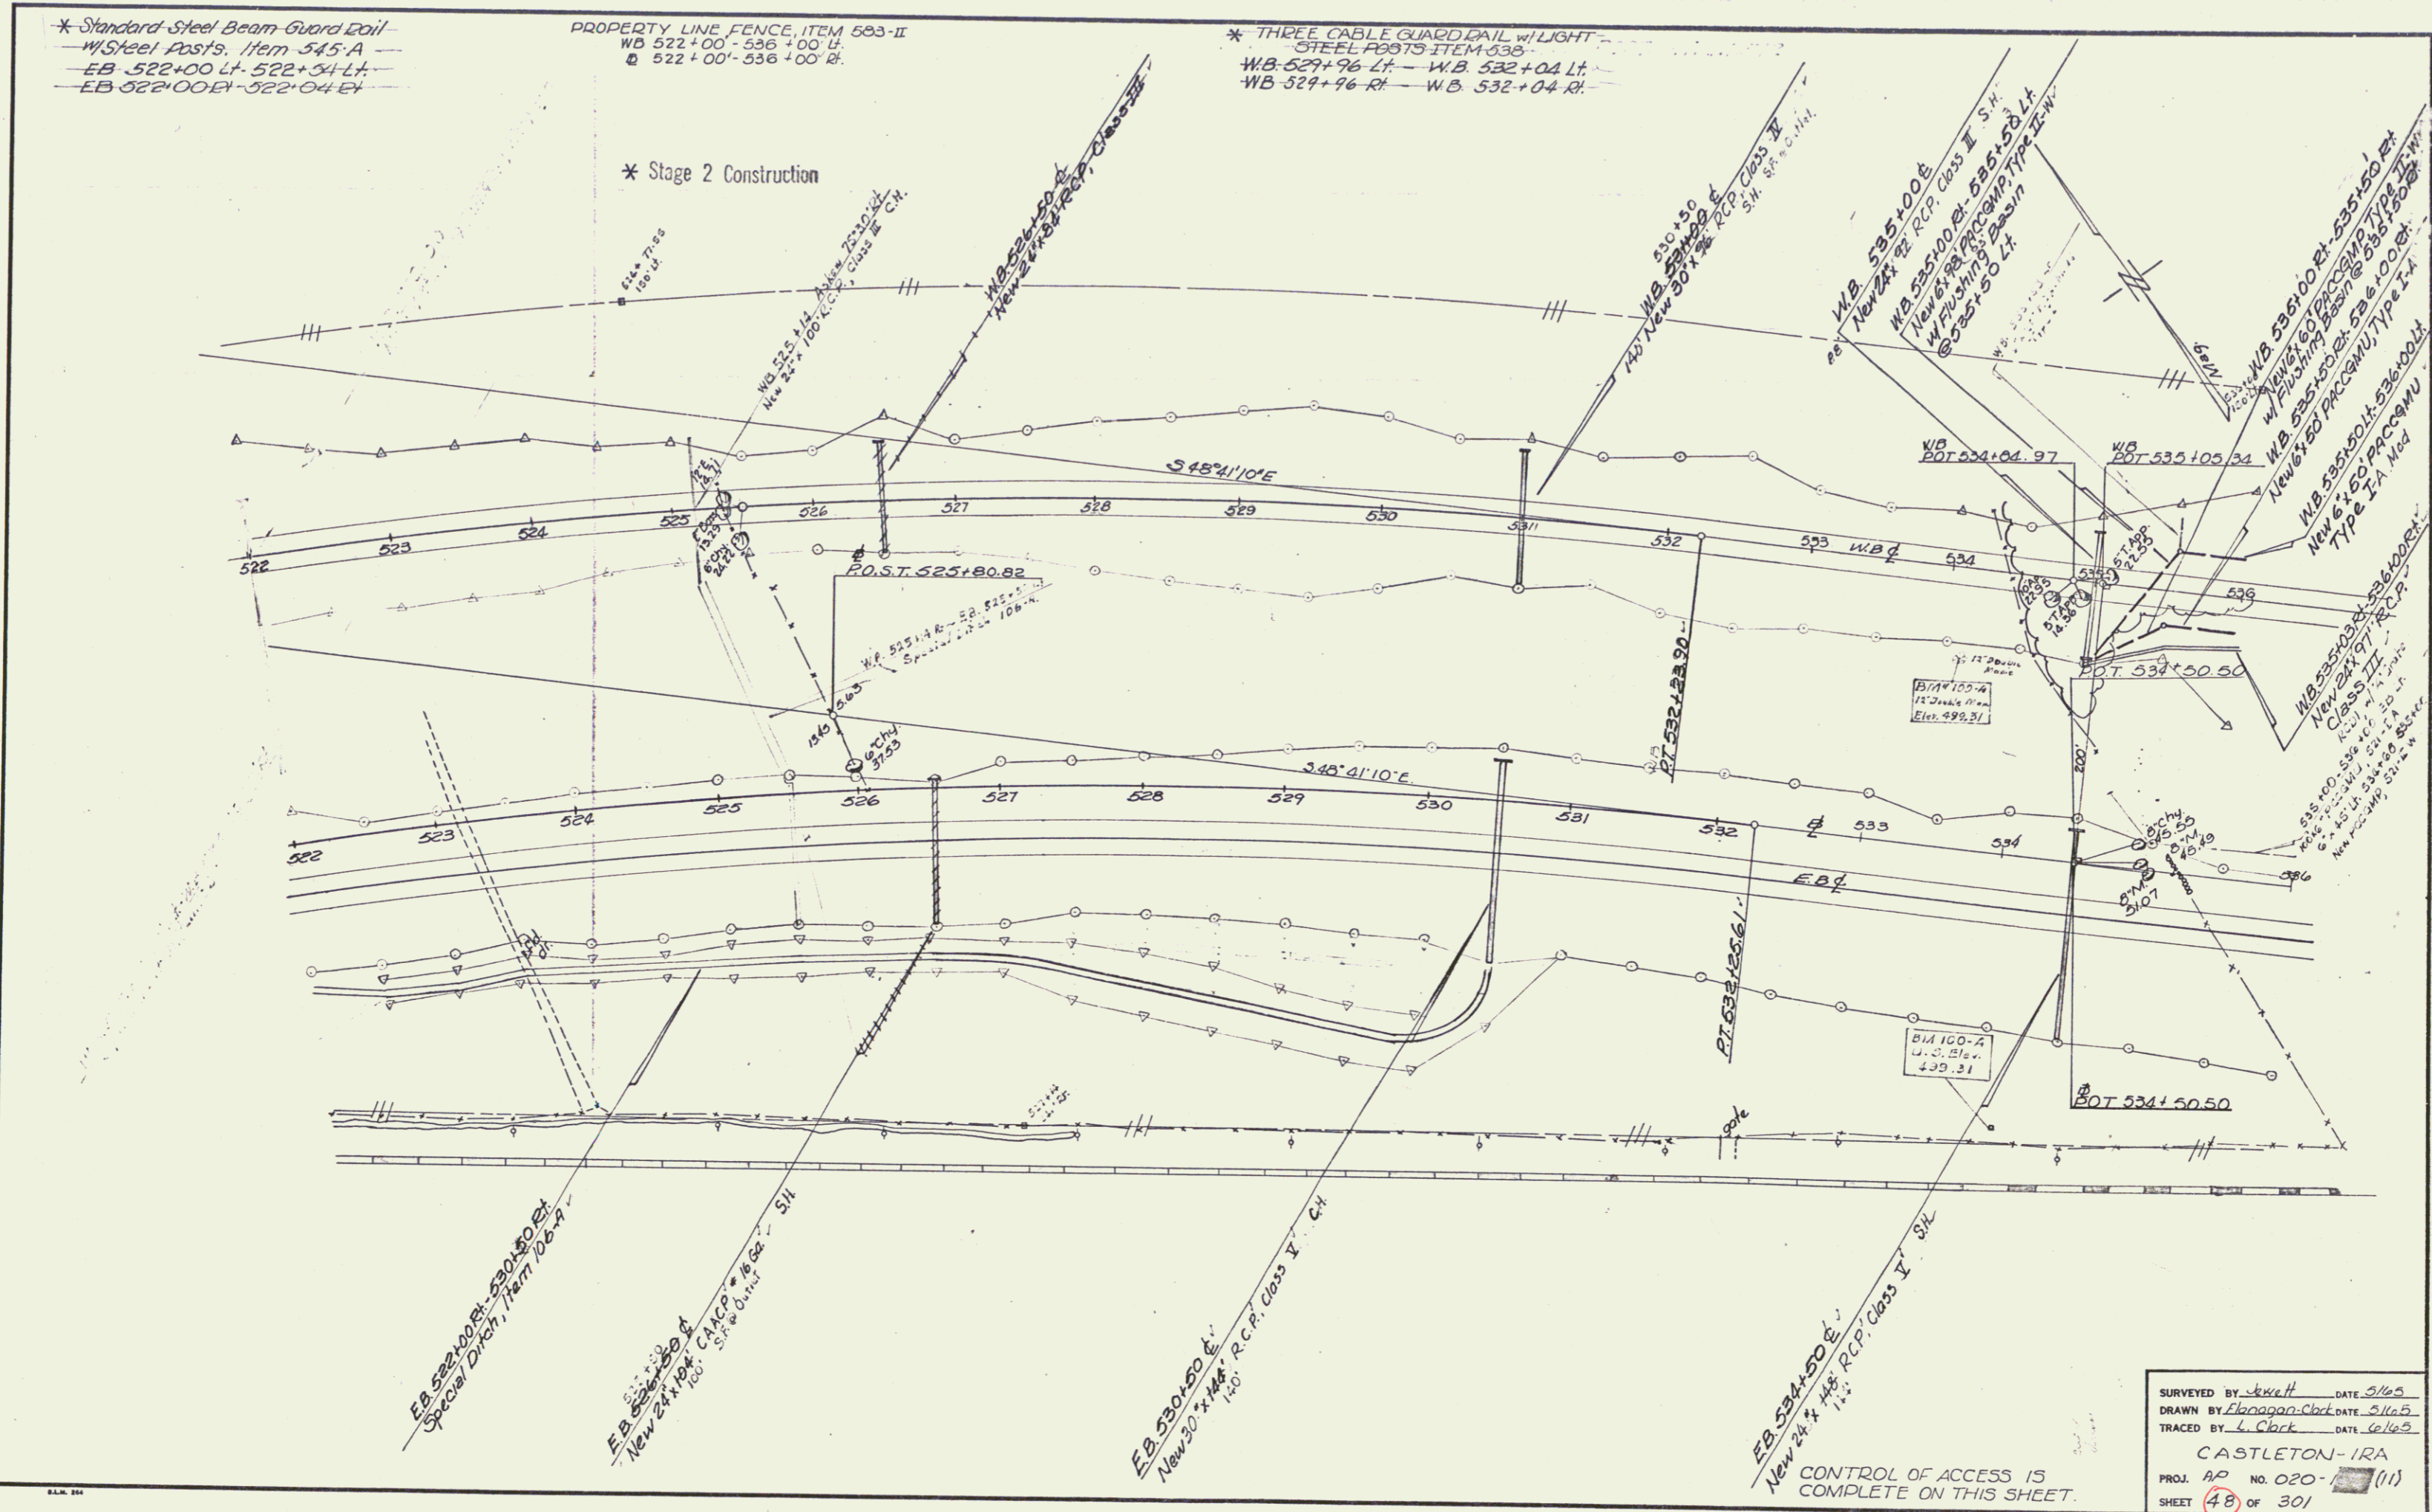

SURVEYED BY *Stewart* DATE *5/16/5*  
 DRAWN BY *Elanagan-Cldt* DATE *5/16/5*  
 TRACED BY *L. Clark* DATE *5/16/5*  
 CASTLETON - IRA  
 PROJ. 80 NO. 020 - (11)  
 SHEET (48) OF 301