


* THREE CABLE GUARD RAIL W/LIGHT
STEEL POSTS ITEM 336
EB. 557+00 RT. - EB. 560+86 RT.
WB. 555+00 RT. - WB. 557+56 RT.
WB. 559+74 RT. - WB. 560+86 RT.

DRILLING & BLASTING OF SOLID
ROCK SURFACE, ITEM 115
WB. 555+00 - 560+86 RT.
EB. 557+15 - 559+50 RT.
V.B. 557+00 - 558+00
PROPERTY LINE FENCE, ITEM 585-II
WB 551+00 - 560+86 L.
BL 551+00 - 560+86 RT.

DRILLING & PRESPLITTING OF
SOLID ROCK, ITEM 125
WB. 557+15 RT. - 559+50 RT.
EB. 557+15 RT. - 559+50 RT.
V.B. 556+11 - 556+81

* Stage 2 Construction

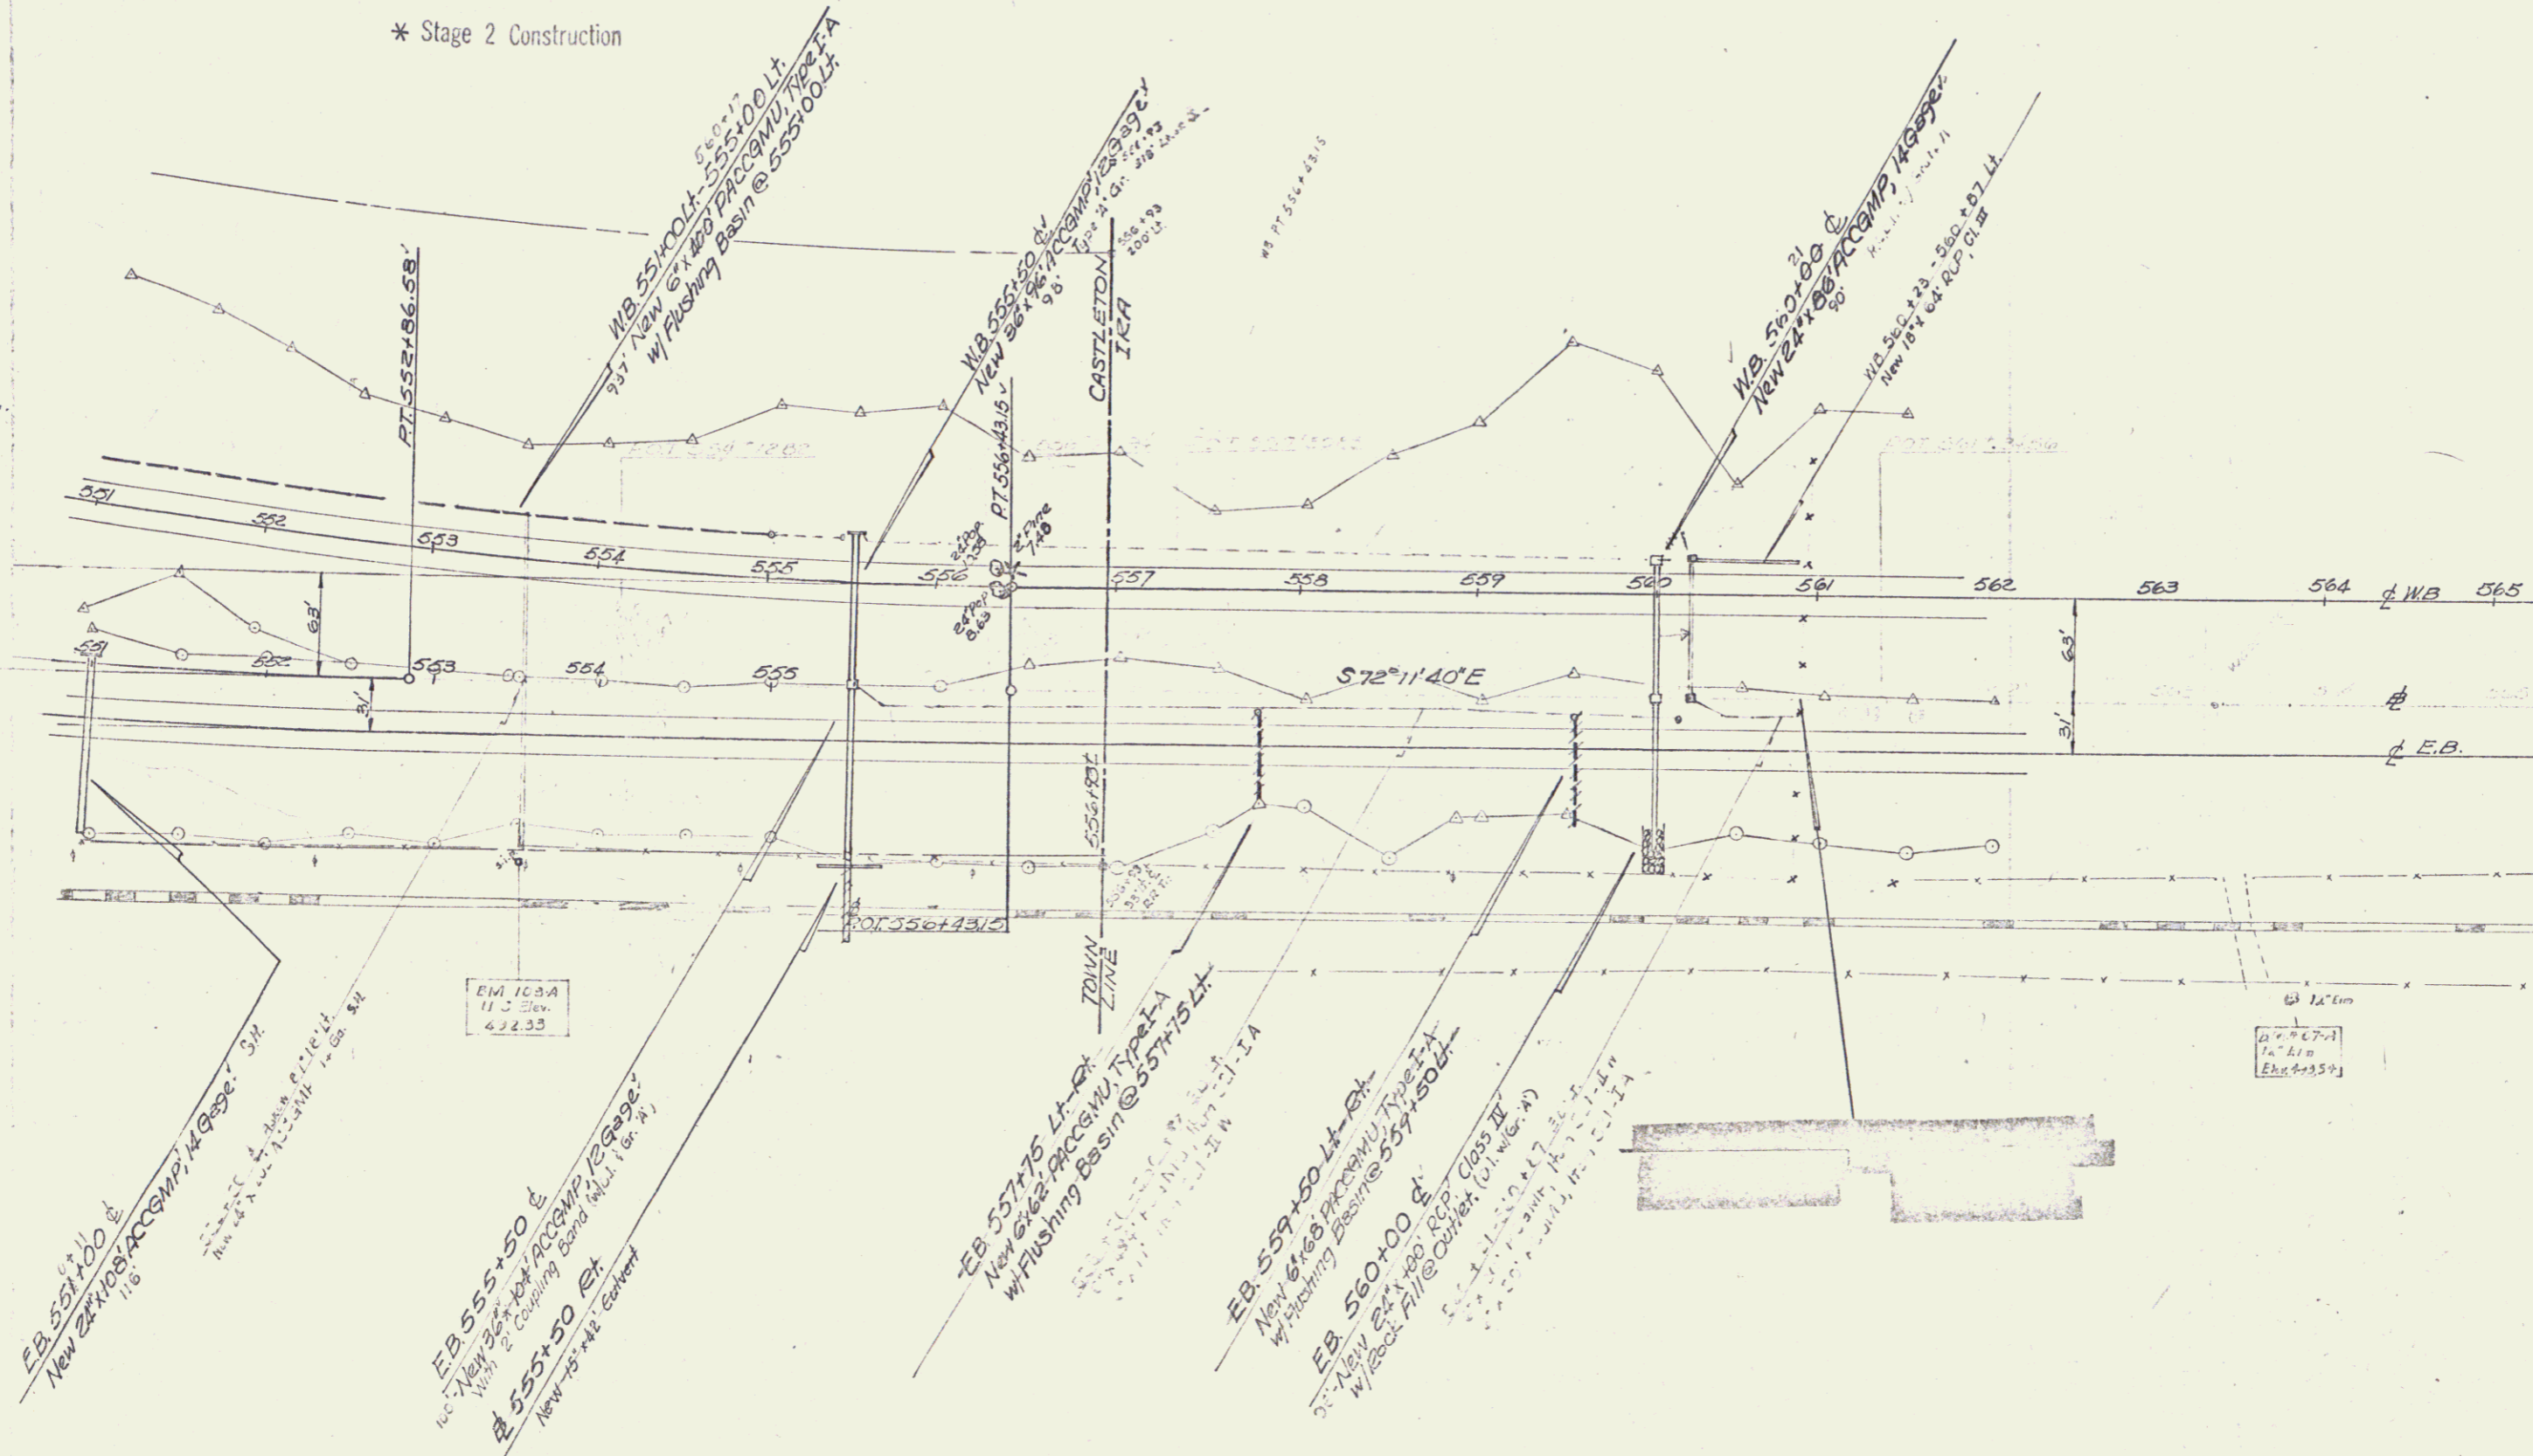

CONTROL OF ACCESS COMPLETE TO END
OF PROJECT F020-1(4), @ STA 560+00.

Stage 2 Construction

CASTLETON
AP
52 30/

Sheet 73 of 70 Sheets