


PLAN	DESIGNED	BY	DATE
	CHECKED	BY	DATE
	REVISIONS	NO.	DESCRIPTION

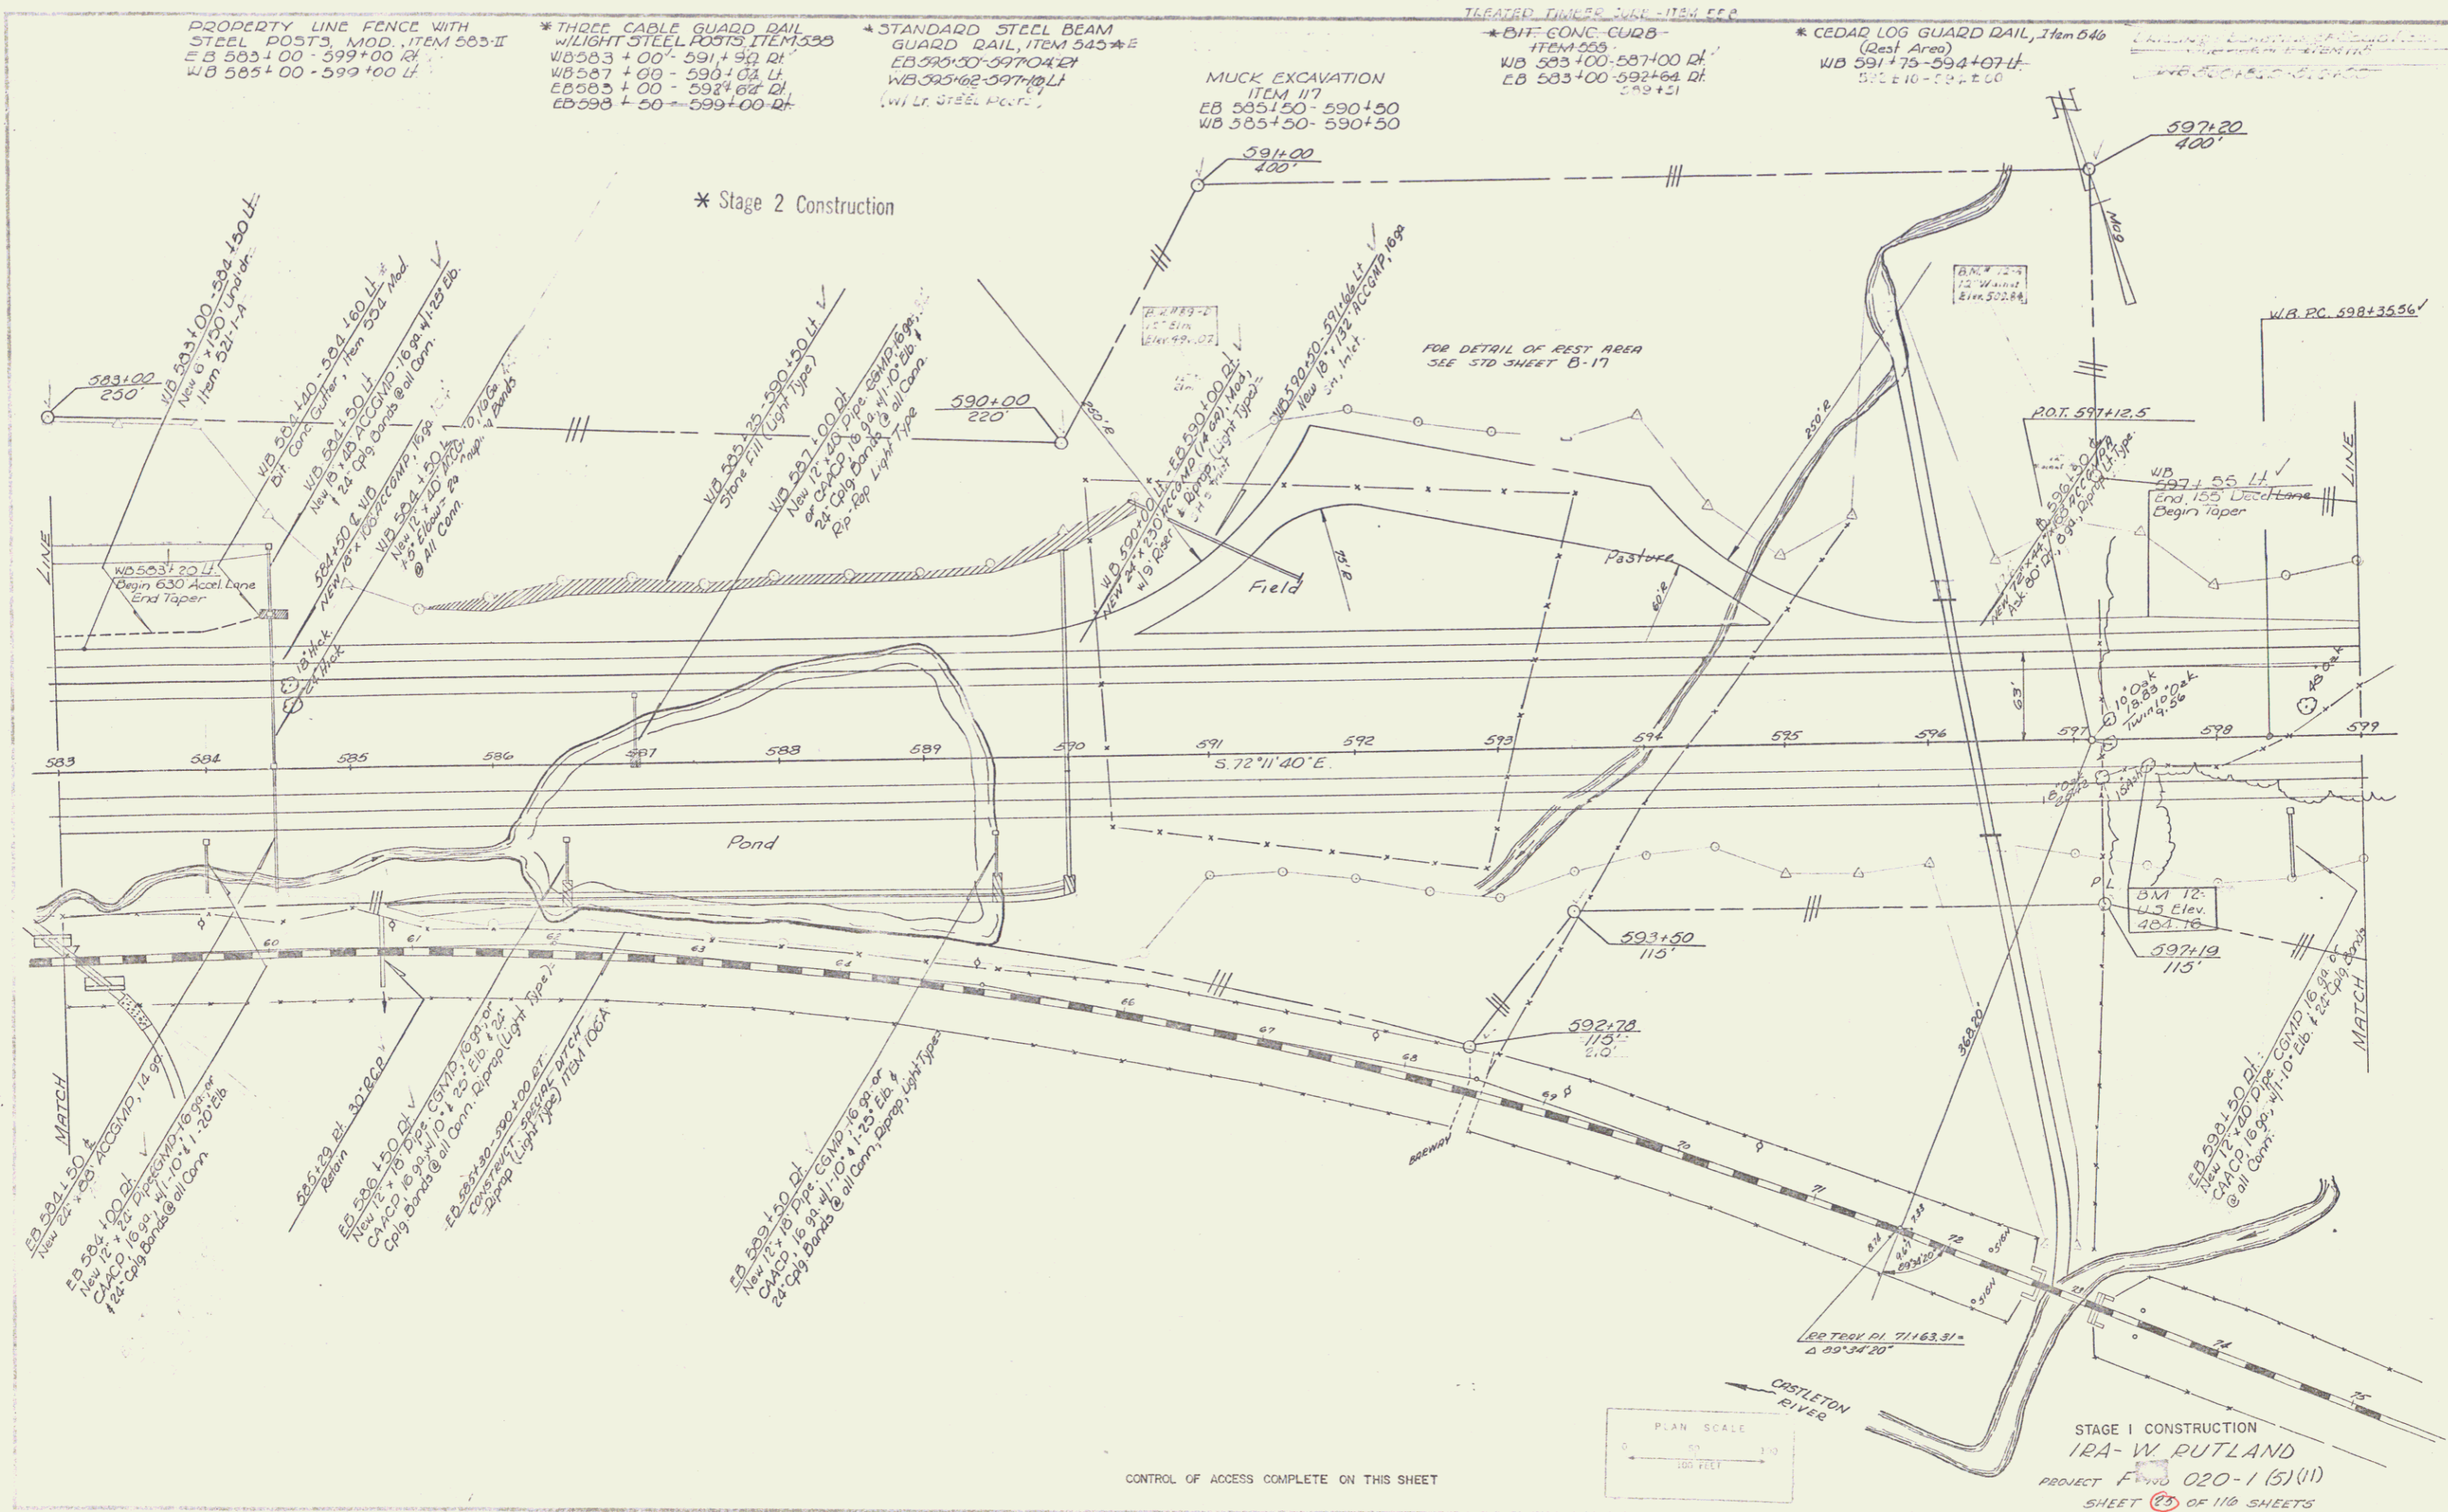

PROPERTY LINE FENCE WITH STEEL POSTS, MOD. ITEM 583-1  
 EB 583+00 - 599+00 Lt.  
 WB 585+00 - 599+00 Lt.

\*THREE CABLE GUARD RAIL WITH LIGHT STEEL POSTS, ITEM 583  
 WB 583+00 - 591+90 Lt.  
 WB 587+00 - 590+00 Lt.  
 EB 583+00 - 592+64 Lt.  
 EB 588+50 - 599+00 Lt.

\*STANDARD STEEL BEAM GUARD RAIL, ITEM 583\*E  
 EB 585+50 - 597+00 Lt.  
 WB 585+62 - 597+00 Lt.  
 (w/ Lt. Steel Posts)


MUCK EXCAVATION ITEM 117  
 EB 585+50 - 590+50  
 WB 585+50 - 590+50

\*BIT CONG. CURB - ITEM 585  
 WB 583+00 - 587+00 Lt.  
 EB 583+00 - 592+64 Lt.  
 (w/ Lt. Steel Posts)

\*CEDAR LOG GUARD RAIL, Item 546 (East Area)  
 WB 591+75 - 594+07 Lt.  
 WB 591+75 - 594+07 Lt.

\* Stage 2 Construction

CONTROL OF ACCESS COMPLETE ON THIS SHEET

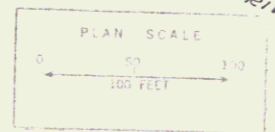

STAGE I CONSTRUCTION  
 IRA-W. RUTLAND  
 PROJECT F-020-1(5)(11)  
 SHEET 25 OF 118 SHEETS

Stage 2 Construction Sheet 80 of 170 Sheets