



BEING PART OF THE SAME LAND AND PREMISES ACQUIRED BY W.D. FROM STEVEN GODLESKI & MARY S. GODLESKI DATED SEPT. 9, 1966 AND RECORDED IN BK. 17, PAGE 100;
 AND BY W.D. FROM GENEVIEVE BURNS & IRENE BURNS, SOLE HEIRS OF THE ESTATES OF THOMAS BURNS & JOHN BURNS DATED OCT. 31, 1966 AND RECORDED IN BK. 17, PAGE 164;

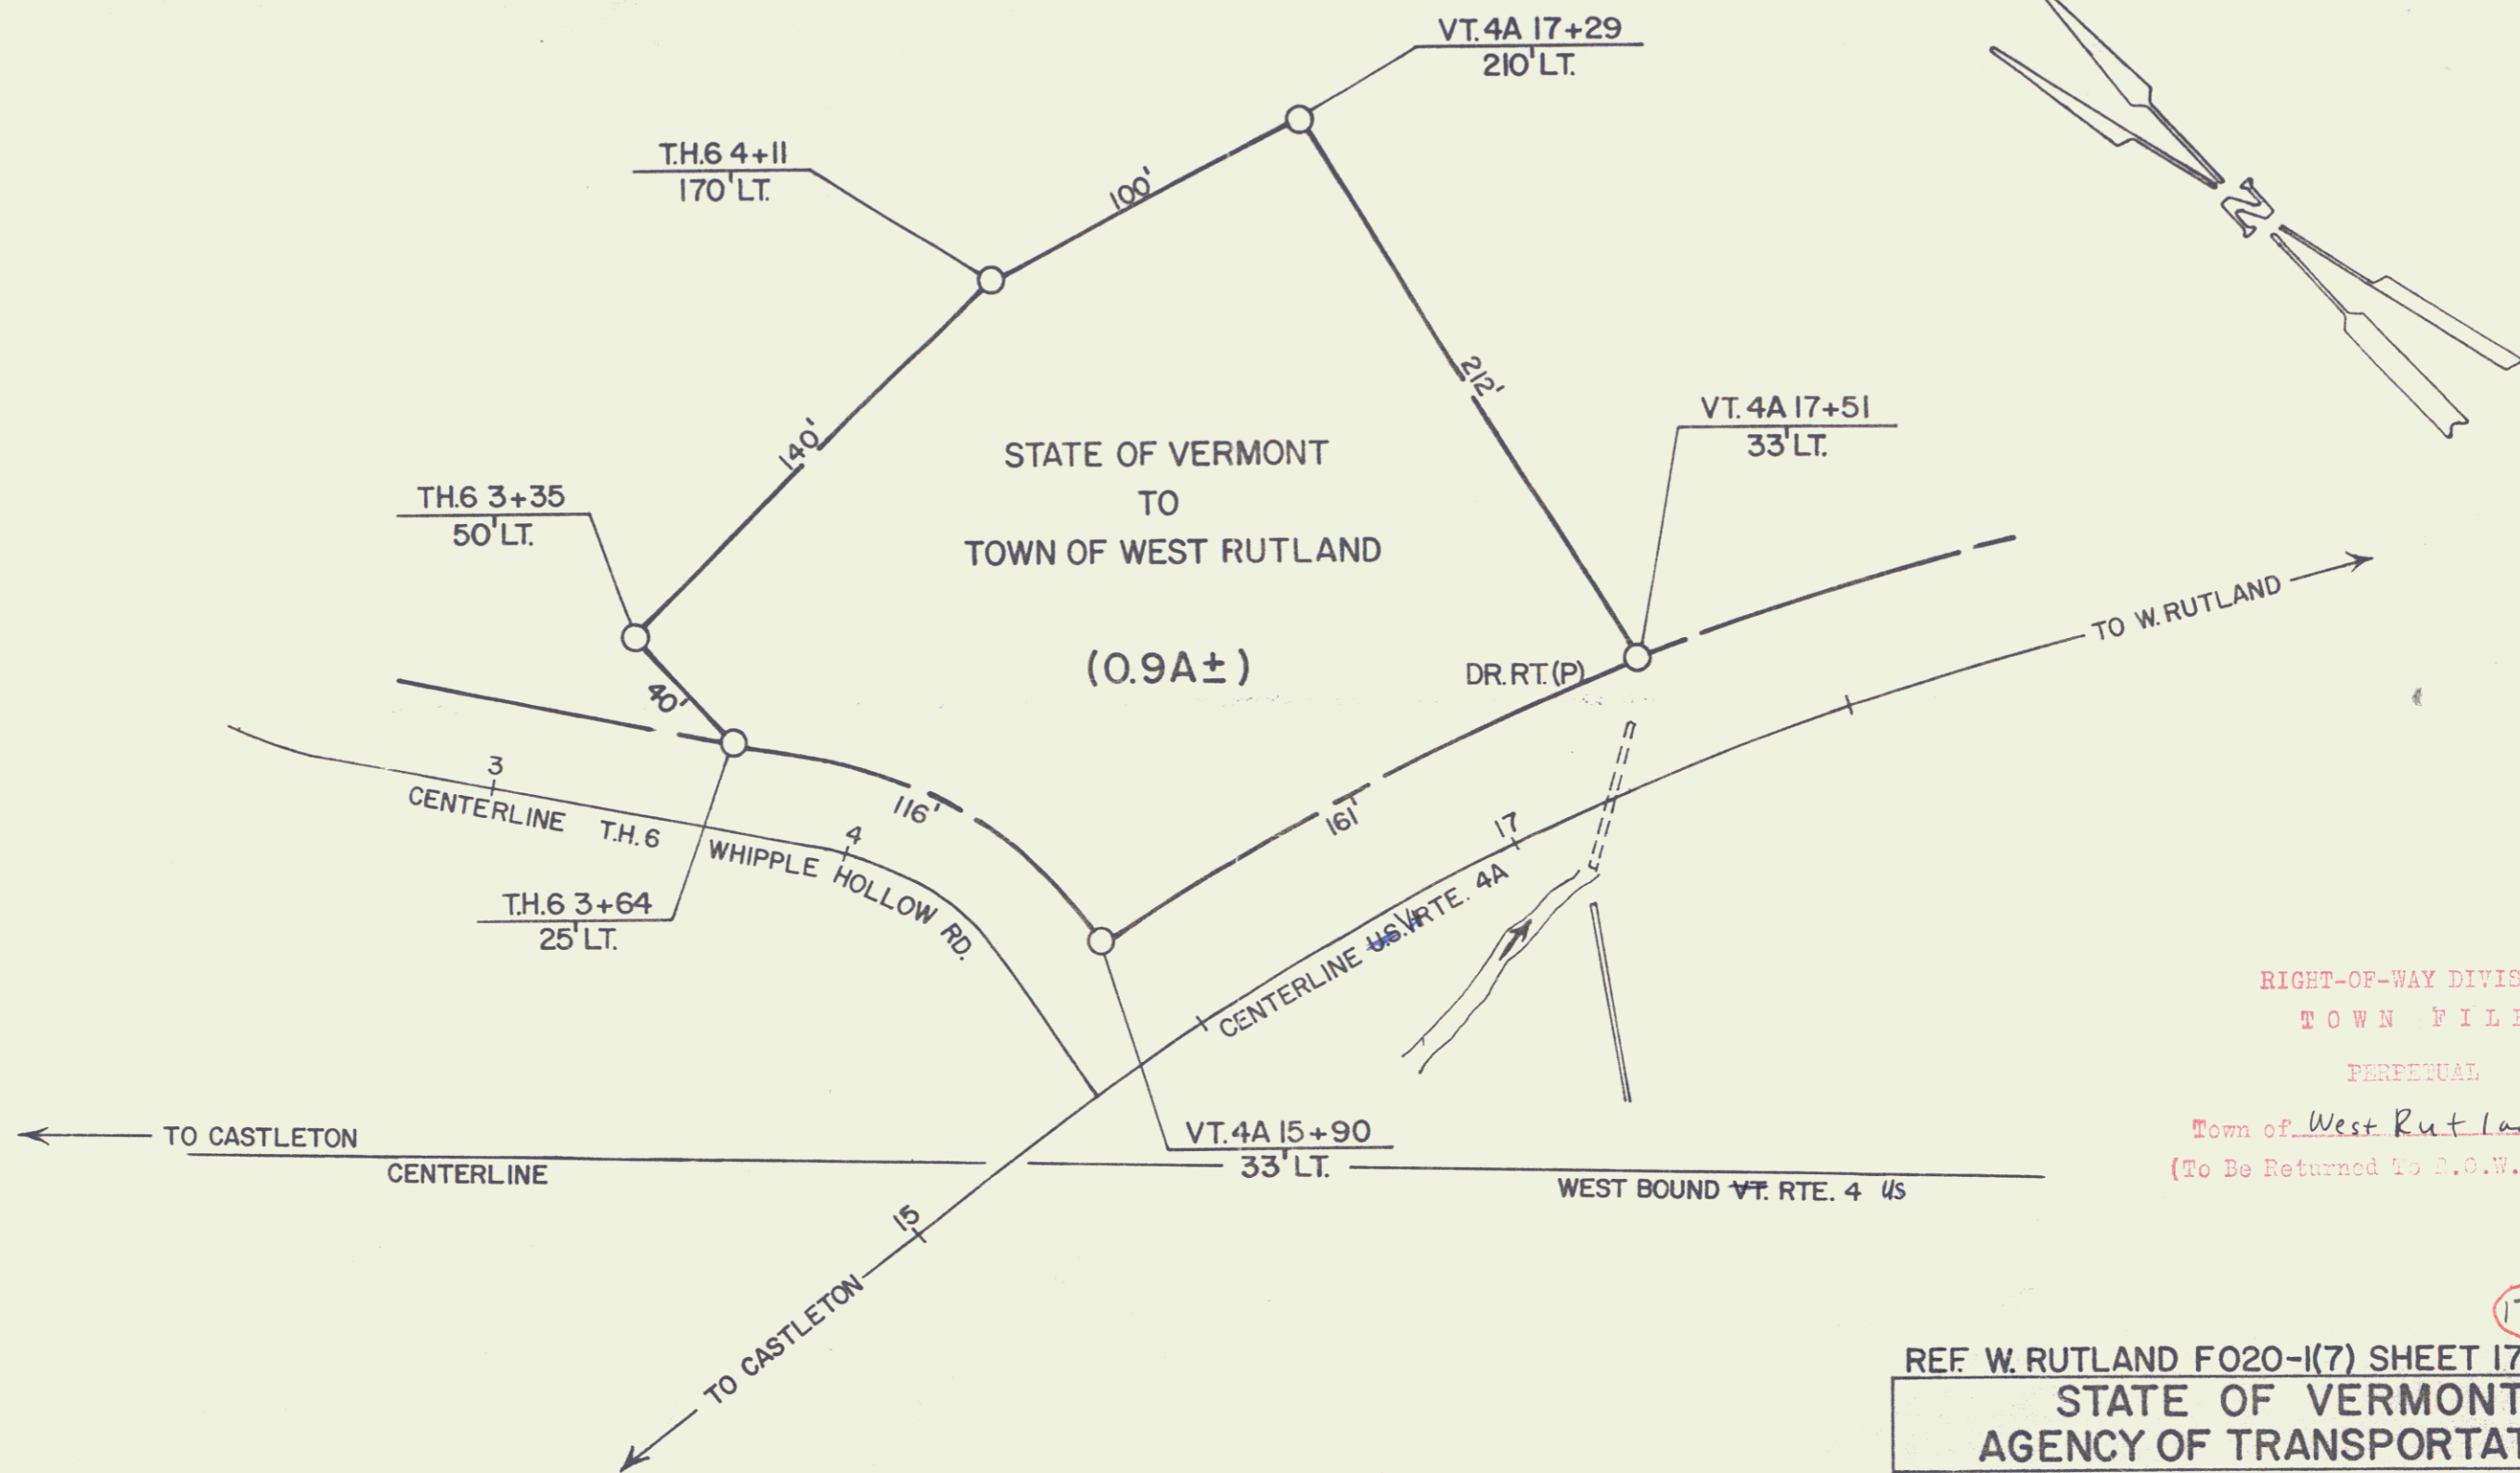

RIGHT-OF-WAY DIVISION
 TOWN FILE
 PERPETUAL
 Town of West Rutland
 (To Be Returned to R.O.W. Division)

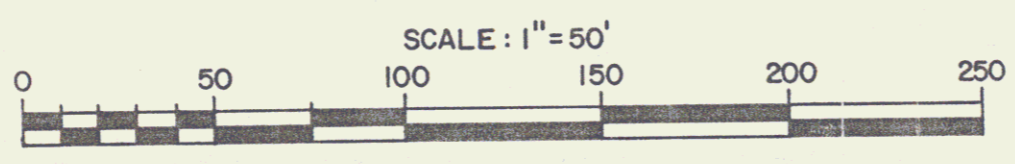

REF. W. RUTLAND F020-1(7) SHEET 17 OF 42

STATE OF VERMONT
 AGENCY OF TRANSPORTATION

TOWN OF WEST RUTLAND

APPROX. SCALE 1" = 50' | DATE 3-6-85 | DRAWN BY D.E.M.

17A

15