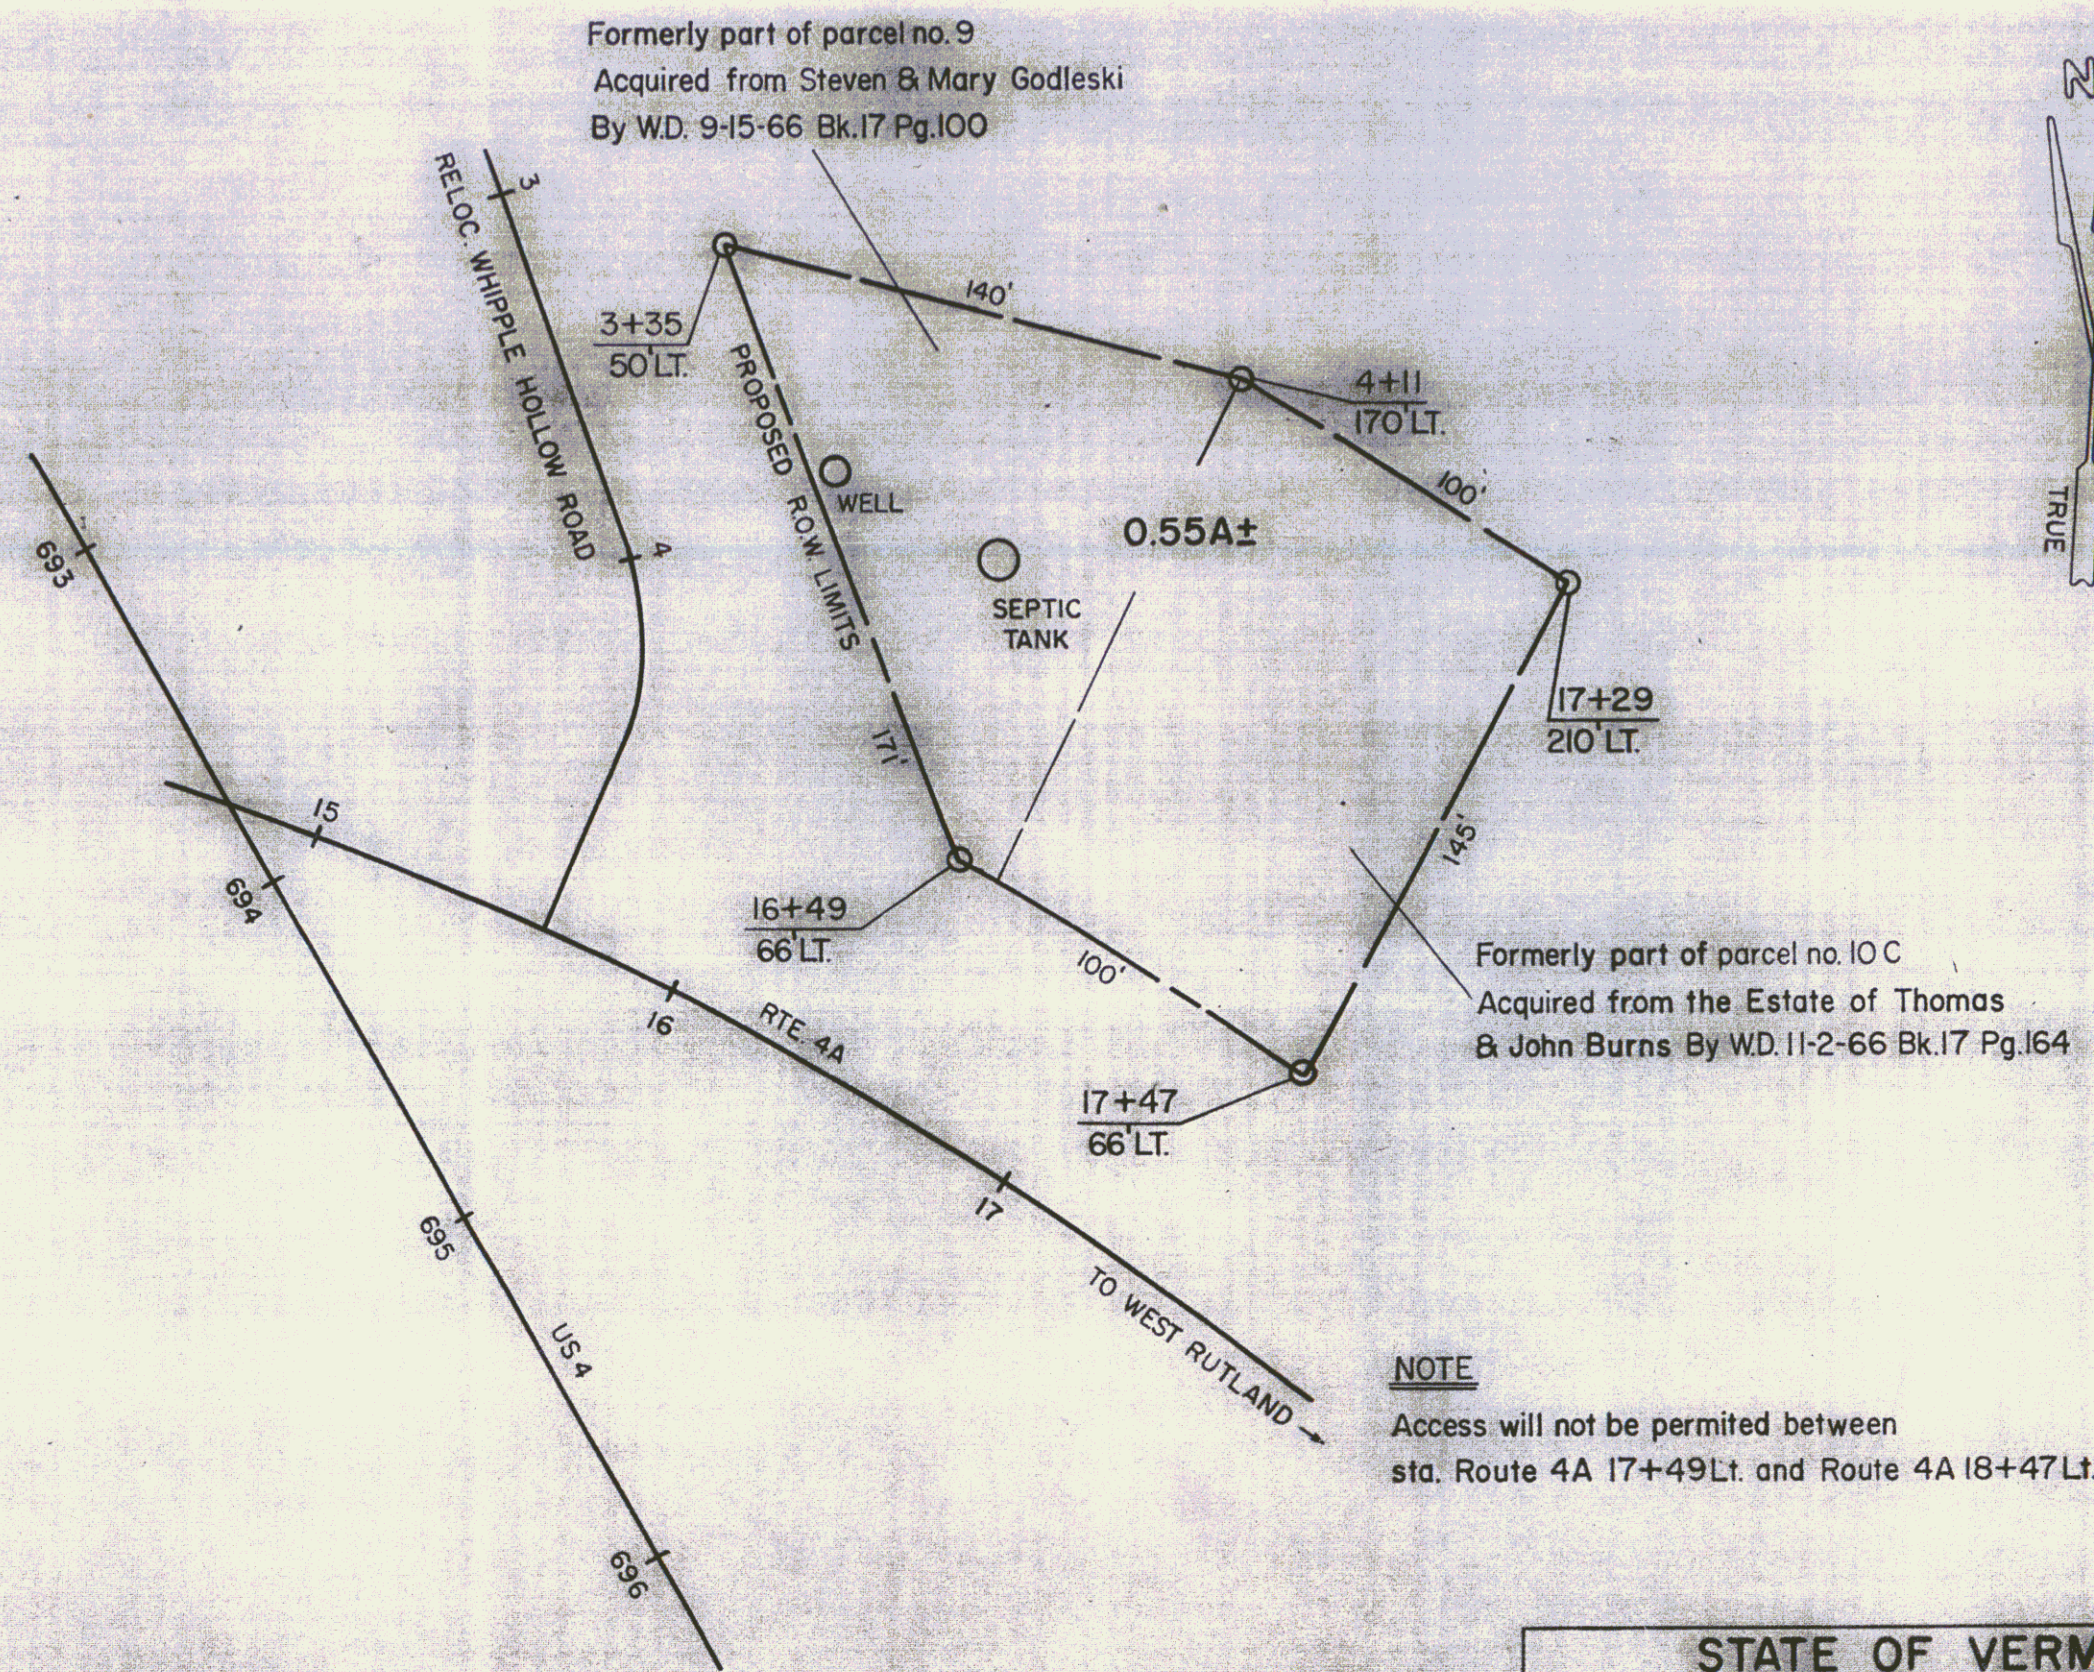


STATE OF VERMONT DEPT. OF HIGHWAYS 17B		
Town of West Rutland		
PROJECT WEST RUTLAND FO20-1(7)		
APPROX. SCALE 1"= 50'	DATE 2-3-75	DRAWN BY ROD S.
R.O.W. PROJECT NO. 57-1974 116		