


GRAVEL DUMP FILL FOR SLOPE  
STABILIZATION, ITEM 222A  
WB 62750-63100 LT.

Property Line Fence w/Steel Posts  
Mod. Item 503-Z  
Rev EB 62750-63100 LT  
WB 62750-63100 LT  
That fence listed below is to be  
installed prior to the commencement  
of other work in this area.  
W.B. 630-12-63100 LT




\* Three Cable Guard Rail w/Light Steel Posts  
Item 538  
WB 62750-63100 LT  
EB 62750-63100 LT

\* Stage 2 Construction

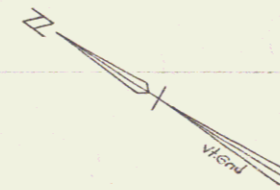

TBM 13  
UD Elev  
511.60

S 31° 21' 40" E

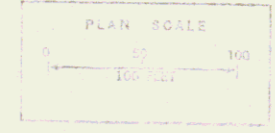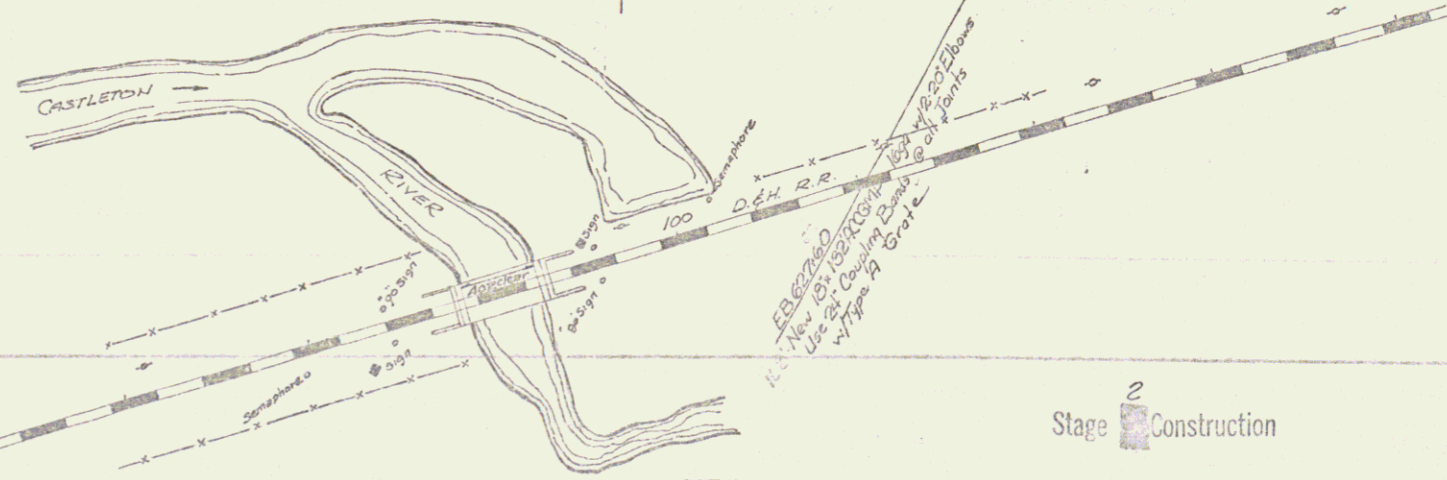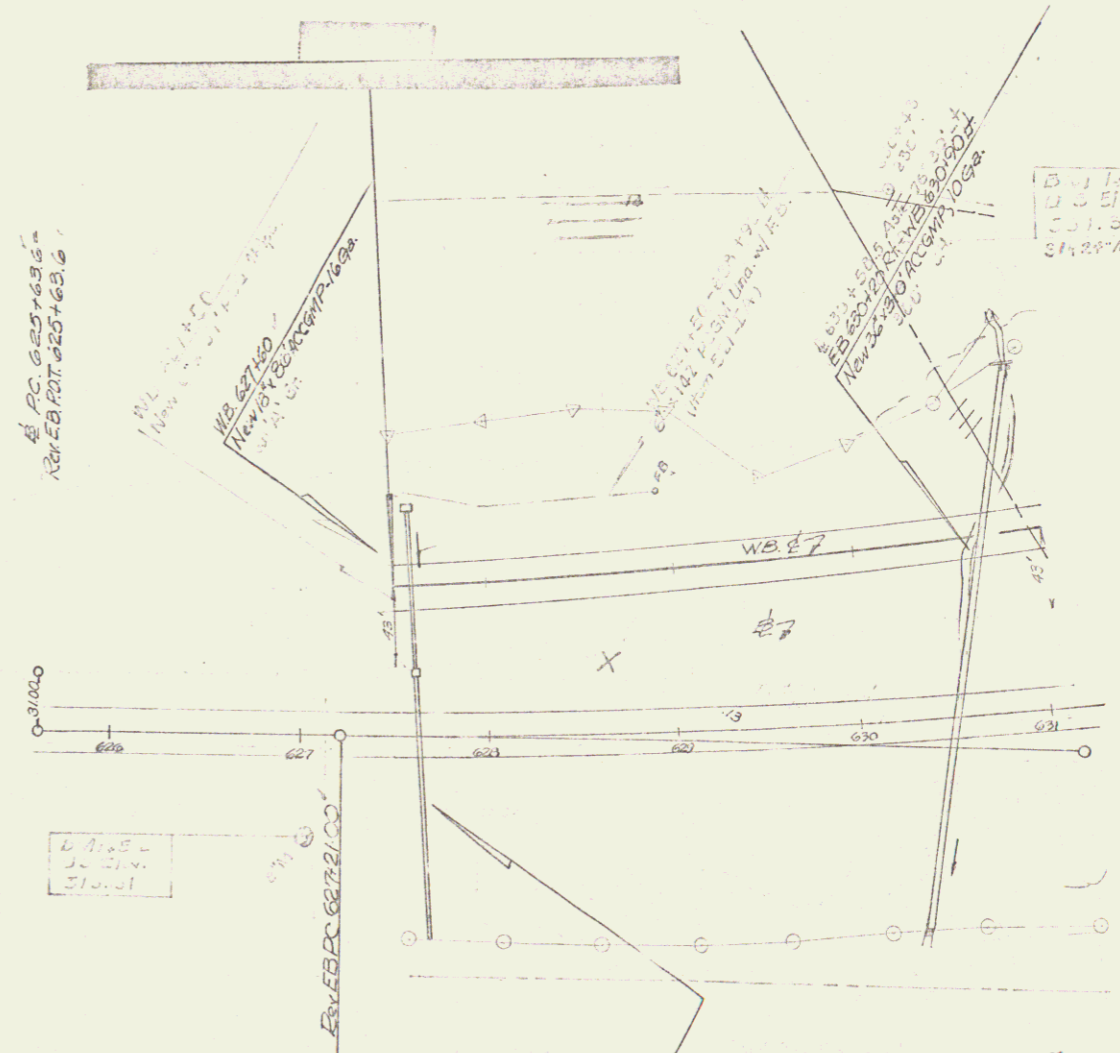

Stage 2 Construction

WEST RUTLAND  
APO20-1 (11)  
Sheet 27 of 359 Sheets

Sheet 86 of 170 Sheets