

DATE	BY
DESIGNED	W.A.L.
CHECKED	ROBERT
DATE	BY
REVISION	NO.
NO.	NO.



Strip from A.C. Survey Station
 Bank Top, 1734.52
 45 233+00 - 237+50 W.
 20 237+75 - 237+82 W.
 40 237+80 - 242+50 W.

Property Line Fence w/ Steel Posts
 Mod. Item 533-II
 W.B. 631+00-647+00 Lt.
 P.C. 631+00-647+00 Rt.
 That fence listed below is to be installed prior to the commencement of other work in this area.
 W.B. 631+00-647+00 Lt.

*Three Cable Guard Rail w/
 Light Steel Post Item 538
 W.B. 631+00-647+00 Rt.
 EB 631+00-647+00 Rt.
 *Stage 2 Construction

Curve Data
 Δ 35°00'00" Lt.
 D 1°45'
 R 3274.0
 T 1032.3
 L 2000.0
 E 158.9
 Bank 1/2" per Ft.

Rev. E.B.
 Curve Data
 Δ 36°18'17" Lt.
 D 1°45'
 R 3274.05
 T 1073.44
 L 2074.56
 E 171.48
 Bank 1/2" per Ft.

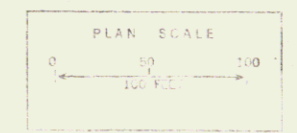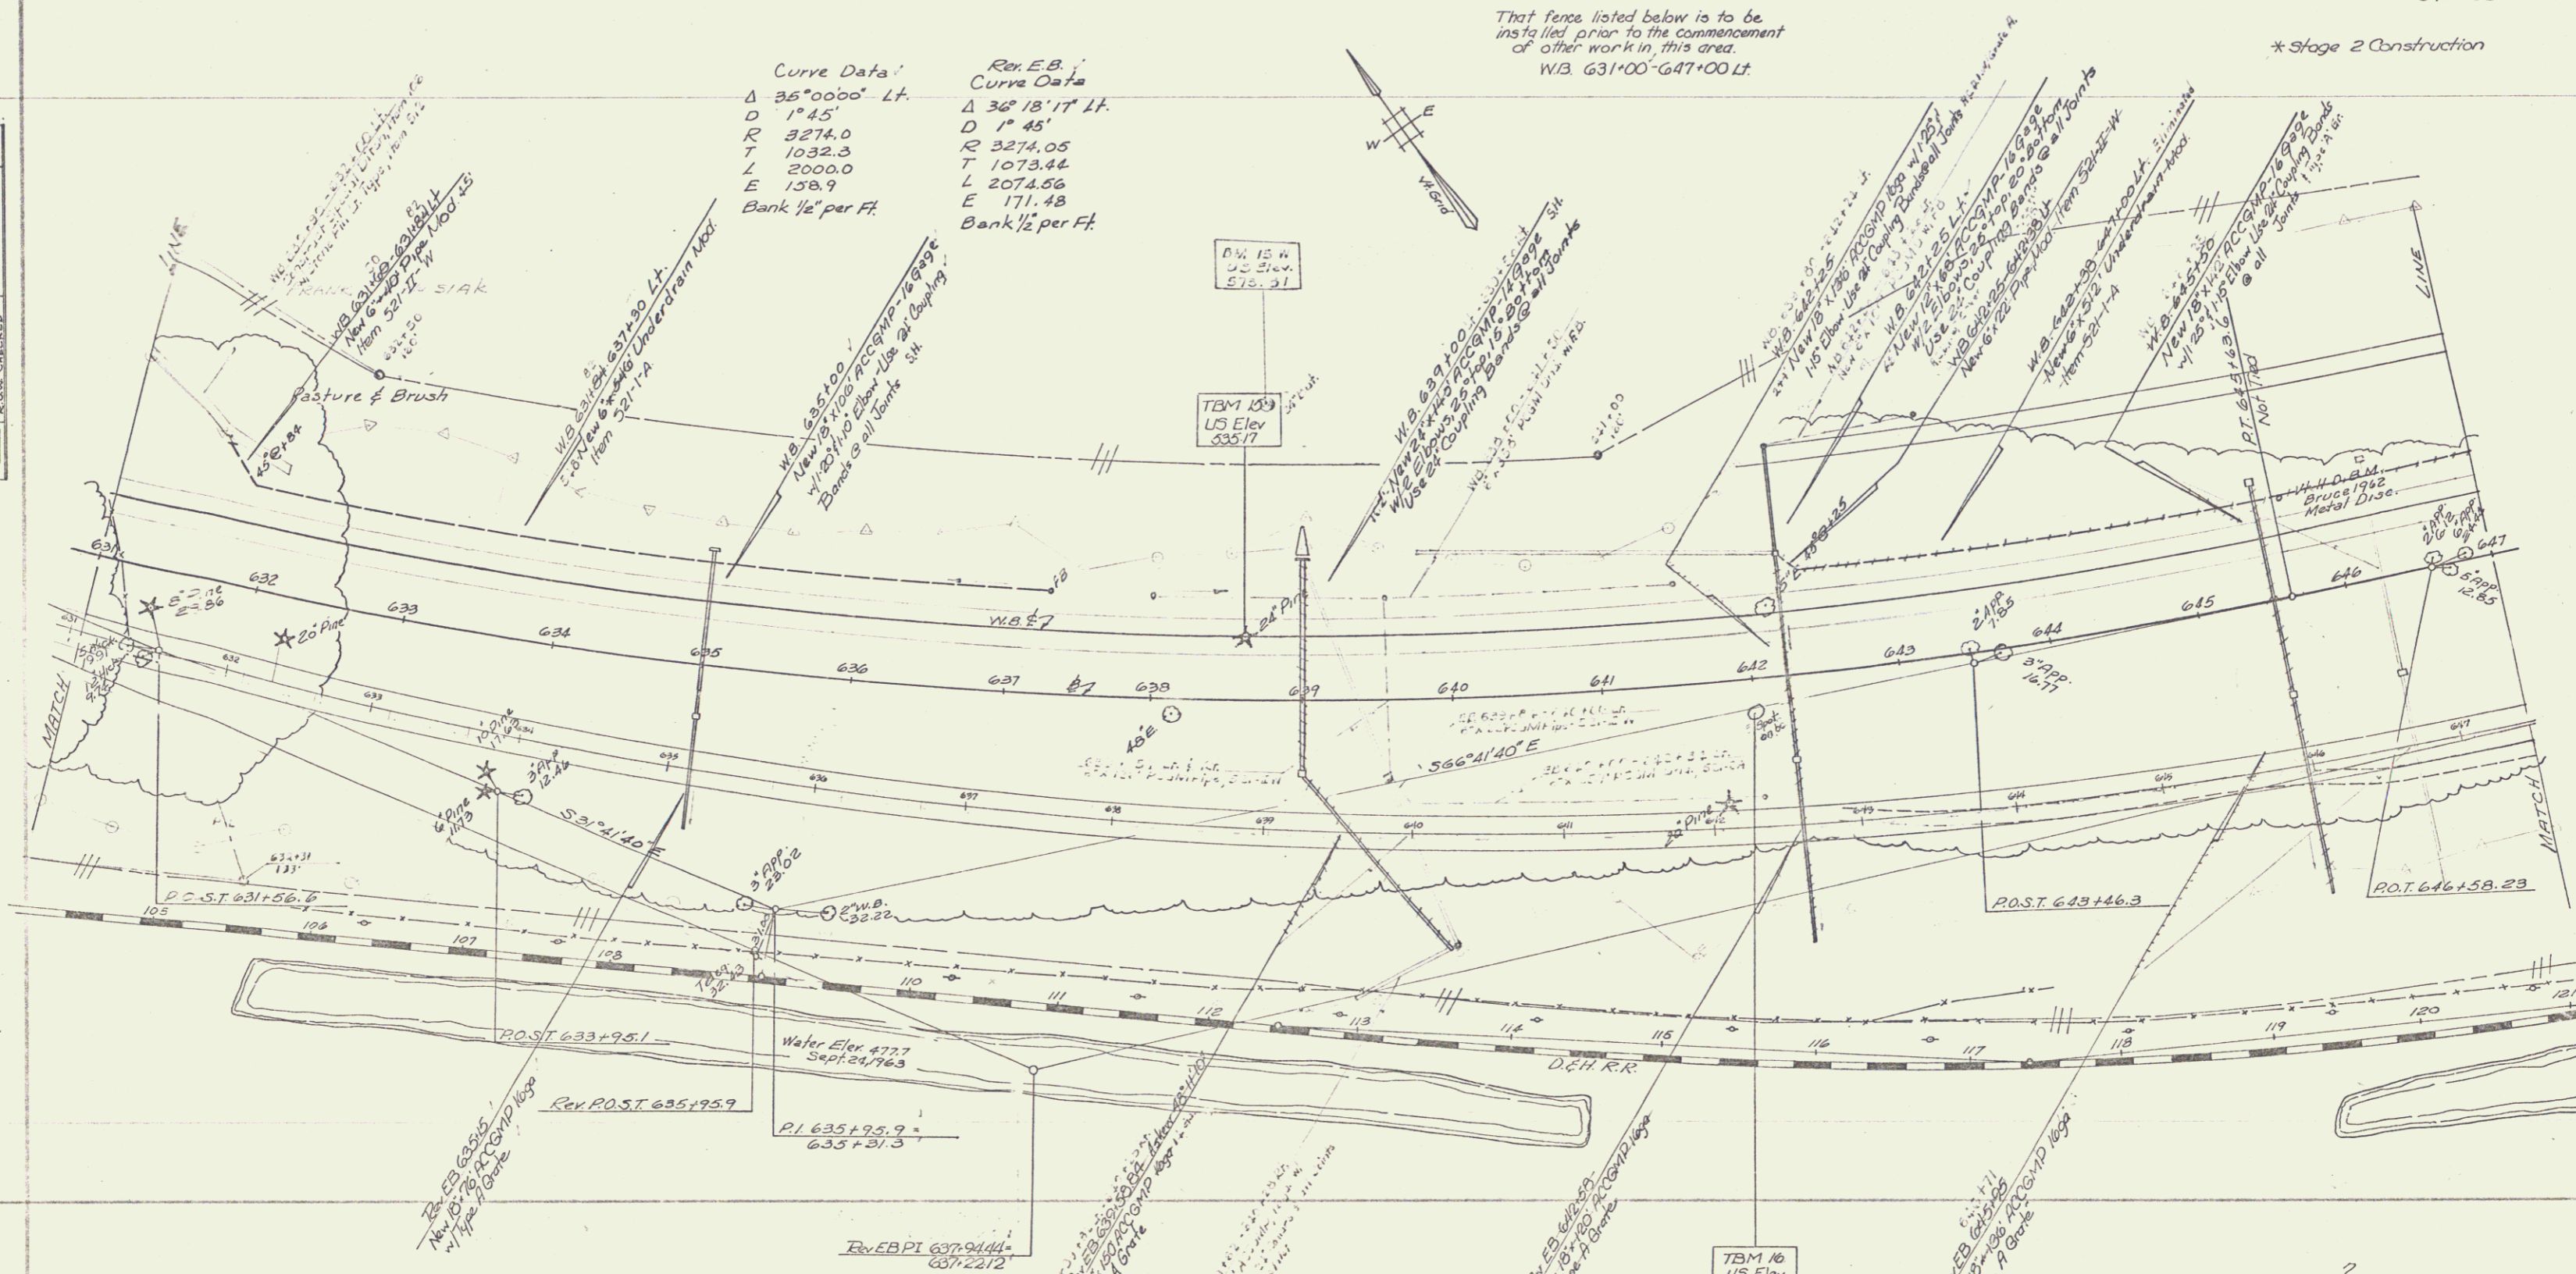

Stage 2 Construction
 WEST RUTLAND
 APO20-1 (11)
 Sheet 29 of 359 Sheets
 Sheet 88 of 170 Sheets