
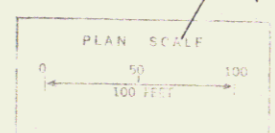


PLAN	APPROVED	DATE
DESIGNED	BY	
CHECKED	BY	
DATE		

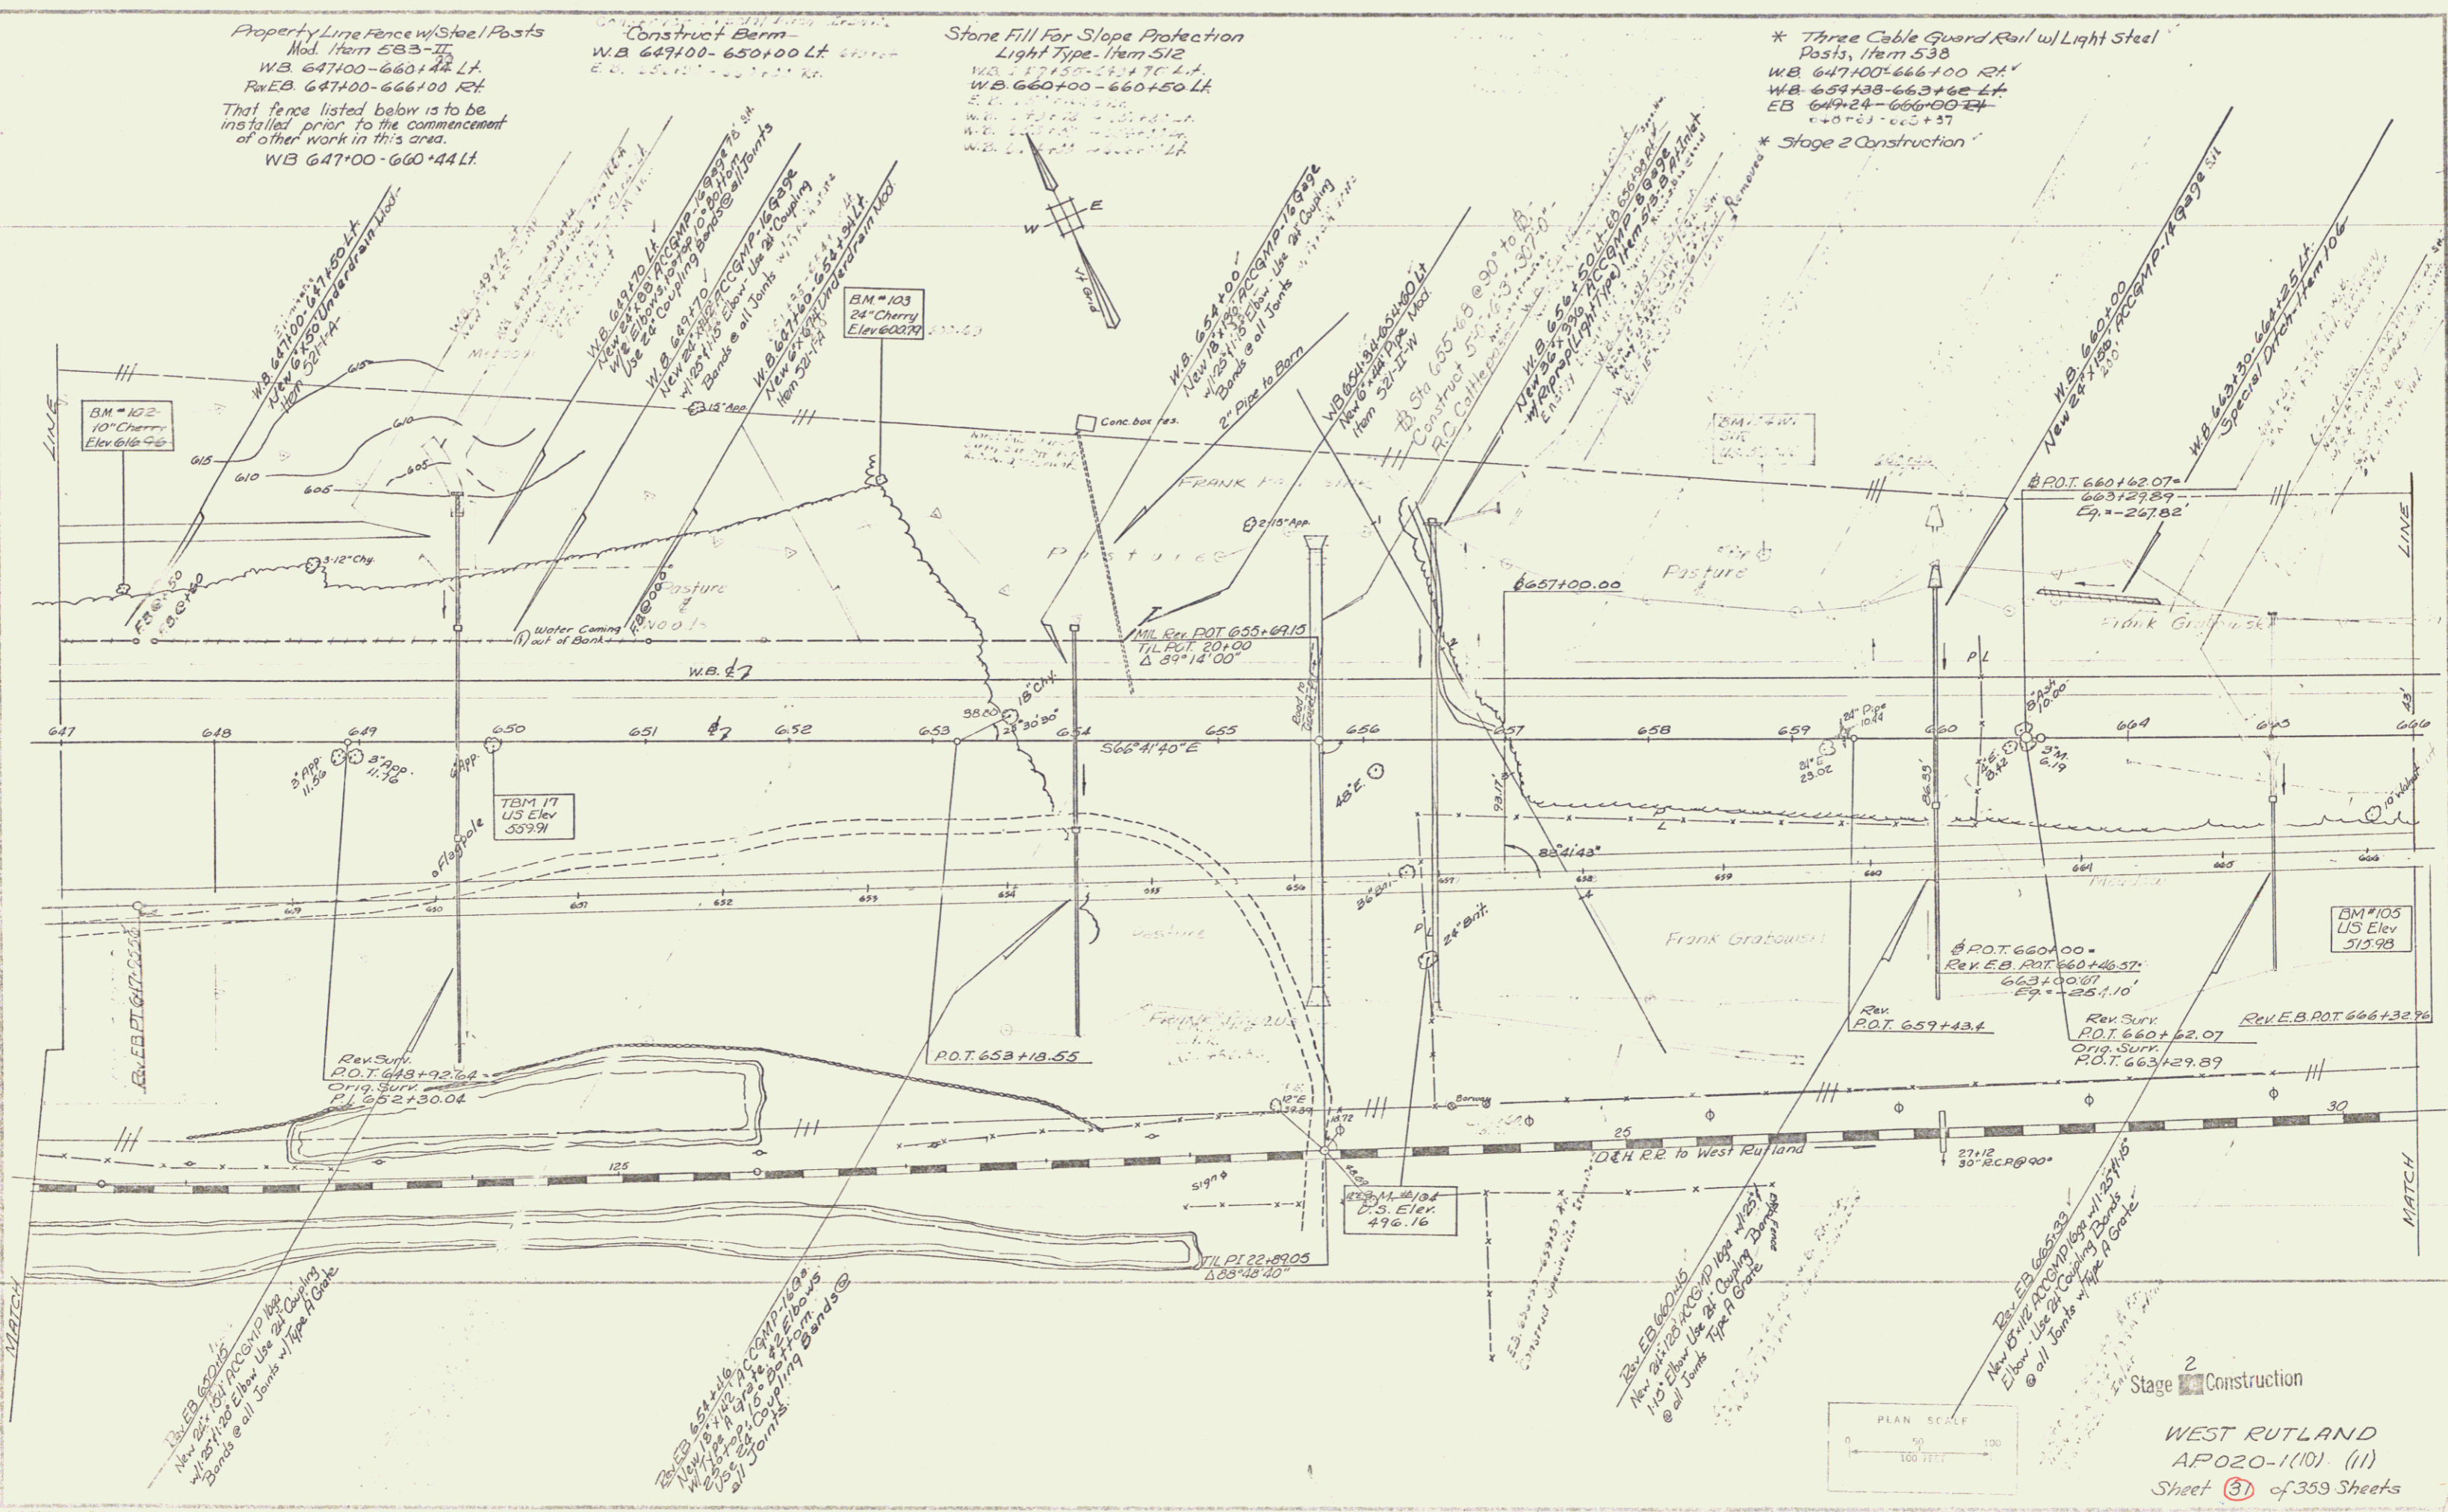

2
Stage Construction

WEST RUTLAND
A020-1(10) (11)
Sheet 31 of 359 Sheets
Sheet 90 of 170 Sheets