


DRILLING & BLAST NR OF SOLID ROCK
SUB GRADE ITEM 113
EB 672 - 676 - 681
WB 679 - 682

PROPERTY LINE FENCE W/
STEEL POSTS MOD. ITEM 583-II
Rev EB 666+00 - 682+00 Rt
WB 682+00 - 682+00 Lt

STONE CURB FOR SOFT PROTECTION,
LIGHT TYPE, ITEM 512
WB 673+40 - 681+33 Lt
DRILLING & BLASTING OF SOLID ROCK
ITEM 114
EB 677+25 - 678+50 Rt
WB 673+00 - 680+33 Lt

TREATED TIMBER CURB, ITEM 550
*BHT CONC. CURB
ITEM 555
EB 677+15 - 682+00 Rt
54

*THREE CABLE GUARD RAIL w/ Light Steel Posts
ITEM 538
WB 666+00 - 681+88 Rt
EB 666+00 - 682+00 Lt
6.1+05
* Stage 2 Construction

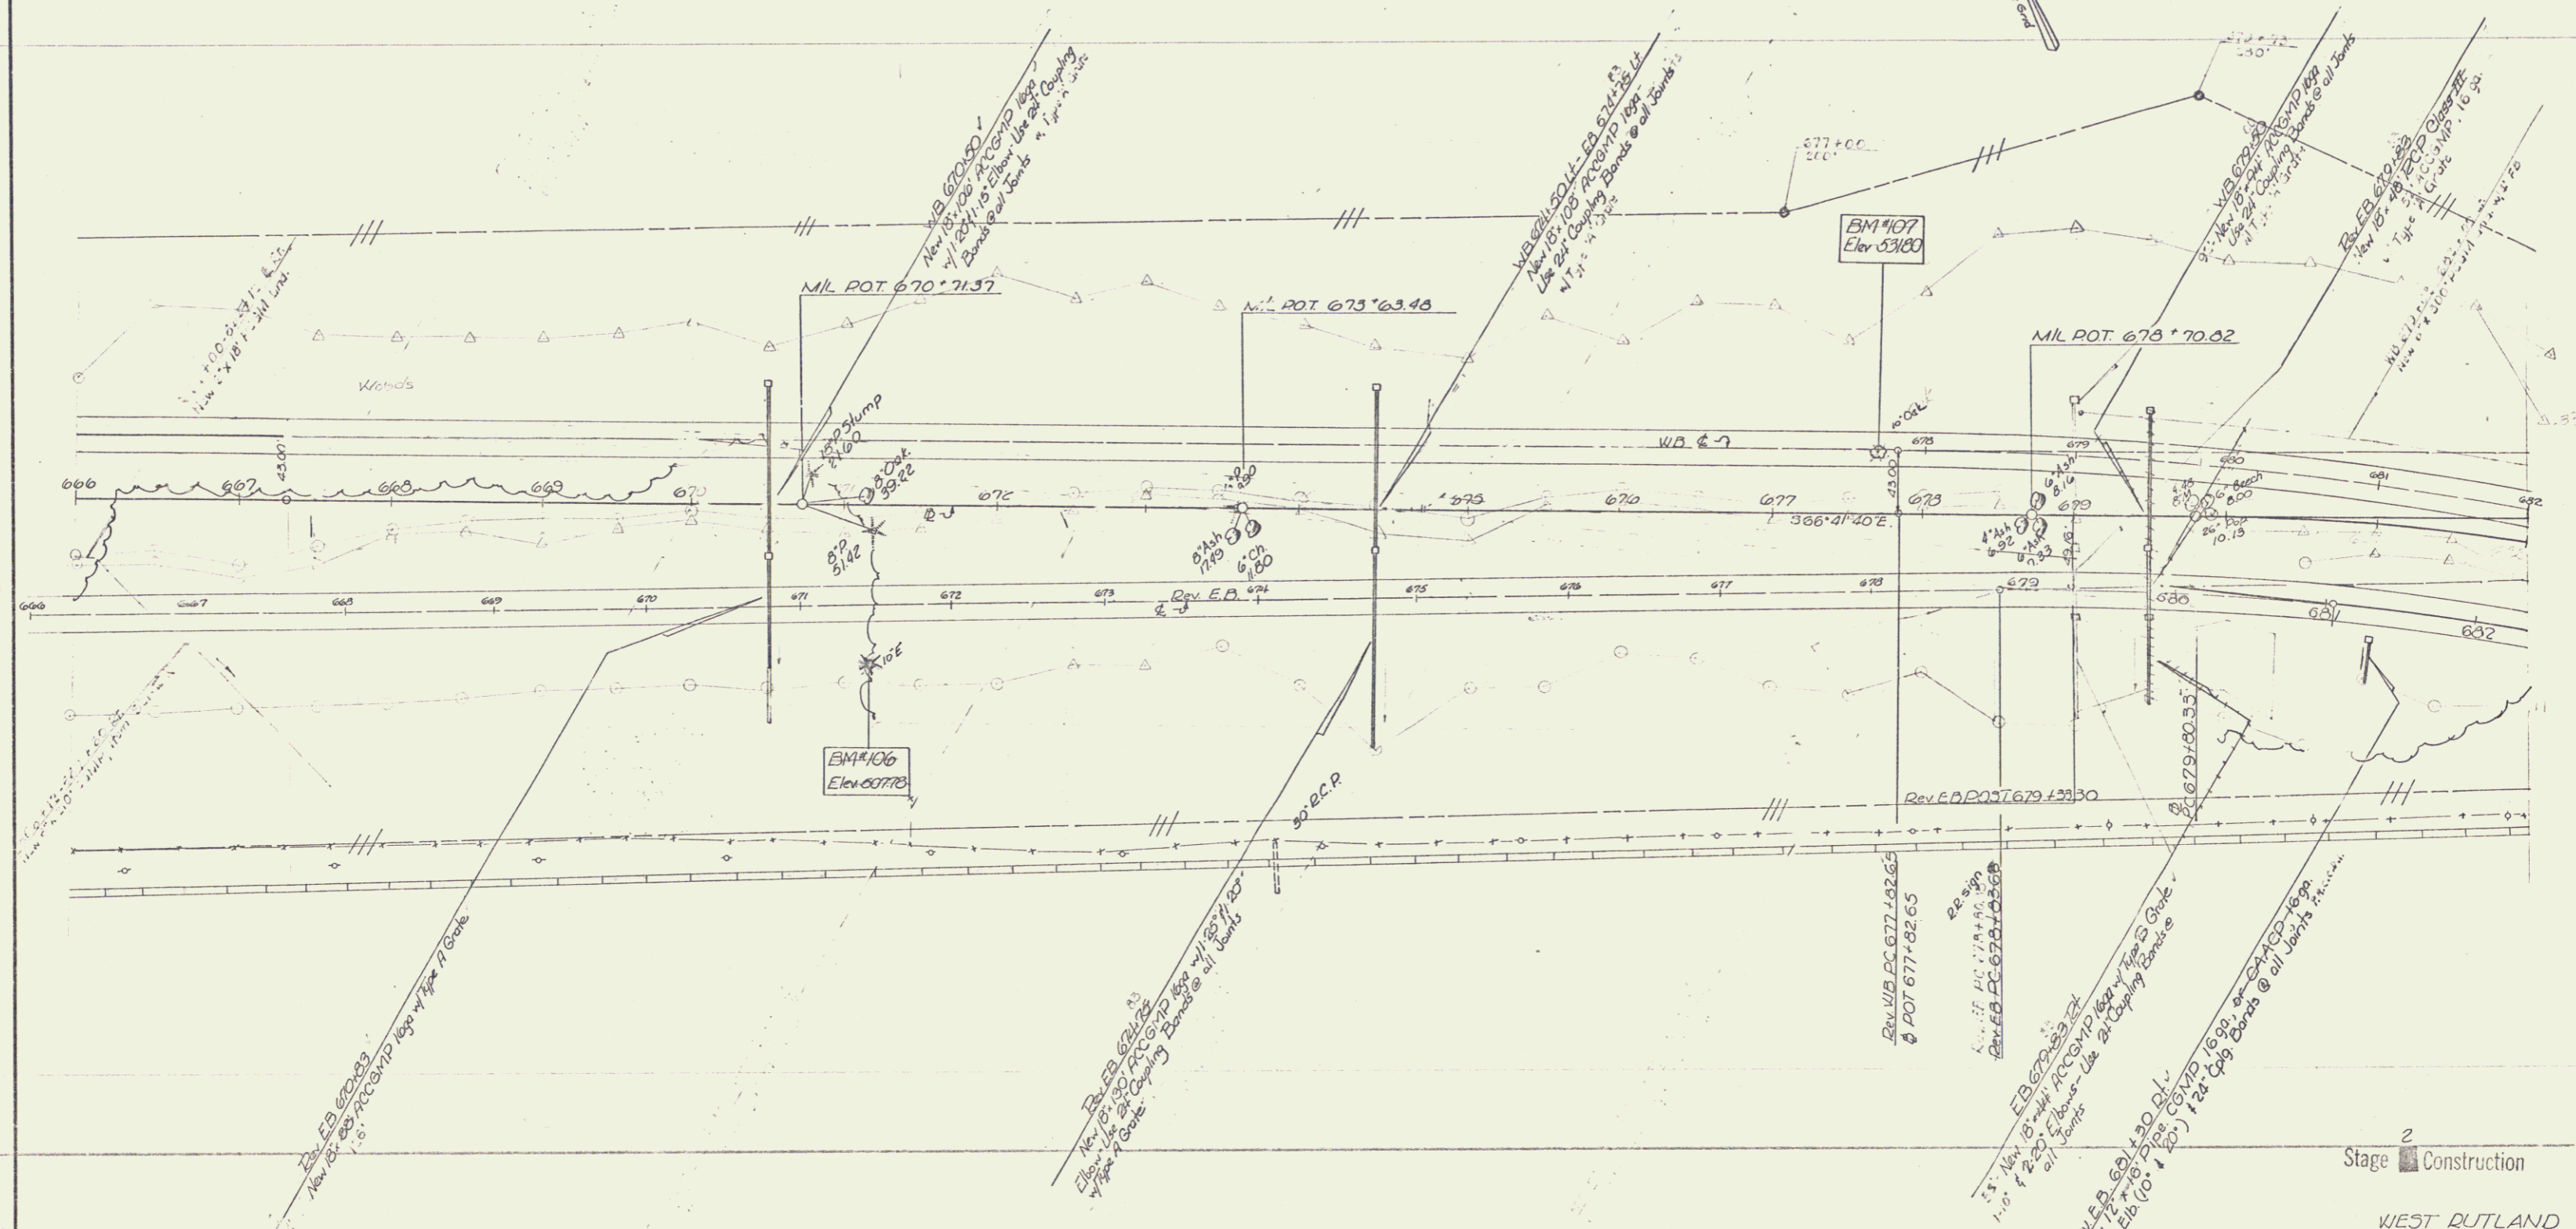

Stage 2 Construction

WEST RUTLAND
SURVEYED BY _____ DATE _____
DRAWN BY _____ DATE _____
TRACED BY L. Clark DATE 4/8/07
PROJ. AP NO. 020-1(11)
SHEET (33) OF 359
Sheet 92 of 170 Sheets

