
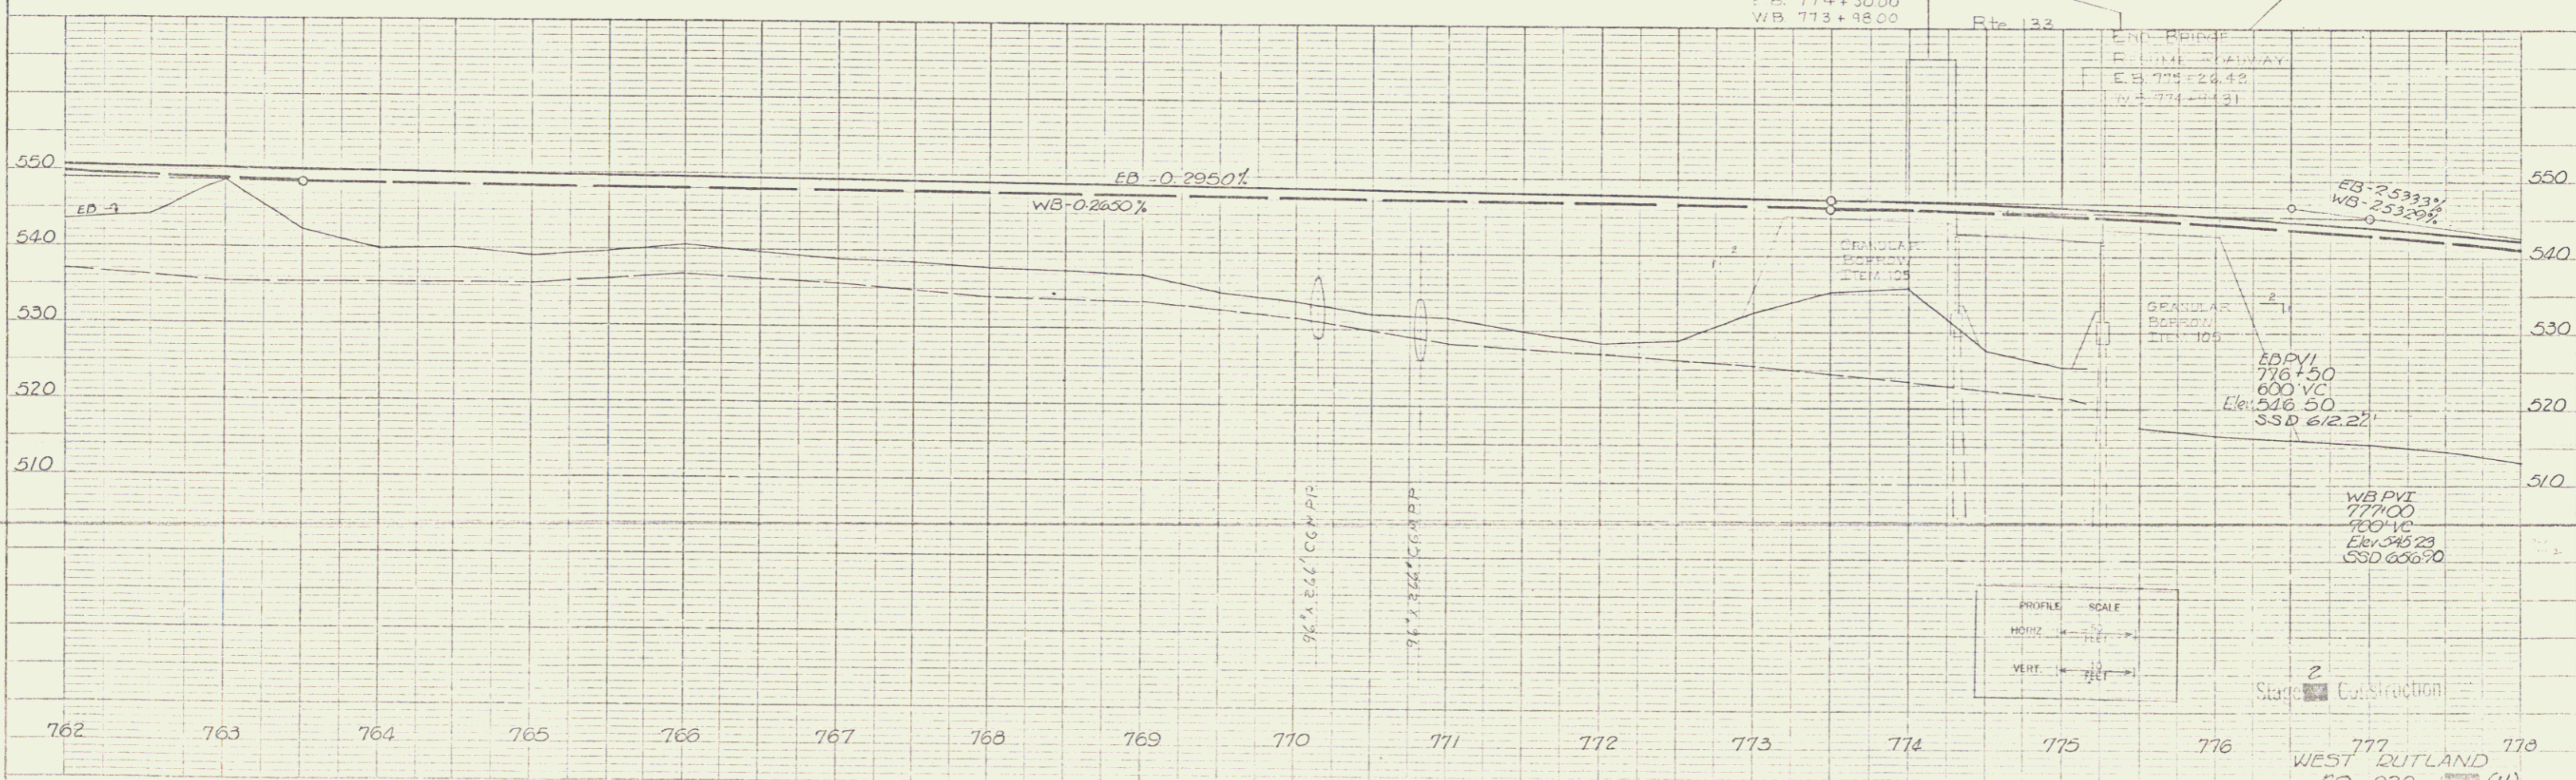


PLAN
 DATE: 10/1/64
 PROJECT: WEST RUTLAND
 SHEET: 105 OF 170

PROFILE
 DATE: 10/1/64
 PROJECT: WEST RUTLAND
 SHEET: 105 OF 170

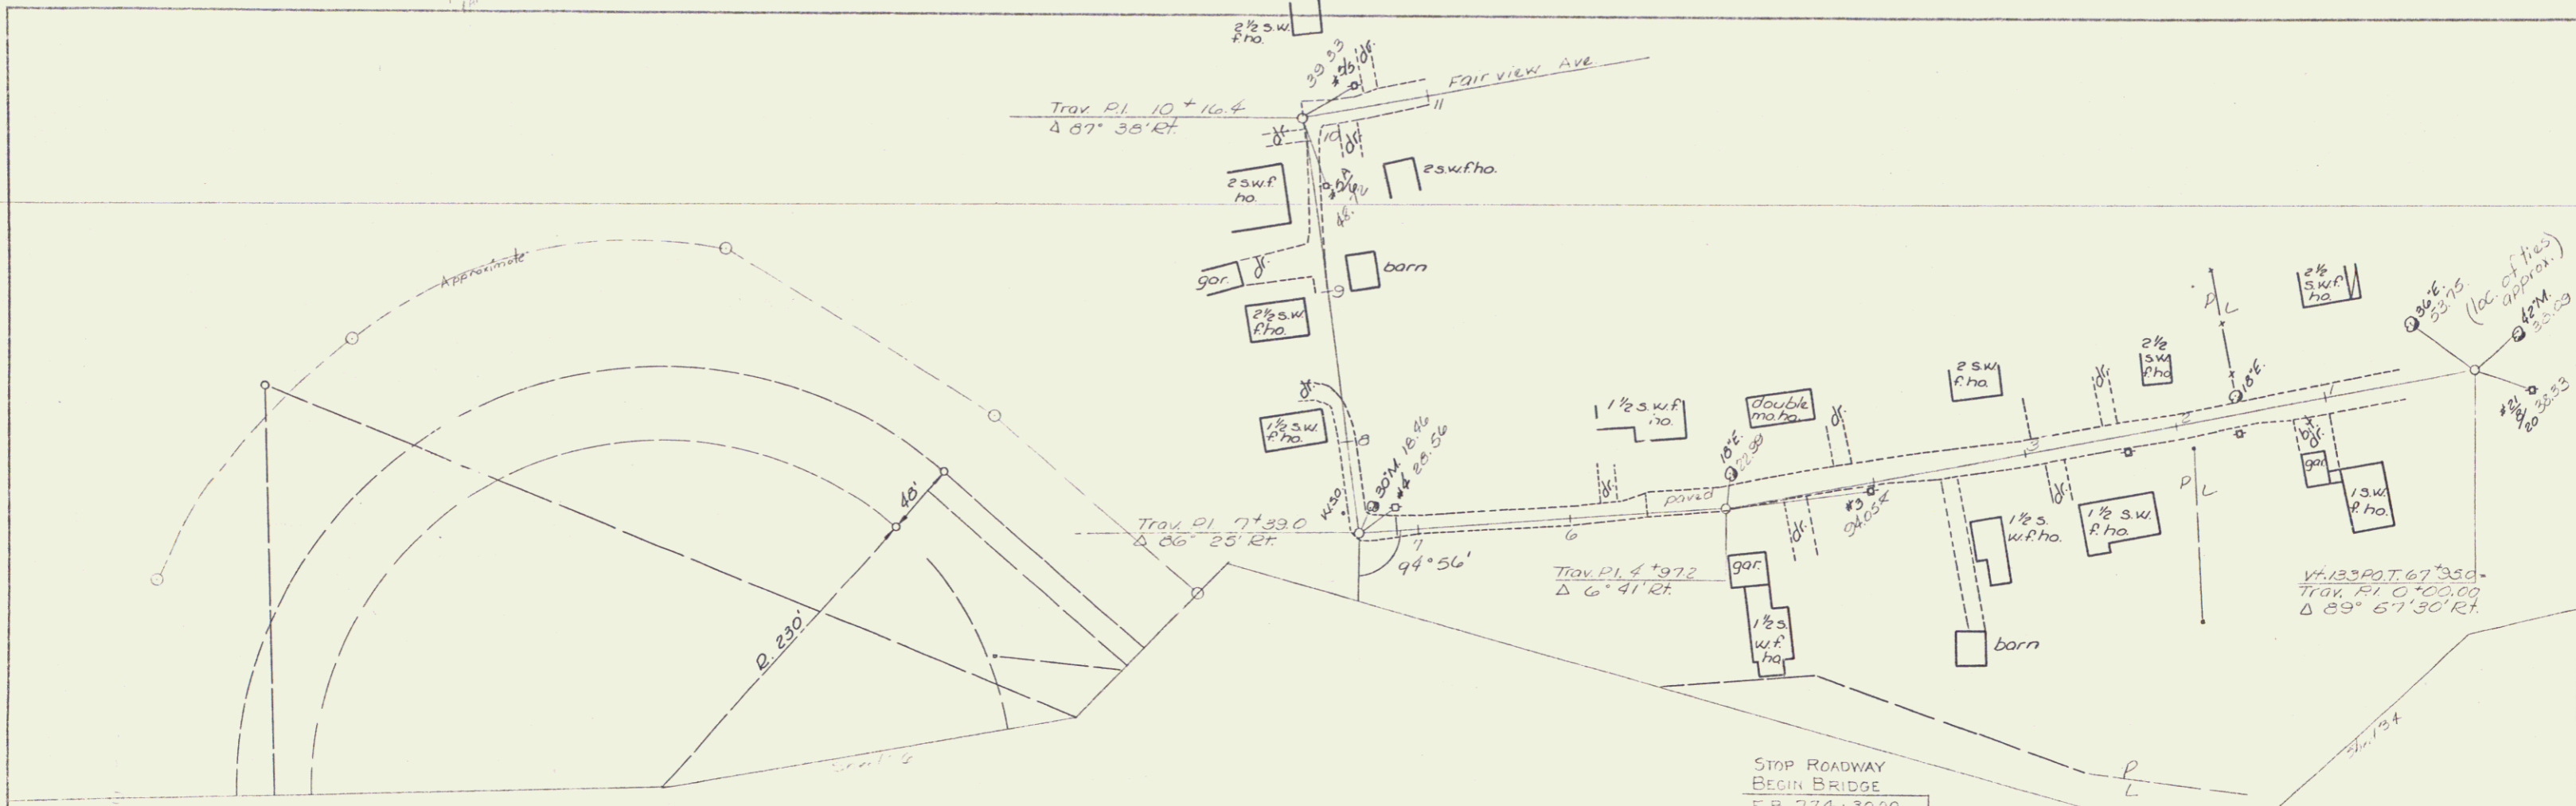

PROFILE SCALE
 HORIZ. 1" = 40'
 VERT. 1" = 10'

Stage 2 Construction
 WEST RUTLAND
 RP 020-105 (11)
 Sheet 105 of 170