



MUCK EXCAVATION ITEM 117
EB 78+00-802+00

GRANITE SLOPE EDGING ITEM 336-A*
791+00-802+00 L/R Med


PROPERTY LINE FENCE W/ STEEL
POSTS MOD. ITEM 583-II
EB 791+00-802+00 R;
WB 791+00-802+00 L.

SPECIAL DITCH, ITEM 103
796+00-800+00 N<

* STAGE 2 CONSTRUCTION

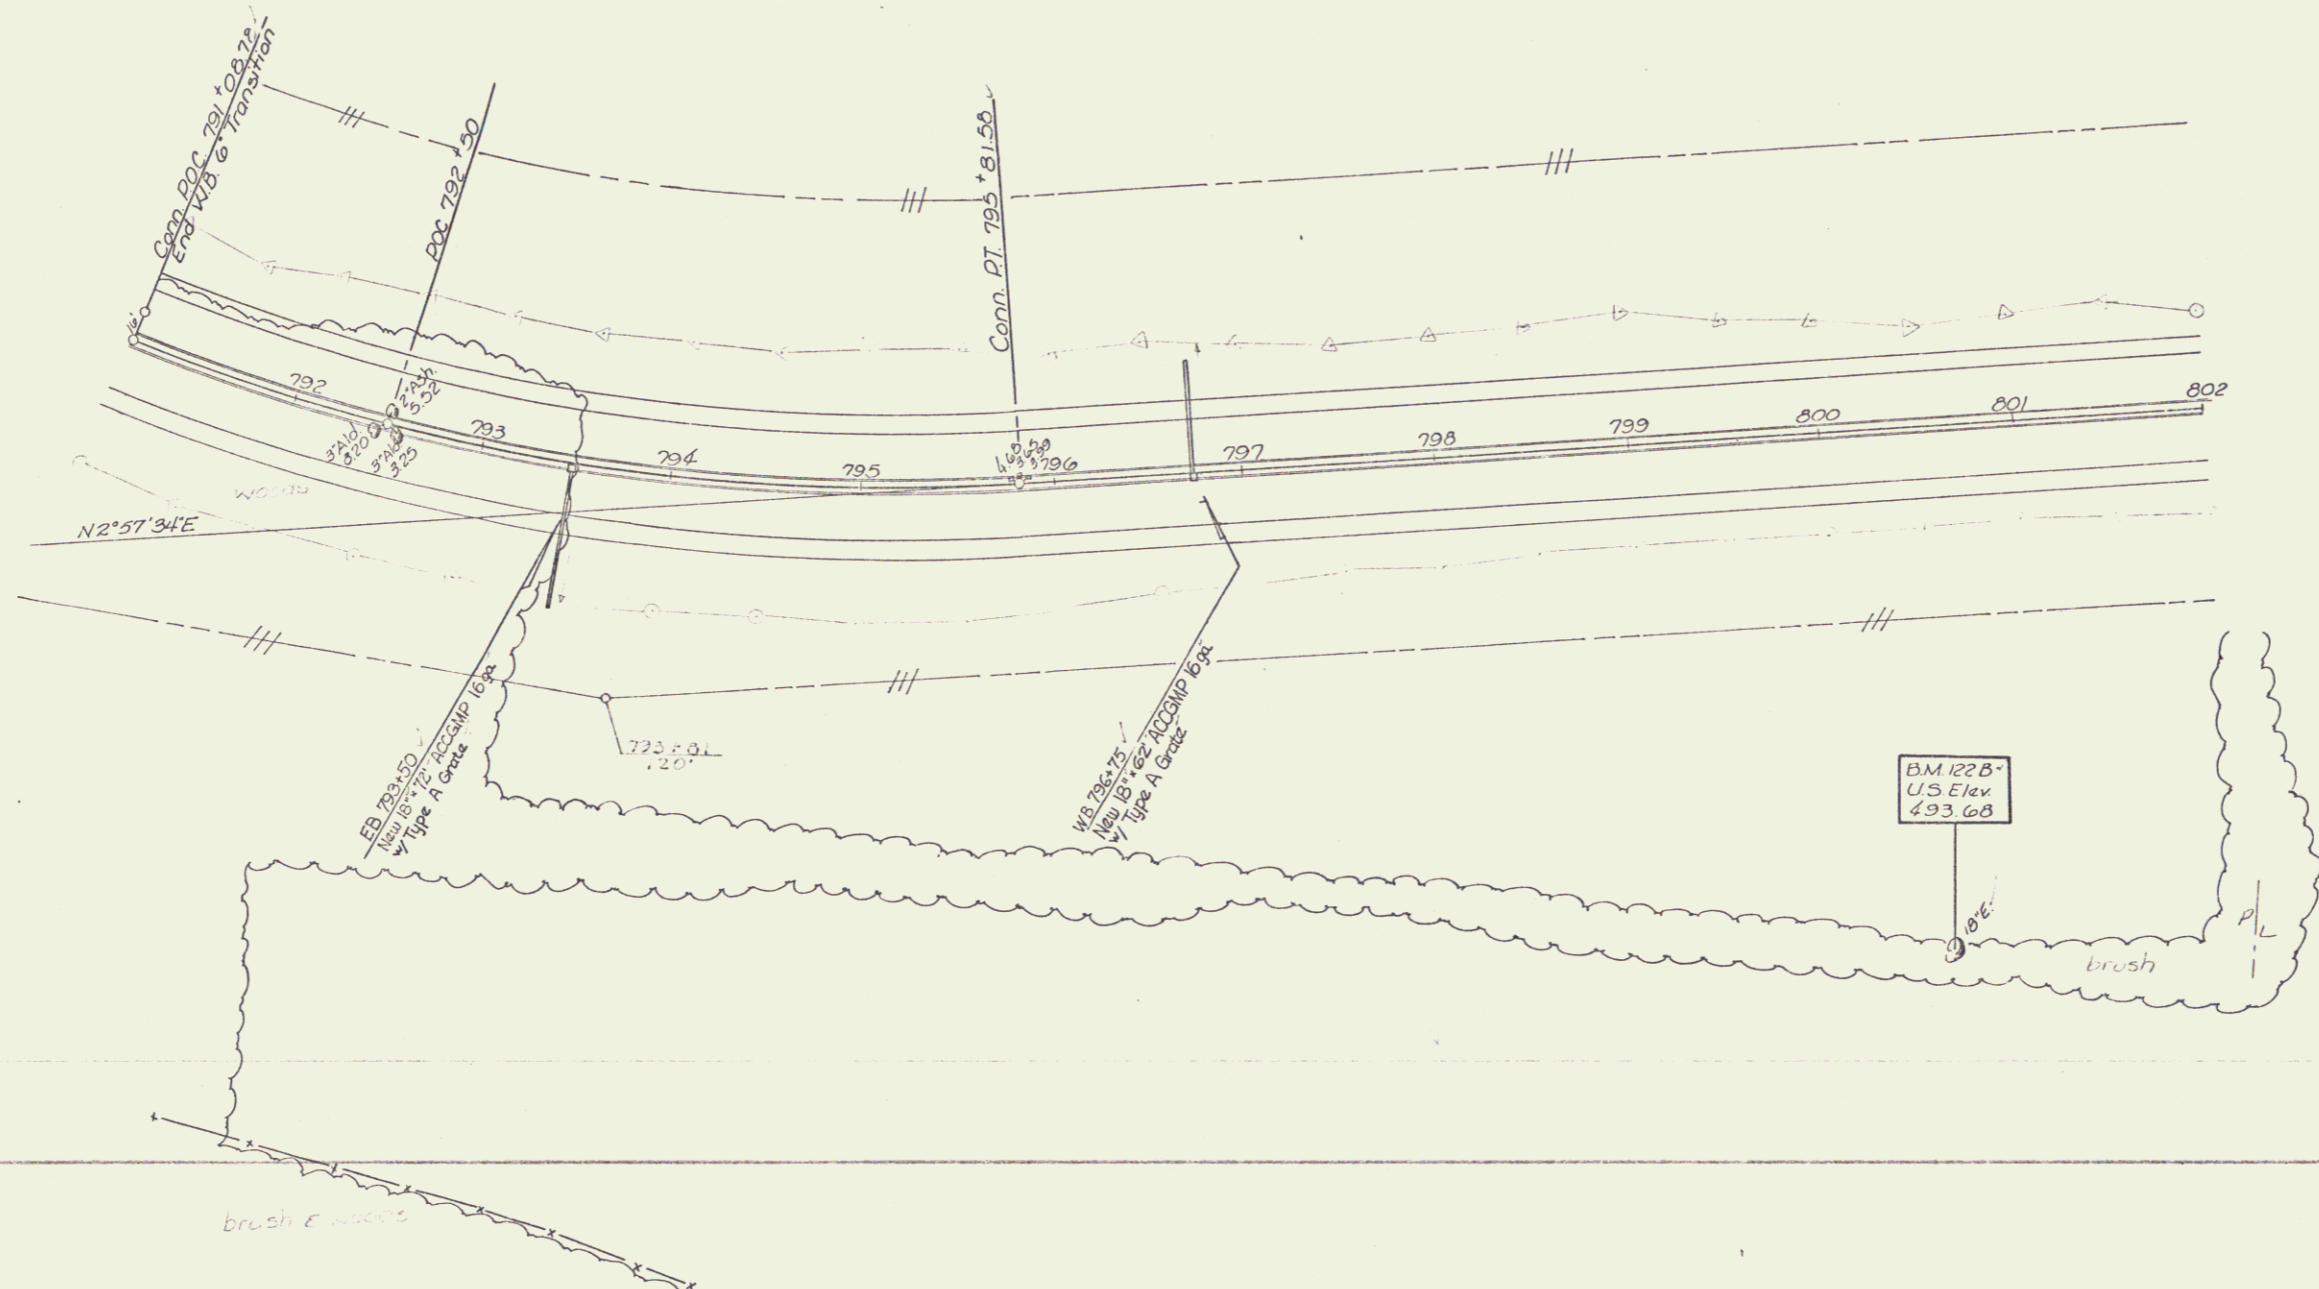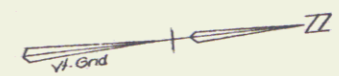

Stage 2 Construction

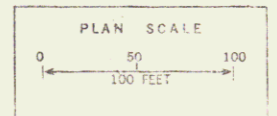

SURVEYED BY Barnes DATE 5/65
DRAWN BY Evans DATE 5/65
TRACED BY A. Clark DATE 6/65
WEST RUTLAND
PROJ. AP NO. 020-1 (11)
SHEET 48 of 353

See 107 of 170 Sheets

40